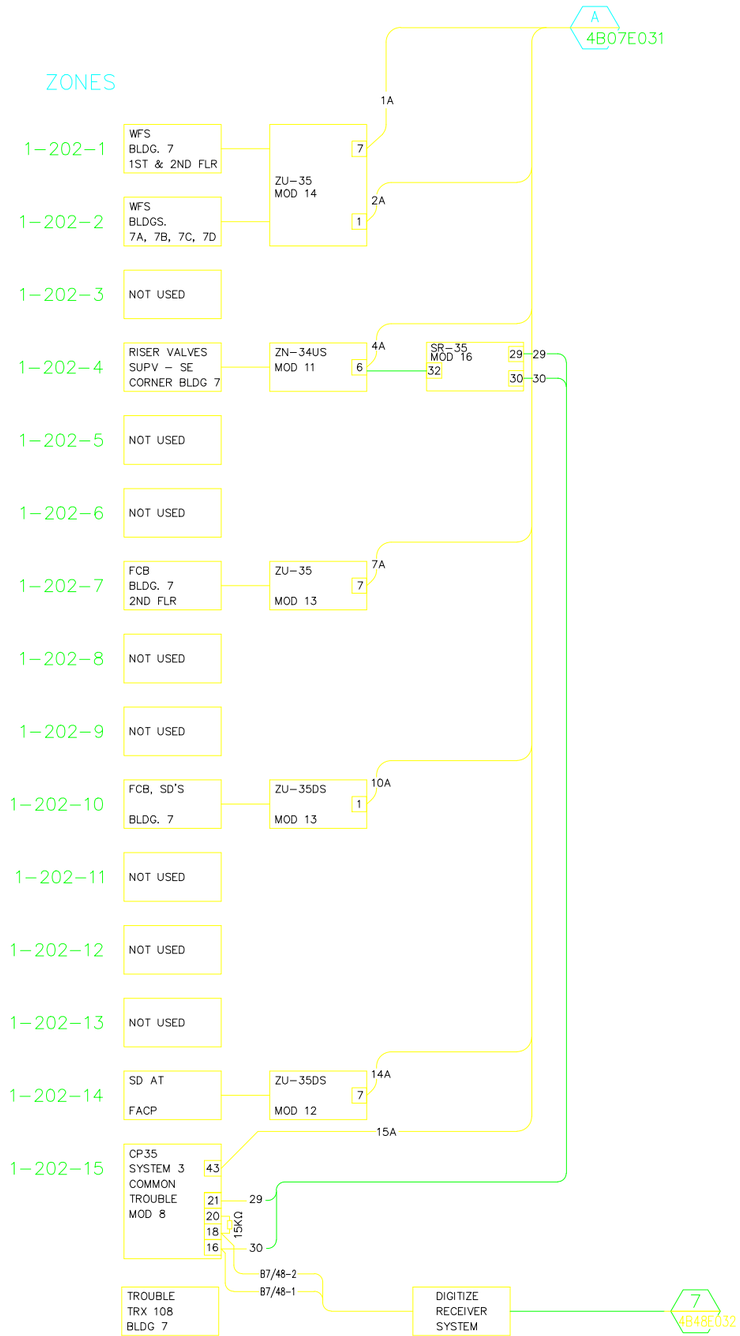


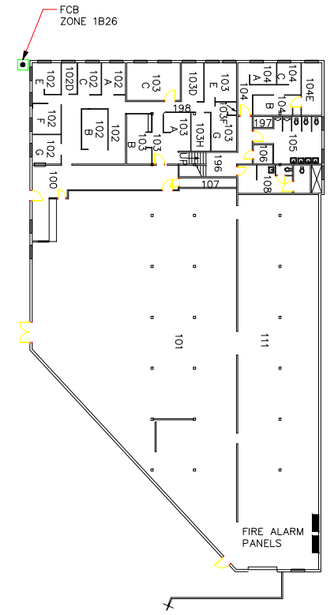


FIRST FLOOR

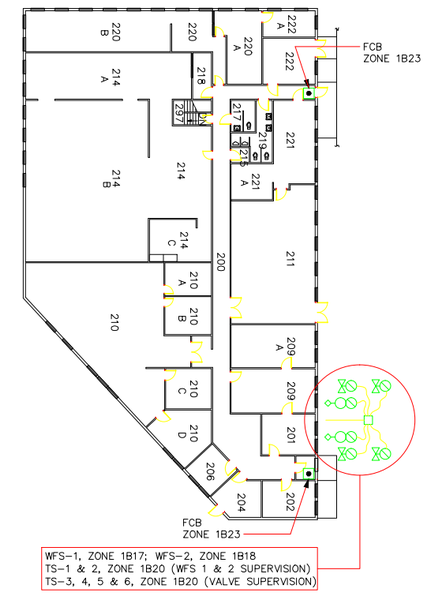


SECOND FLOOR

PLAN

SCALE: 1" = 20'-0"

N

SYMBOLS

- FIRE CALL BOX
- WATER FLOW SWITCH WITH TAMPER SWITCH
- VALVE SUPERVISION TAMPER SWITCH
- BELL

| | | | | | | | |
|---|---|---|---|---|---|---|---|
| ASBUILT G 4/24/2013 | G | LDD | LDD | MCD | 04/24/13 | AS-BUILT PER FIELD VERIFICATIONS | |
| | F | SL | SL | | 4/20/10 | AS BUILT | |
| | E | AD | LDD | MCD | 12/06/06 | AS-BUILT RECORD DRAWING PER CONSTRUCTION MARK-UP | |
| | D | RZT | MCG | MCG | 5/16/05 | REVISED FOR MXL SYSTEM | |
| | C | MRC | AD | MCG | 9/2/04 | REVISED FOR DIGITIZE SYSTEM | |
| | B | | | | | REDRAWN ON AUTOCAD | |
| | A | LSR | JEH | ROB | 5-11-94 | BLDGS. 9 & 12 REMOVED | |
| PROFESSIONAL SEAL (IF REVISION, APPLIES ONLY TO REVISED WORK) | ISSUE (PROGRESS, ESTIMATE, IBD, CONSTRUCTION, CONFORMED, REVISION, AS-BUILT) | REVISION NUMBER | DRAWN BY | CHECKED BY | APPR'D BY | DATE | REMARKS |

07
FIRE ALARM SYSTEM
LOGIC AND PLAN

UNIVERSITY OF CALIFORNIA
LAWRENCE BERKELEY NATIONAL LABORATORY
FACILITIES DEPARTMENT

| | | |
|---|---|---|
| DRAWN BY | LSR | DATE 12/3/2085 |
| CHECKED BY | RG | 1/3/2086 |
| APPROVED BY | BS | 1/13/2086 |
| CAD FILE PATH | | |
| SCALE | AS NOTED | |
| DRAWING NO. | 4B07E007G | SHEET FA |
| PROJECT NO. | FB4010 | 1 OF 1 |