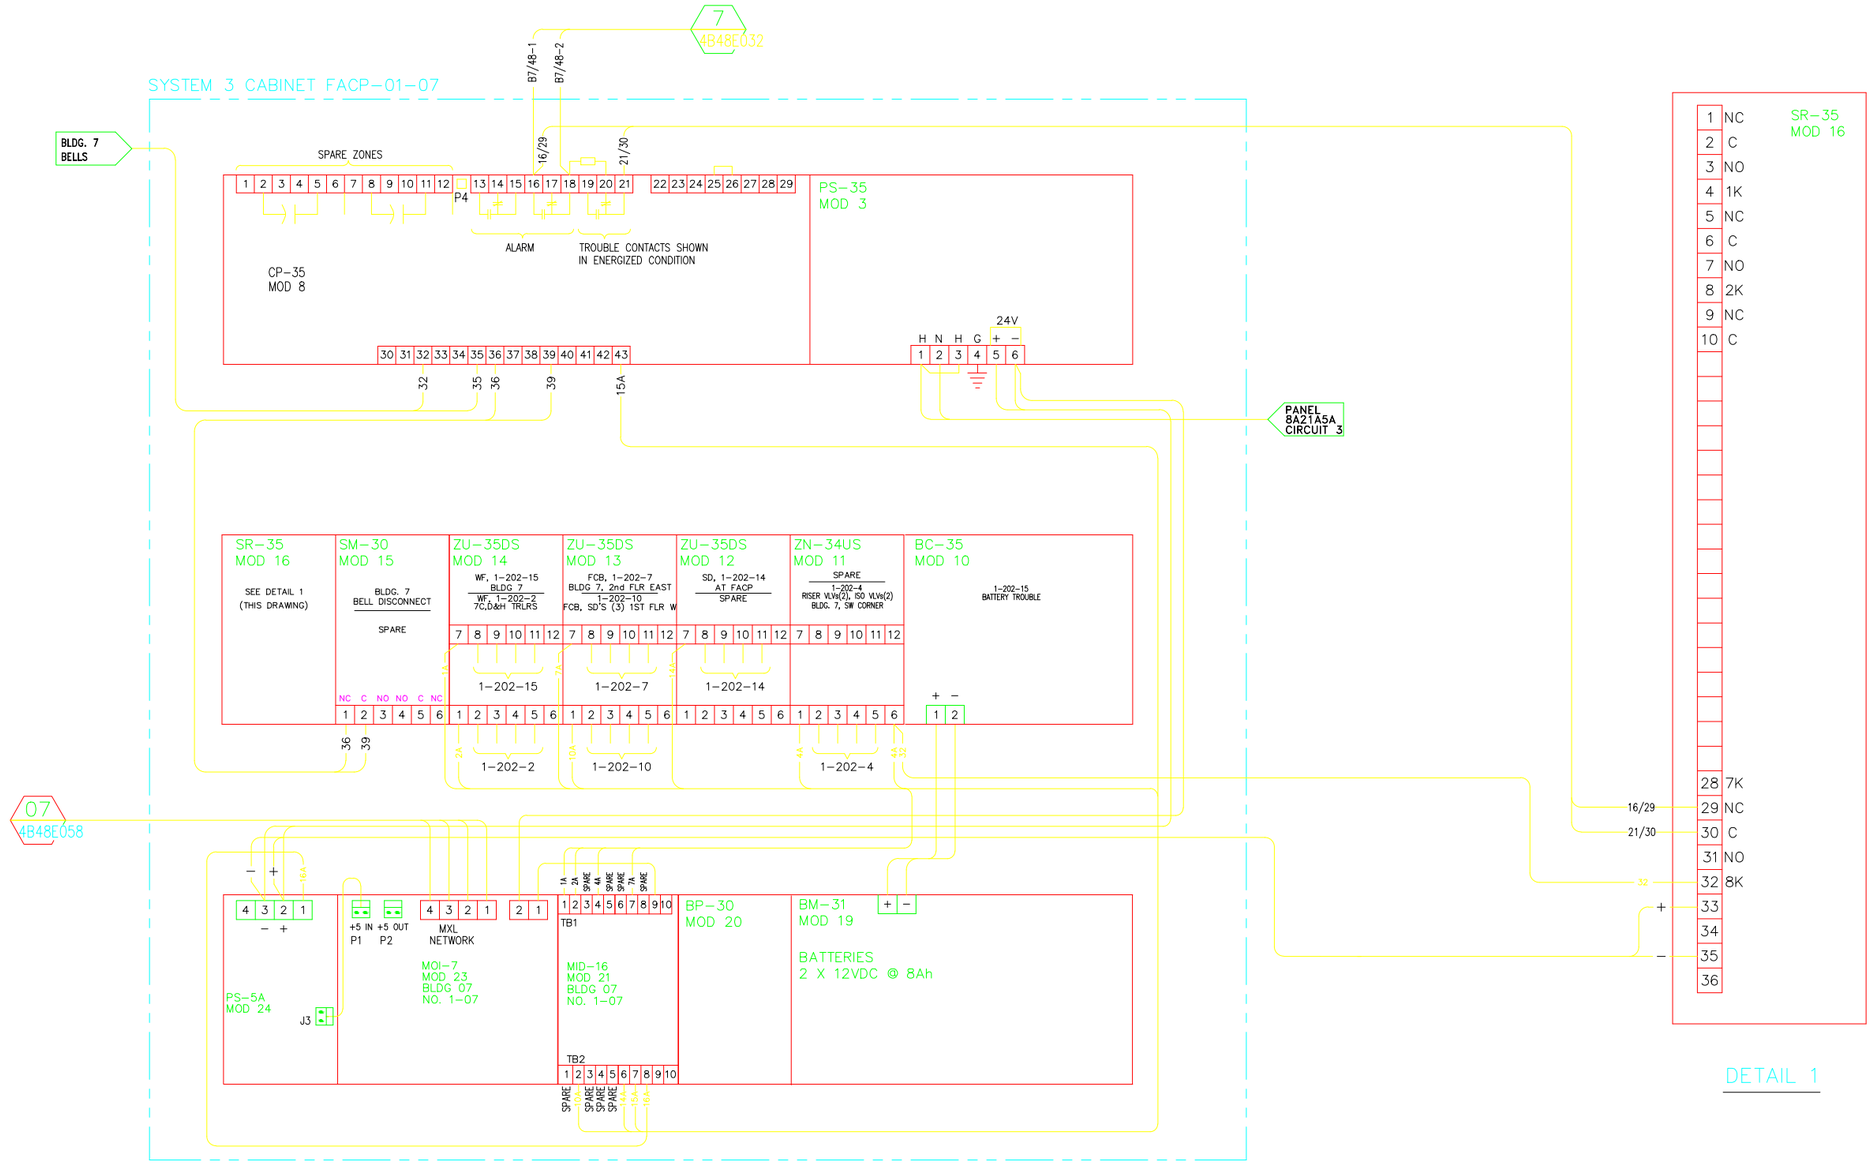

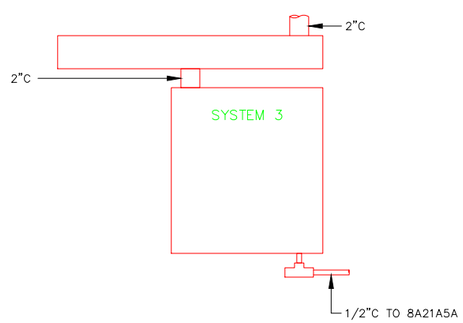

ELEVATION

	AS BUILT	H	LDD	LDD	MCD	04/24/13	AS-BUILT PER FIELD VERIFICATIONS
		G	SL	SL		04/20/10	AS BUILT
	H	F	AD	LDD	MCG	12/06/06	AS-BUILT RECORD DRAWING PER CONSTRUCTION MARK-UP
	4/24/2013	E	RZT	MCG	MCG	9/16/05	REVISED FOR MXL SYSTEM
		D	MRC	AD	MCG	9/2/04	PHASE III FIRE ALARM SYSTEM UPGRADE
		C					REDRAWN ON AUTOCAD
		B	LSR	JEH	R.Baker	5-11-94	REDRAWN – BLDGS. 9 & 12 GONE
PROFESSIONAL SEAL (IF REVISION APPLIES ONLY TO REVISED WORK)	ISSUE (PROGRESS, ESTIMATE, BID, CONSTRUCTION, CONFORMED, REVISION, RECORD)	REVISION NUMBER	DRAWN BY	CHECKED BY	APPR'D BY	DATE	REMARKS

07
FIRE ALARM SYSTEM
INTERCONNECTION DIAGRAM

UNIVERSITY OF CALIFORNIA
LAWRENCE BERKELEY NATIONAL LABORATORY
FACILITIES DIVISION

DRAWN BY	LSR
DATE	11/7/206
CHECKED BY	
APPROVED BY	
CAD FILE PATH	
SCALE	Full
DRAWING NO.	4B07E008H
SHEET	FA
PROJECT NO.	FB4010
	1 OF 1