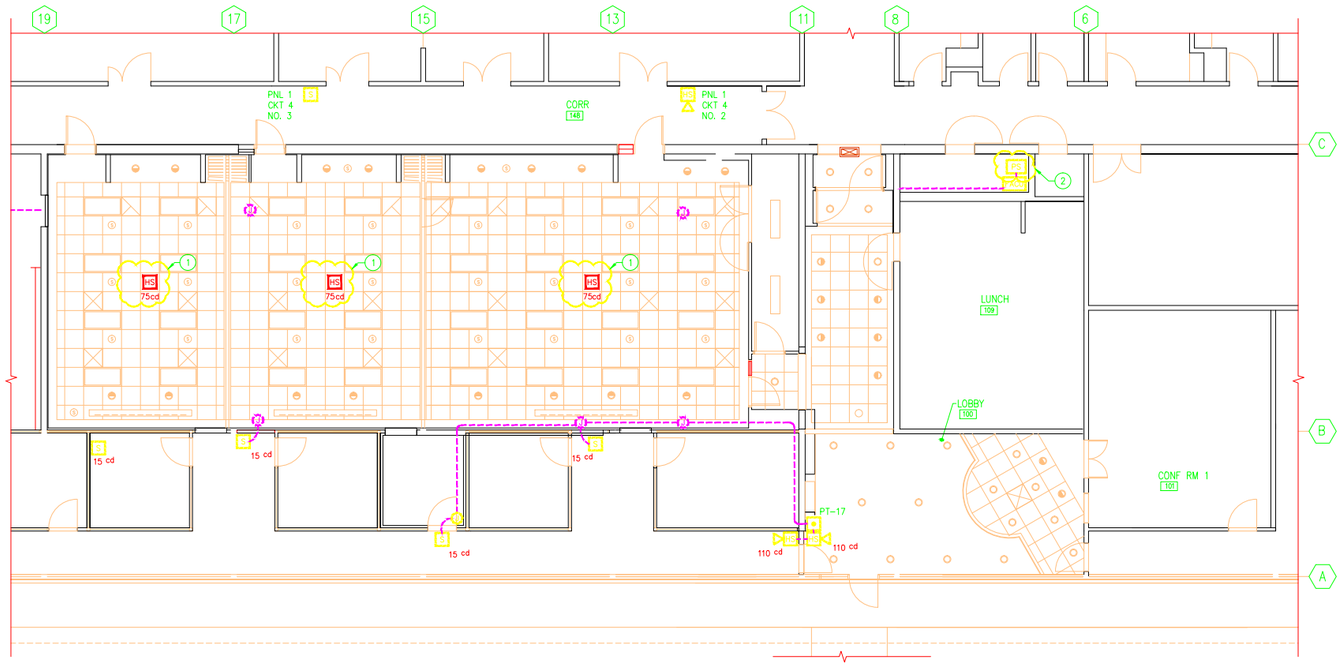

PARTIAL FIRE ALARM MODIFICATIONS PLAN – REFLECTED CEILING PLAN

1/8" = 1'-0"

1 FA1.3 | FA1.3

NORTH

8' 4' 0' 8' 16'

GRAPHIC SCALE: 1/8" = 1'-0"

KEYNOTES

1. NEW CEILING MOUNTED COMBINATION AUDIBLE/VISUAL OCCUPANT NOTIFICATION APPLIANCE
2. NEW POWER SUPPLY FOR NEW OCCUPANT NOTIFICATION APPLIANCE, IF THE EXISTING POWER SUPPLIES AND BATTERY BACK-UP CANNOT BE CONFIRMED BY CALCULATIONS TO BE ADEQUATE FOR THE NEW POWER DEMANDS.

LEGEND

- EXISTING RADIONICS FIRE ALARM CONTROL UNIT
- 110 cd — EXISTING AUDIBLE/VISUAL NOTIFICATION APPLIANCE
- 110 cd — EXISTING VISUAL NOTIFICATION APPLIANCE
- EXISTING RACEWAY JUNCTION BOX
- EXISTING FIRE ALARM CONDUIT RACEWAY
- 110 cd — NEW CEILING MOUNTED AUDIBLE/VISUAL NOTIFICATION APPLIANCE
- NEW NOTIFICATION APPLIANCE POWER SUPPLY
- NEW RACEWAY JUNCTION BOX
- NEW ¾" FIRE ALARM CONDUIT RACEWAY

KEYPLAN

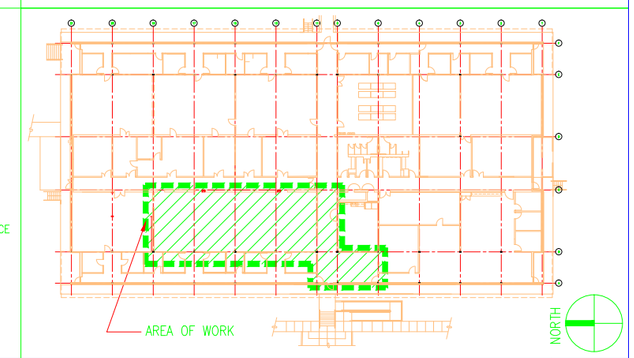

HYT Corporation
Fire Protection Engineers and Consultants
3498 Clayton Road - Suite 101 Concord, California
94519 Phone: (925) 681-2731 FAX: (925) 681-2733

TECTONICS
architects • planners • engineers
1500 PARK AVENUE
EMERYVILLE, CA 94608-3551
TEL: (510) 740-2400

CONSULTING FIRM | CONSULTING FIRM | CONSULTING A/E FIRM | PROFESSIONAL SEAL (IF REVISION, APPLIES ONLY TO REVISED WORK)

RECORD DRAWING 07/28/06

REVISION NUMBER	DRAWN BY	CHECKED BY	APPR'D BY	DATE	REMARKS
1	HYT	BT	DH	10/11/05	CONFORMED SET
--	HYT	BT	DH	07/28/06	RECORD DRAWING

ISSUE (PROGRESS, ESTIMATE, BID, CONSTRUCTION, CONFORMED, REVISION, AS-BUILT)

JGI – B100
CONFERENCING CENTER
FIRE ALARM MODIFICATIONS PLAN

UNIVERSITY OF CALIFORNIA
LAWRENCE BERKELEY NATIONAL LABORATORY
FACILITIES DIVISION

DRAWN BY	DWH	DATE	06/28/05
CHECKED BY	BBT		06/28/05
APPROVED BY			
CAD FILE PATH	00019533		
SCALE	1/8" = 1'-0"		
DRAWING NO.	4B100E086A	SHEET	FA1.3
PROJECT NO.	FX5400		30 OF 45