SPECIAL NOTE:
PROVIDE A POWER LIMITING MODULE (PL-35) TO PERMIT ALD AND CSM CIRCUITS TO BE WITHIN THE SAME CONDUIT.

SPECIAL NOTE:
PROVIDE A SIEMENS MXL-MPFO (P/N 500-692880) TO ALLOW MOUNTING OF TWO D2300 FIBER OPTIC MODULES.

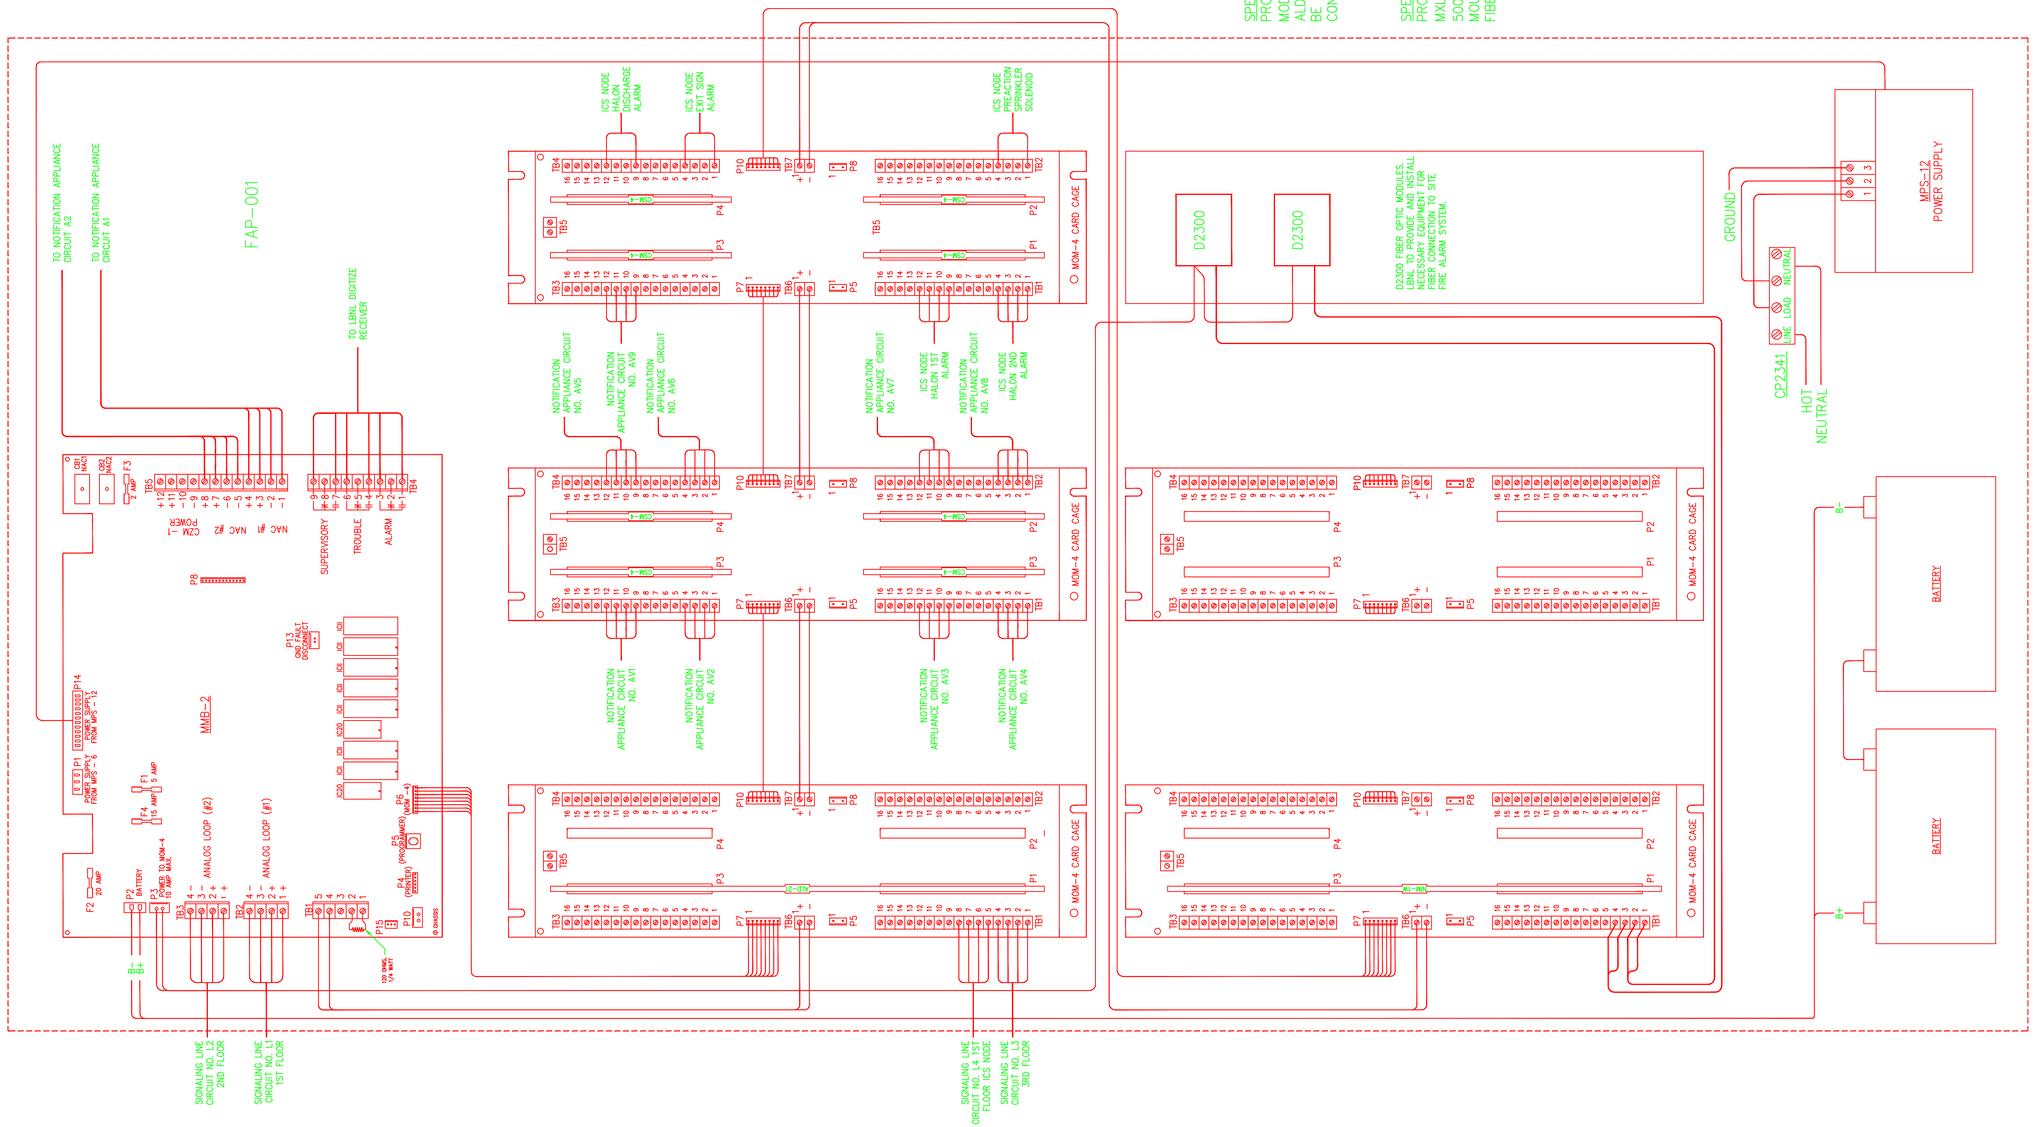

PROFESSIONAL SEAL (IF REVISION, APPLIES ONLY TO REVISED WORK)	ISSUE (PROGRESS, ESTIMATE, BID, CONSTRUCTION, CONFORMED, REVISION, RECORD)	REVISION NUMBER	DRAWN BY	CHECKED BY	APPR'D BY	DATE	REMARKS
	ASBUILT A 05/20/2013	A	DSV	LDD	MCD	05-13	ASBUILT

BLDG-15 FIRE ALARM
FAP-01-15 DETAIL & WIRING

UNIVERSITY OF CALIFORNIA
LAWRENCE BERKELEY NATIONAL LABORATORY
FACILITIES DIVISION

DRAWN BY	DSV	DATE 05/20/2013
CHECKED BY	LDD	05/20/2013
APPROVED BY	MCD	05/20/2013
SCALE	NONE	
DRAWING NO.	4B15E059A	SHEET 03
PROJECT NO.	FN1438	3 OF 9