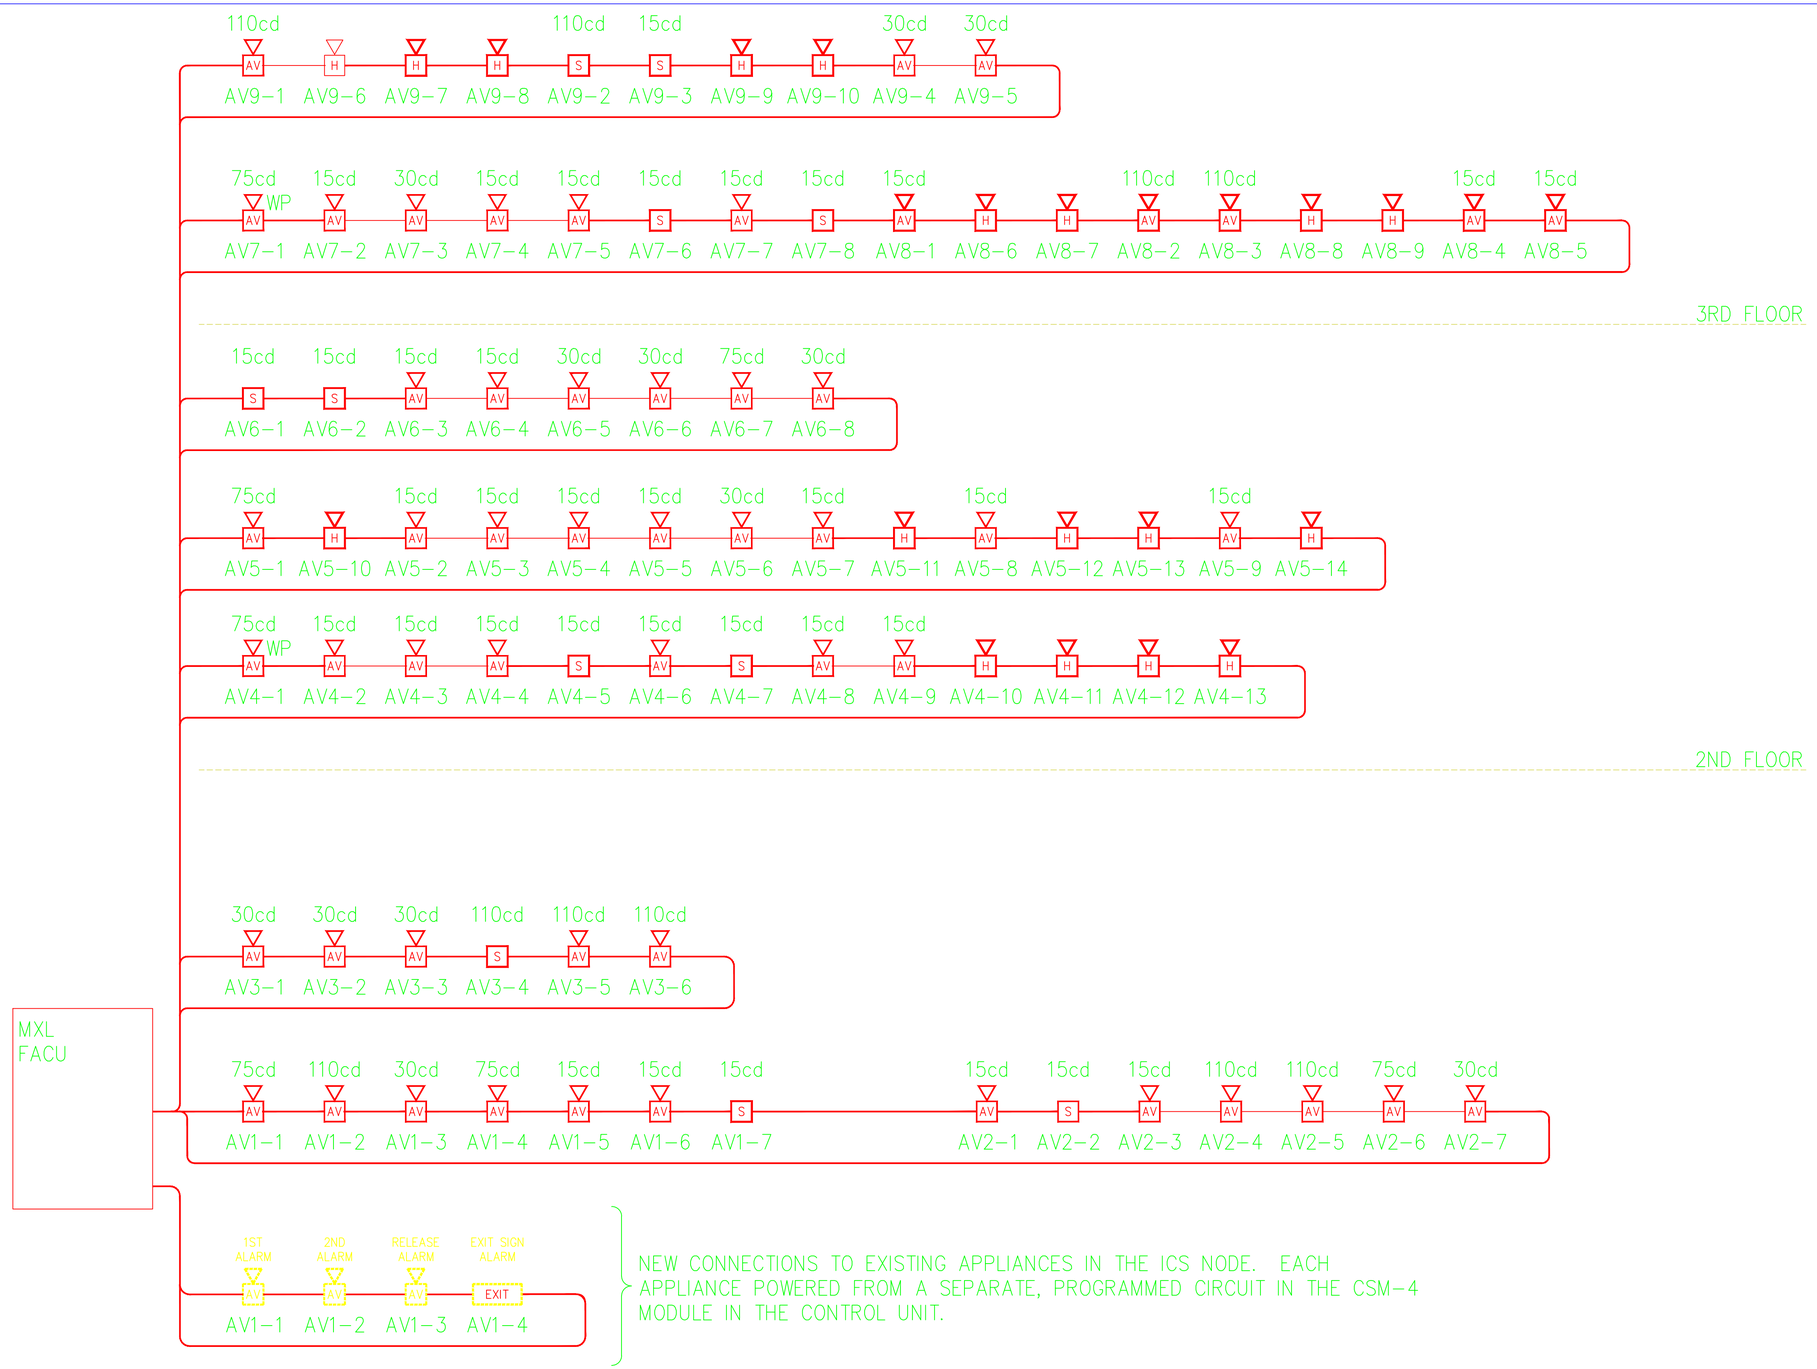

PROFESSIONAL SEAL (IF REVISION, APPLIES ONLY TO REVISED WORK)	ASBUILT A 05/20/2013	A	DSV	LDD	MCD	05-13	ASBUILT
	ISSUE (PROGRESS, ESTIMATE, BID, CONSTRUCTION, CONFORMED, REVISION, RECORD)	REVISION NUMBER	DRAWN BY	CHECKED BY	APPR'D BY	DATE	REMARKS

BLDG-15 FIRE ALARM
RISER DIAGRAM
NOTIFICATION DEVICES

UNIVERSITY OF CALIFORNIA
LAWRENCE BERKELEY NATIONAL LABORATORY
FACILITIES DIVISION

DRAWN BY DSV	DATE 05/20/2013	
CHECKED BY LDD	05/20/2013	
APPROVED BY MCD	05/20/2013	
SCALE NONE		
DRAWING NO. 4B15E060A		SHEET 04
PROJECT NO. FN1438		4 OF 9