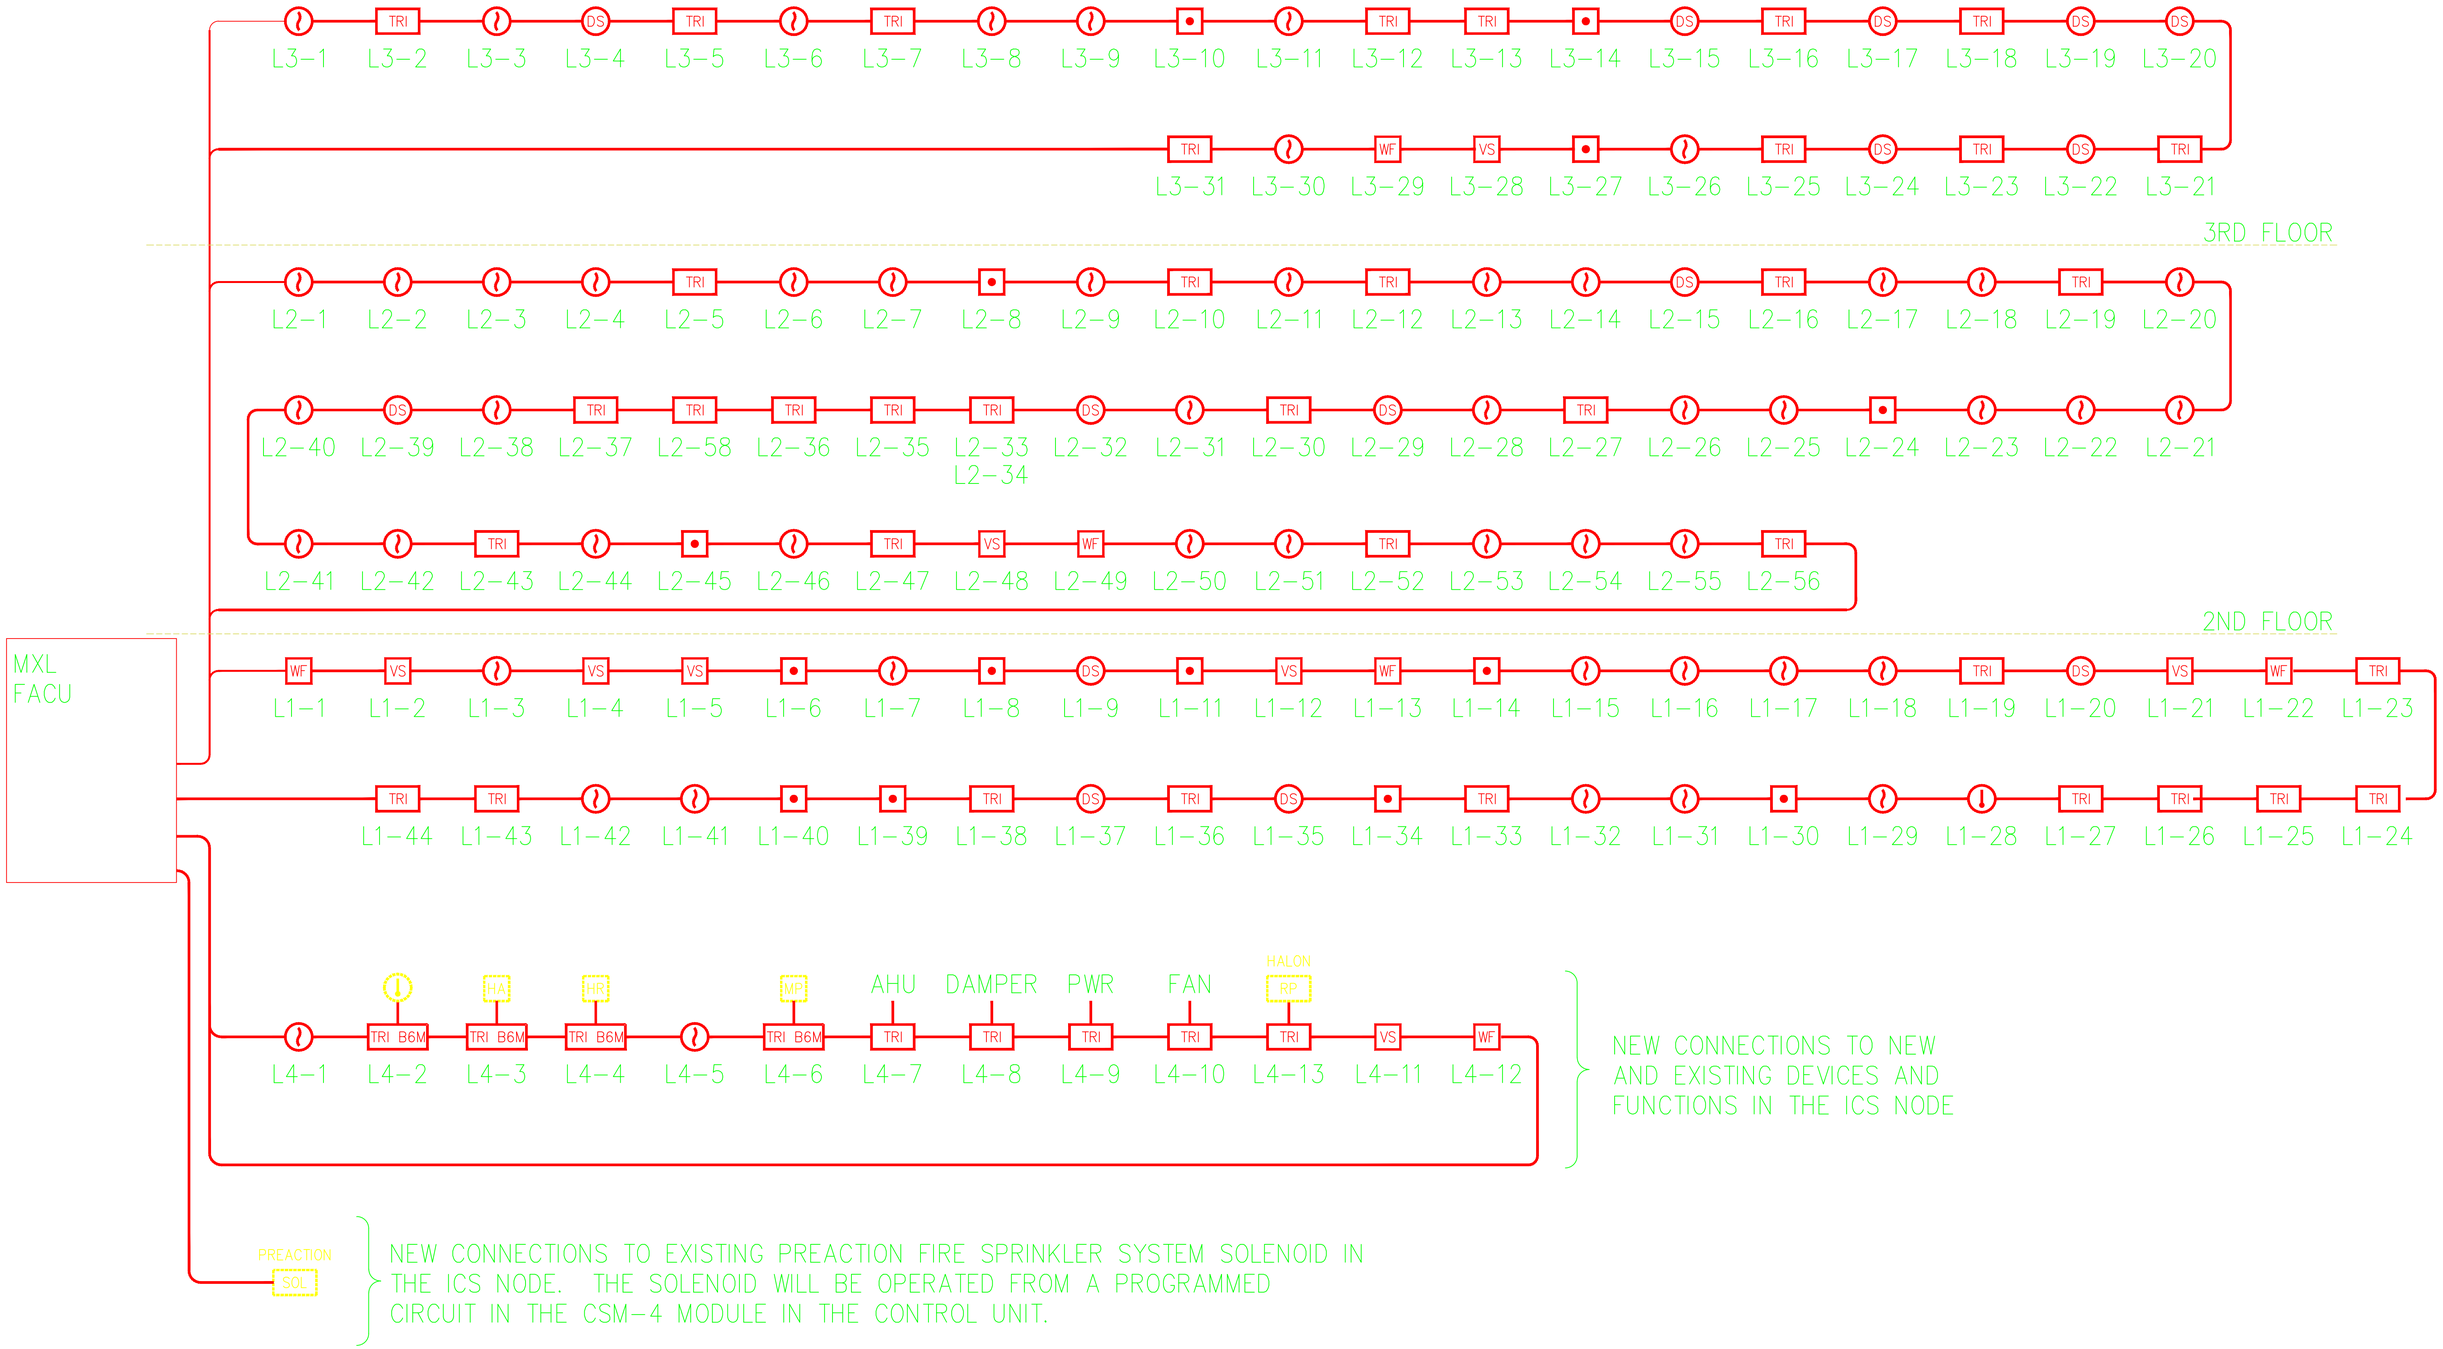

PROFESSIONAL SEAL (IF REVISION, APPLIES ONLY TO REVISED WORK)	ISSUE (PROGRESS, ESTIMATE, BID, CONSTRUCTION, CONFORMED, REVISION, RECORD)	REVISION NUMBER	DRAWN BY	CHECKED BY	APPR'D BY	DATE	REMARKS
	ASBUILT A 05/20/2013	A	DSV	LDD	MCD	05-13	ASBUILT

BLDG-15 FIRE ALARM
RISER DIAGRAM
ALARM INITIATING DEVICES

UNIVERSITY OF CALIFORNIA
LAWRENCE BERKELEY NATIONAL LABORATORY
FACILITIES DIVISION

		DATE
DRAWN BY	DSV	05/20/2013
CHECKED BY	LDD	05/20/2013
APPROVED BY	MCD	05/20/2013
SCALE	NONE	
DRAWING NO.	4B15E061A	SHEET 05
PROJECT NO.	FN1438	1 OF 1