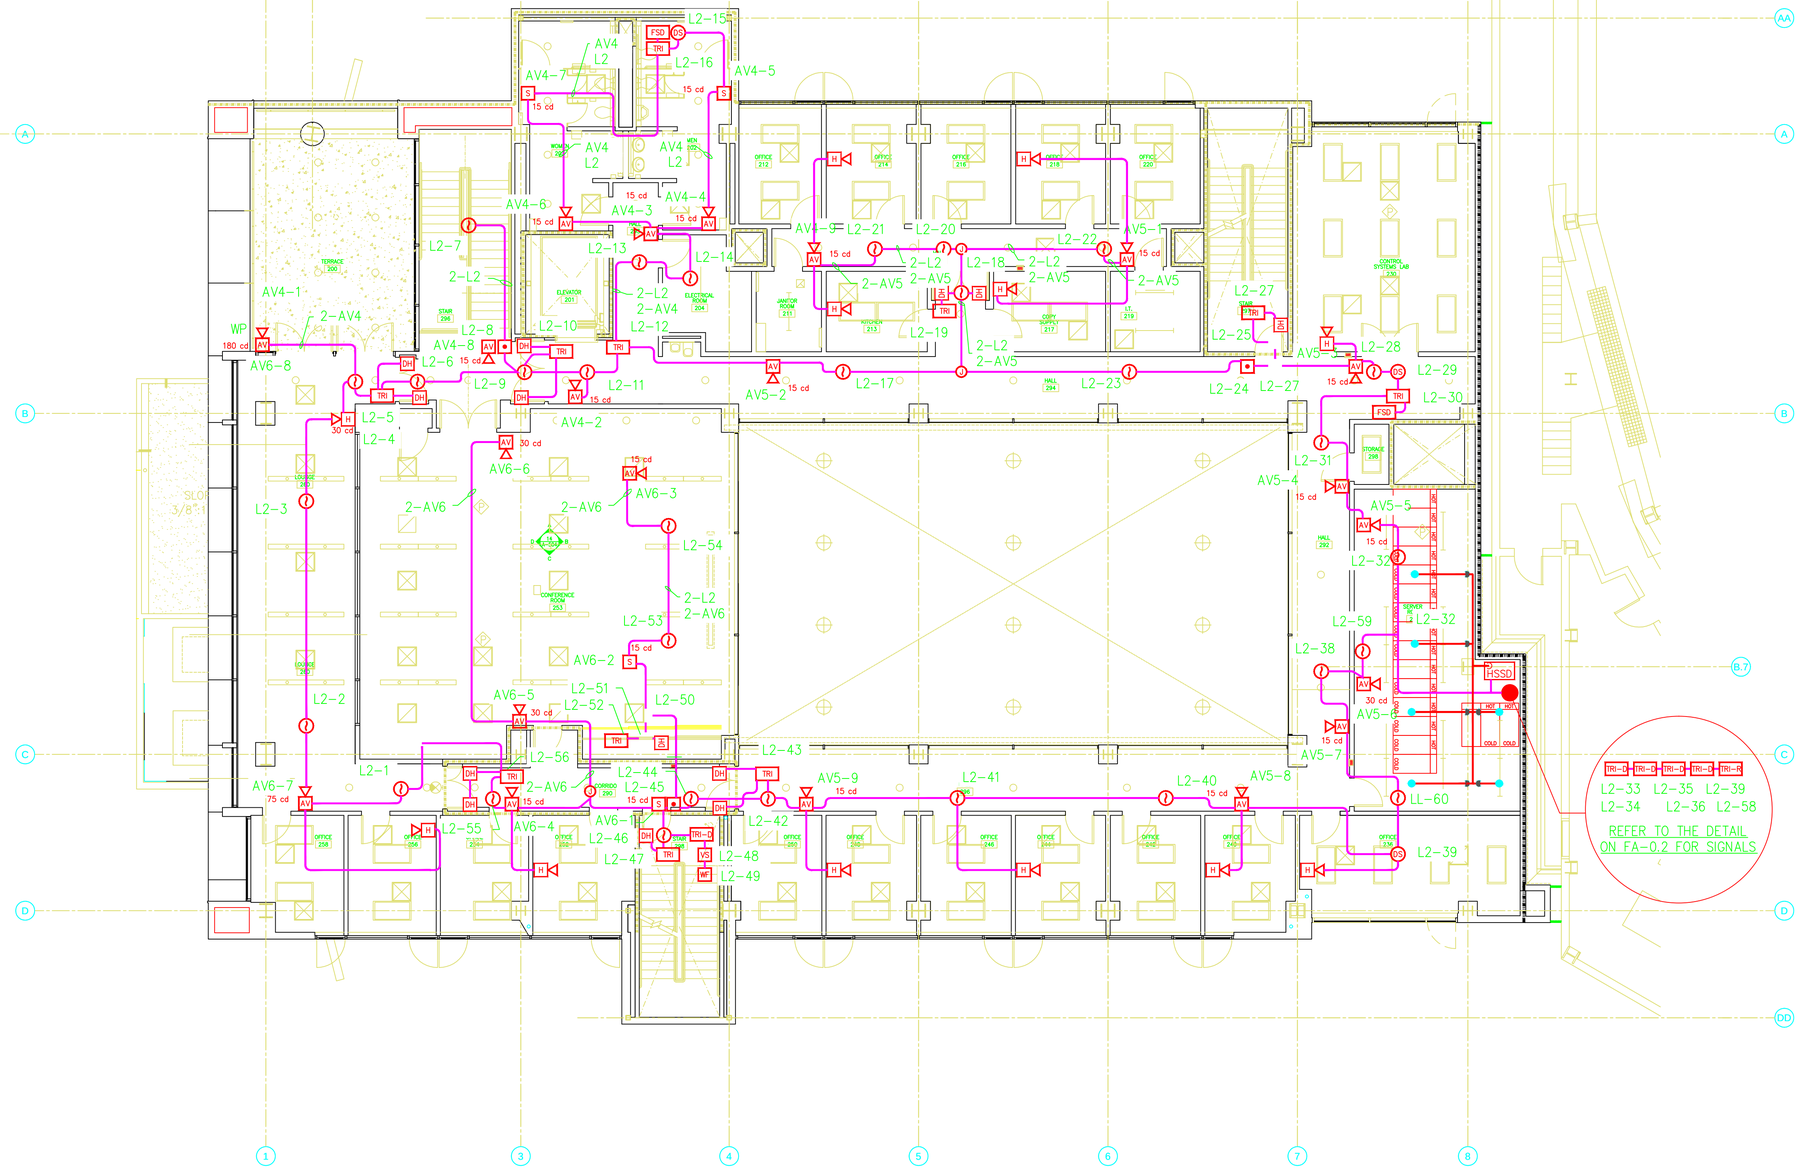

ASBUILT
B
07/29/2013

REVISION NUMBER	DRAWN BY	CHECKED BY	APPR'D BY	DATE	REMARKS
B	DSV	LDD	MCD	07/29/13	AS BUILT PER FIELD VERIFICATIONS
A	DSV	LDD	MCD	05-13	ASBUILT

PROFESSIONAL SEAL (IF REVISION, APPLIES ONLY TO REVISED WORK)

ISSUE (PROGRESS, ESTIMATE, BID, CONSTRUCTION, CONFORMED, REVISION, RECORD)

BLDG-15 FIRE ALARM
2ND FLOOR PLAN

UNIVERSITY OF CALIFORNIA
LAWRENCE BERKELEY NATIONAL LABORATORY
FACILITIES DIVISION

DRAWN BY DSV	DATE 05/20/2013	
CHECKED BY LDD	05/20/2013	
APPROVED BY MCD	05/20/2013	
SCALE 1/8" = 1'-0"		
DRAWING NO. 4B15E063B	SHEET 07	
PROJECT NO. FN1438	7 OF 9	