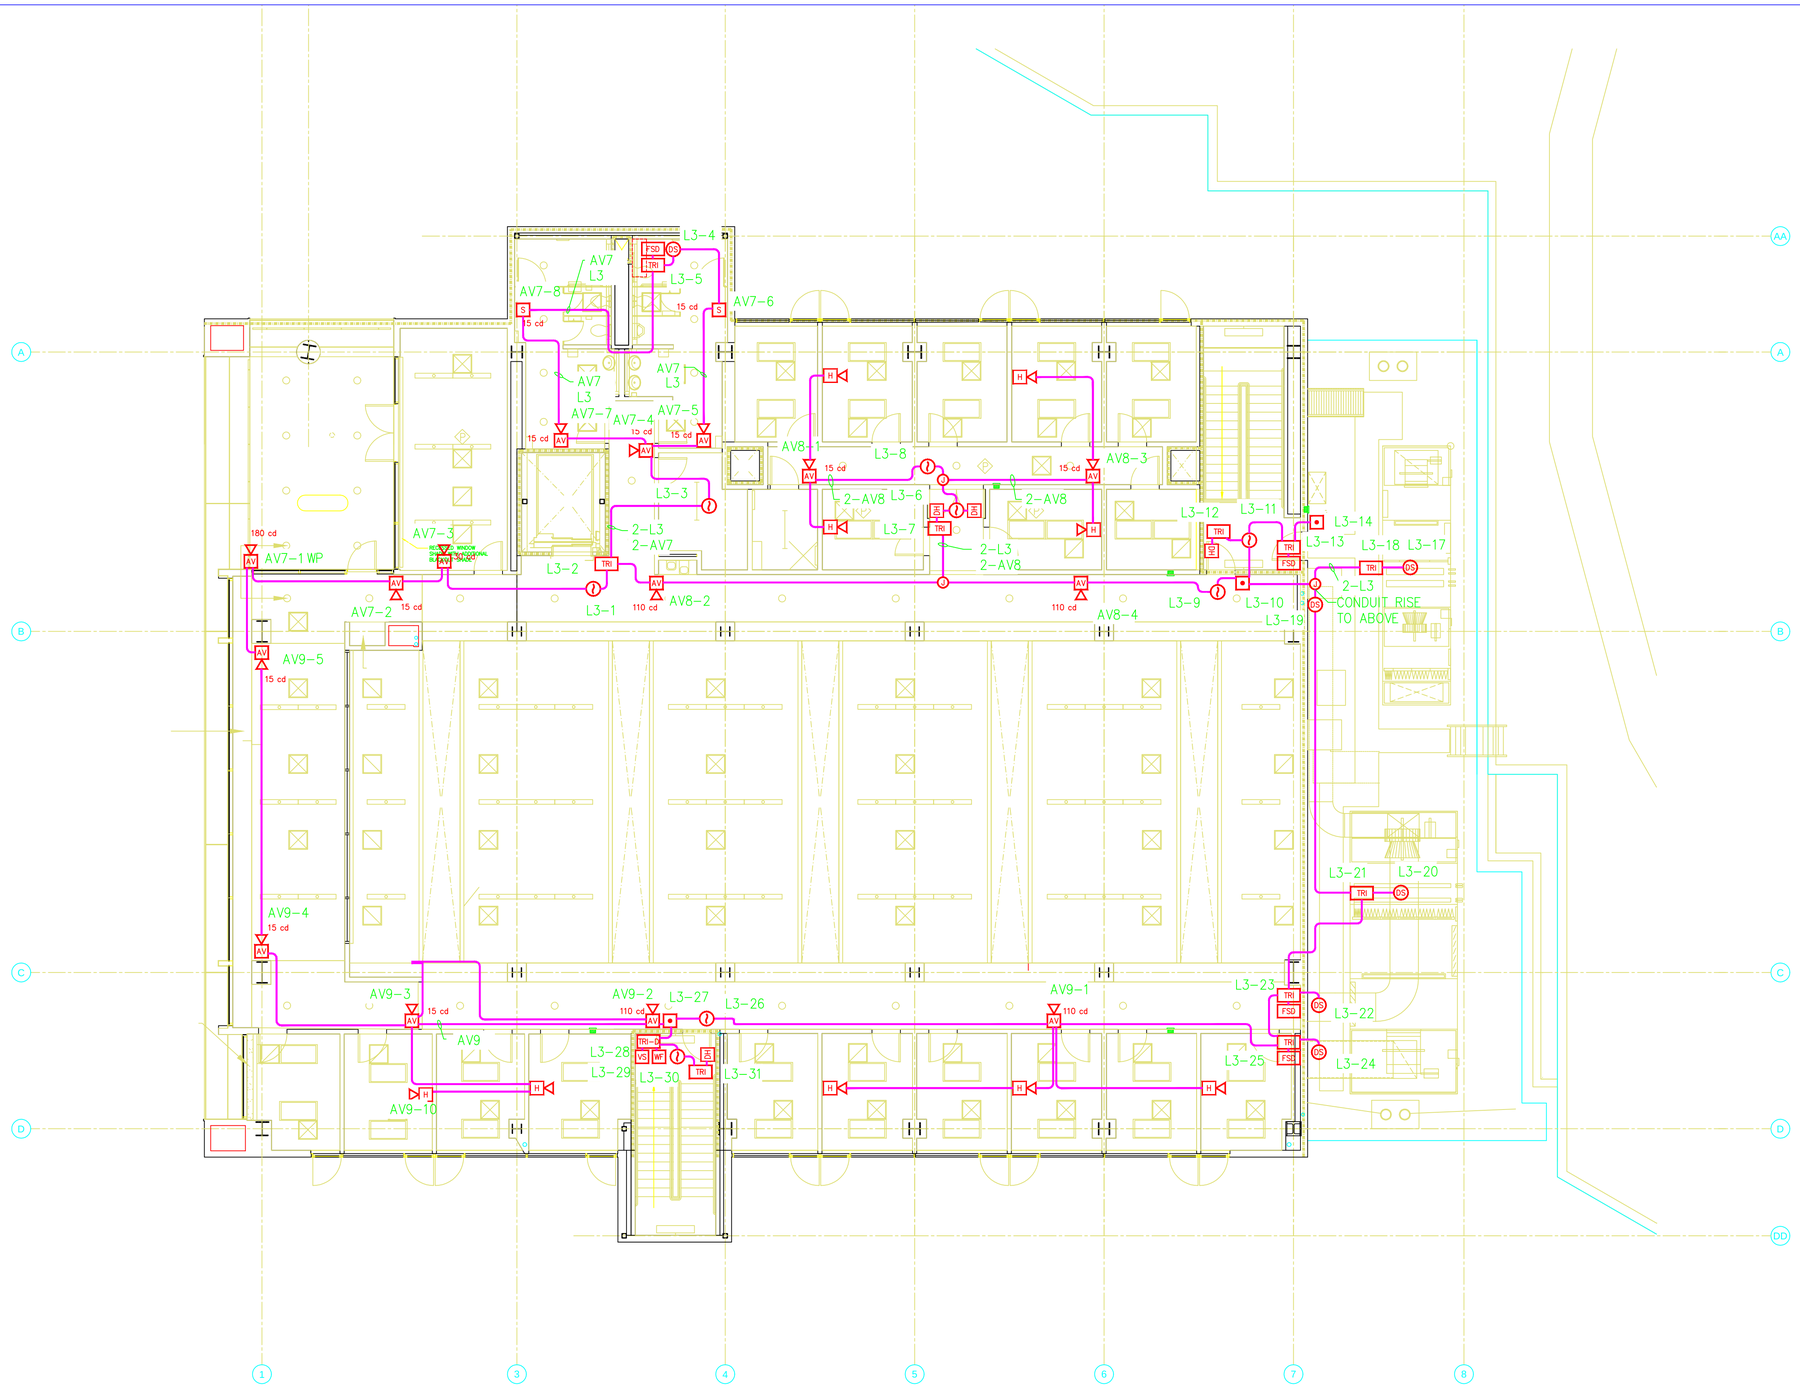

RACEWAY NOTES:

1. UNLESS NOTED OTHERWISE, THE RACEWAYS SHOWN ON THIS SHEET CONTAIN CIRCUITS L3, AV7, AV8 & AV9.

	ASBUILT B 07/29/2013	B	DSV	LDD	MCD	07/29/13	AS BUILT PER FIELD VERIFICATIONS
		A	DSV	LDD	MCD	05-20	ASBUILT
PROFESSIONAL SEAL (IF REVISION, APPLIES ONLY TO REVISED WORK)	ISSUE (PROGRESS, ESTIMATE, BID, CONSTRUCTION, CONFORMED, REVISION, RECORD)	REVISION NUMBER	DRAWN BY	CHECKED BY	APPR'D BY	DATE	REMARKS

BLDG-15 FIRE ALARM
3RD FLOOR PLAN

UNIVERSITY OF CALIFORNIA
LAWRENCE BERKELEY NATIONAL LABORATORY
FACILITIES DIVISION

DRAWN BY DSV	DATE 05/20/2013	
CHECKED BY LDD	05/20/2013	
APPROVED BY MCD	05/20/2013	
SCALE 1/8" = 1'-0"		
DRAWING NO. 4B15E064B	SHEET 08	
PROJECT NO. FN1438	8 OF 9	