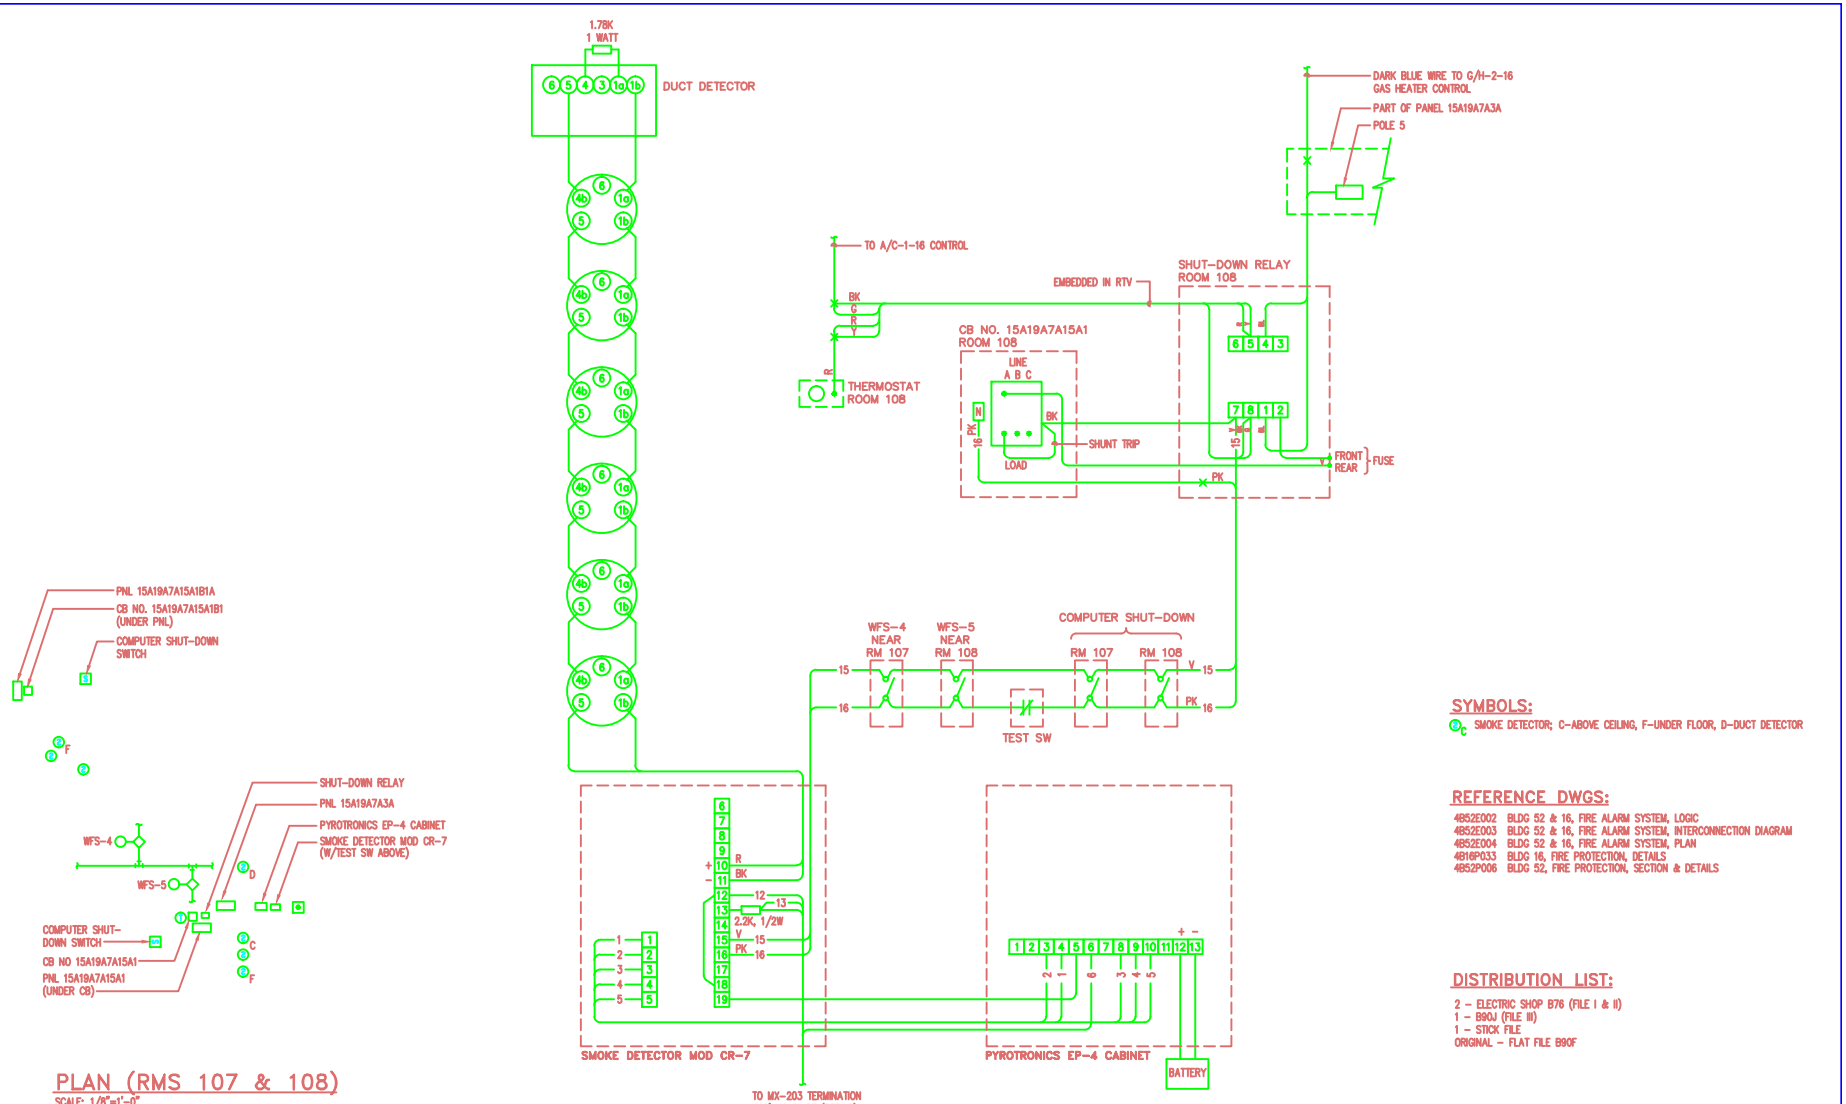

PLAN (RMS 107 & 108)

SCALE: 1/8"=1'-0"

SYMBOLS:

SMOKE DETECTOR; C-ABOVE CEILING, F-UNDER FLOOR, D-DUCT DETECTOR

REFERENCE DWGS:

4B52E002 BLDG 52 & 16, FIRE ALARM SYSTEM, LOGIC
4B52E003 BLDG 52 & 16, FIRE ALARM SYSTEM, INTERCONNECTION DIAGRAM
4B52E004 BLDG 52 & 16, FIRE ALARM SYSTEM, PLAN
4B16P033 BLDG 16, FIRE PROTECTION, DETAILS
4B52P006 BLDG 52, FIRE PROTECTION, SECTION & DETAILS

DISTRIBUTION LIST:

2 - ELECTRIC SHOP B76 (FILE I & II)
1 - B90J (FILE III)
1 - STICK FILE
ORIGINAL - FLAT FILE B90F

REVISION NUMBER	DRAWN BY	CHECKED BY	APPR'D BY	DATE	REMARKS
C	LM	ROB	MCG	8/17/94	AUTOCAD CONVERSION
B	LSR	RG		10/94	AS BUILT
A	LSR	RG		8/94	REDRAWN

16 SMOKE DETECTOR SYSTEM
COMPUTER ROOMS 107 & 108
LAYOUT AND WIRING

UNIVERSITY OF CALIFORNIA LAWRENCE BERKELEY LABORATORY
FACILITIES DEPARTMENT

DRAWN BY	LSR	DATE 8-10-94
CHECKED BY	-	-
APPROVED BY	BHS	8-14-94
CAD FILE PATH	000069009	
SCALE	AS SHOWN	
DRAWING NO.	4B16E004C	SHEET —
PROJECT NO.	FA8040	1 OF 1