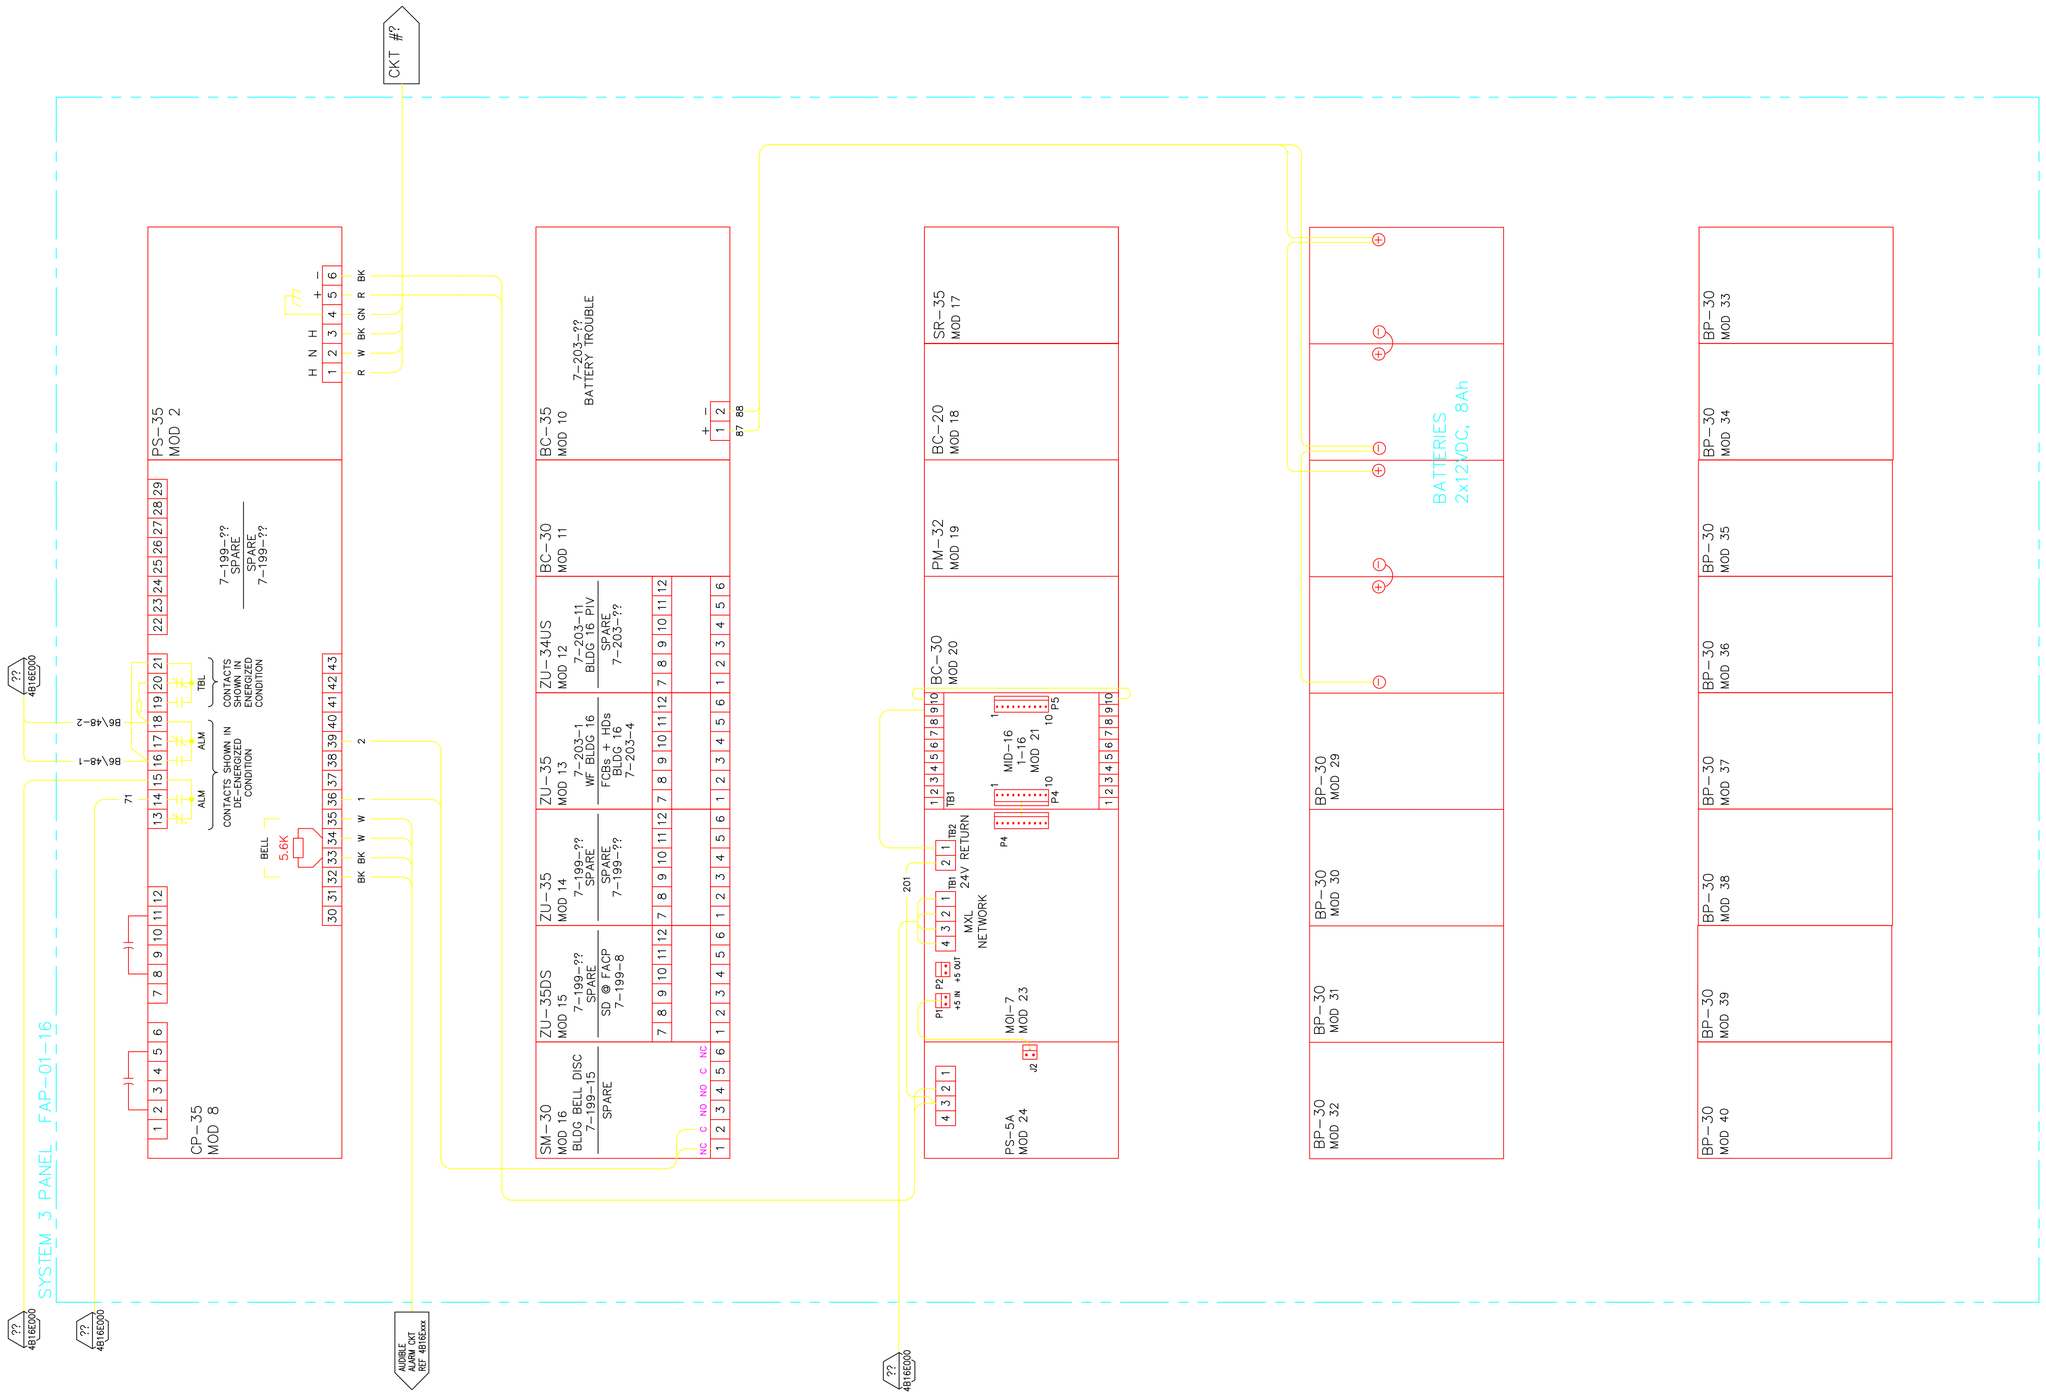

NOTES:

1. X

REFERENCE DRAWINGS

4B16Exxx X

AS BUILT

04/29/13

REVISION NUMBER	DRAWN BY	CHECKED BY	APPR'D BY	DATE	REMARKS
–	LDD	LDD	MCD	04/29/13	AS-BUILT PER FIELD VERIFICATIONS

PROFESSIONAL SEAL (IF REVISION, APPLIES ONLY TO REVISED WORK)

ISSUE (PROGRESS, ESTIMATE, BID, CONSTRUCTION, CONFORMED, REVISION, RECORD)

16 FIRE ALARM SYSTEM

SYSTEM 3 PANEL FAP-01-16

INTERCONNECTION DIAGRAM

UNIVERSITY OF CALIFORNIA
LAWRENCE BERKELEY NATIONAL LABORATORY
FACILITIES DIVISION

DRAWN BY	LDD	DATE 4/29/2013
CHECKED BY	LDD	4/29/2013
APPROVED BY	M.CD	4/29/2013
CAD FILE PATH		
SCALE	NONE	
DRAWING NO.	4B16E017_	SHEET
PROJECT NO.	000000	1 OF 1