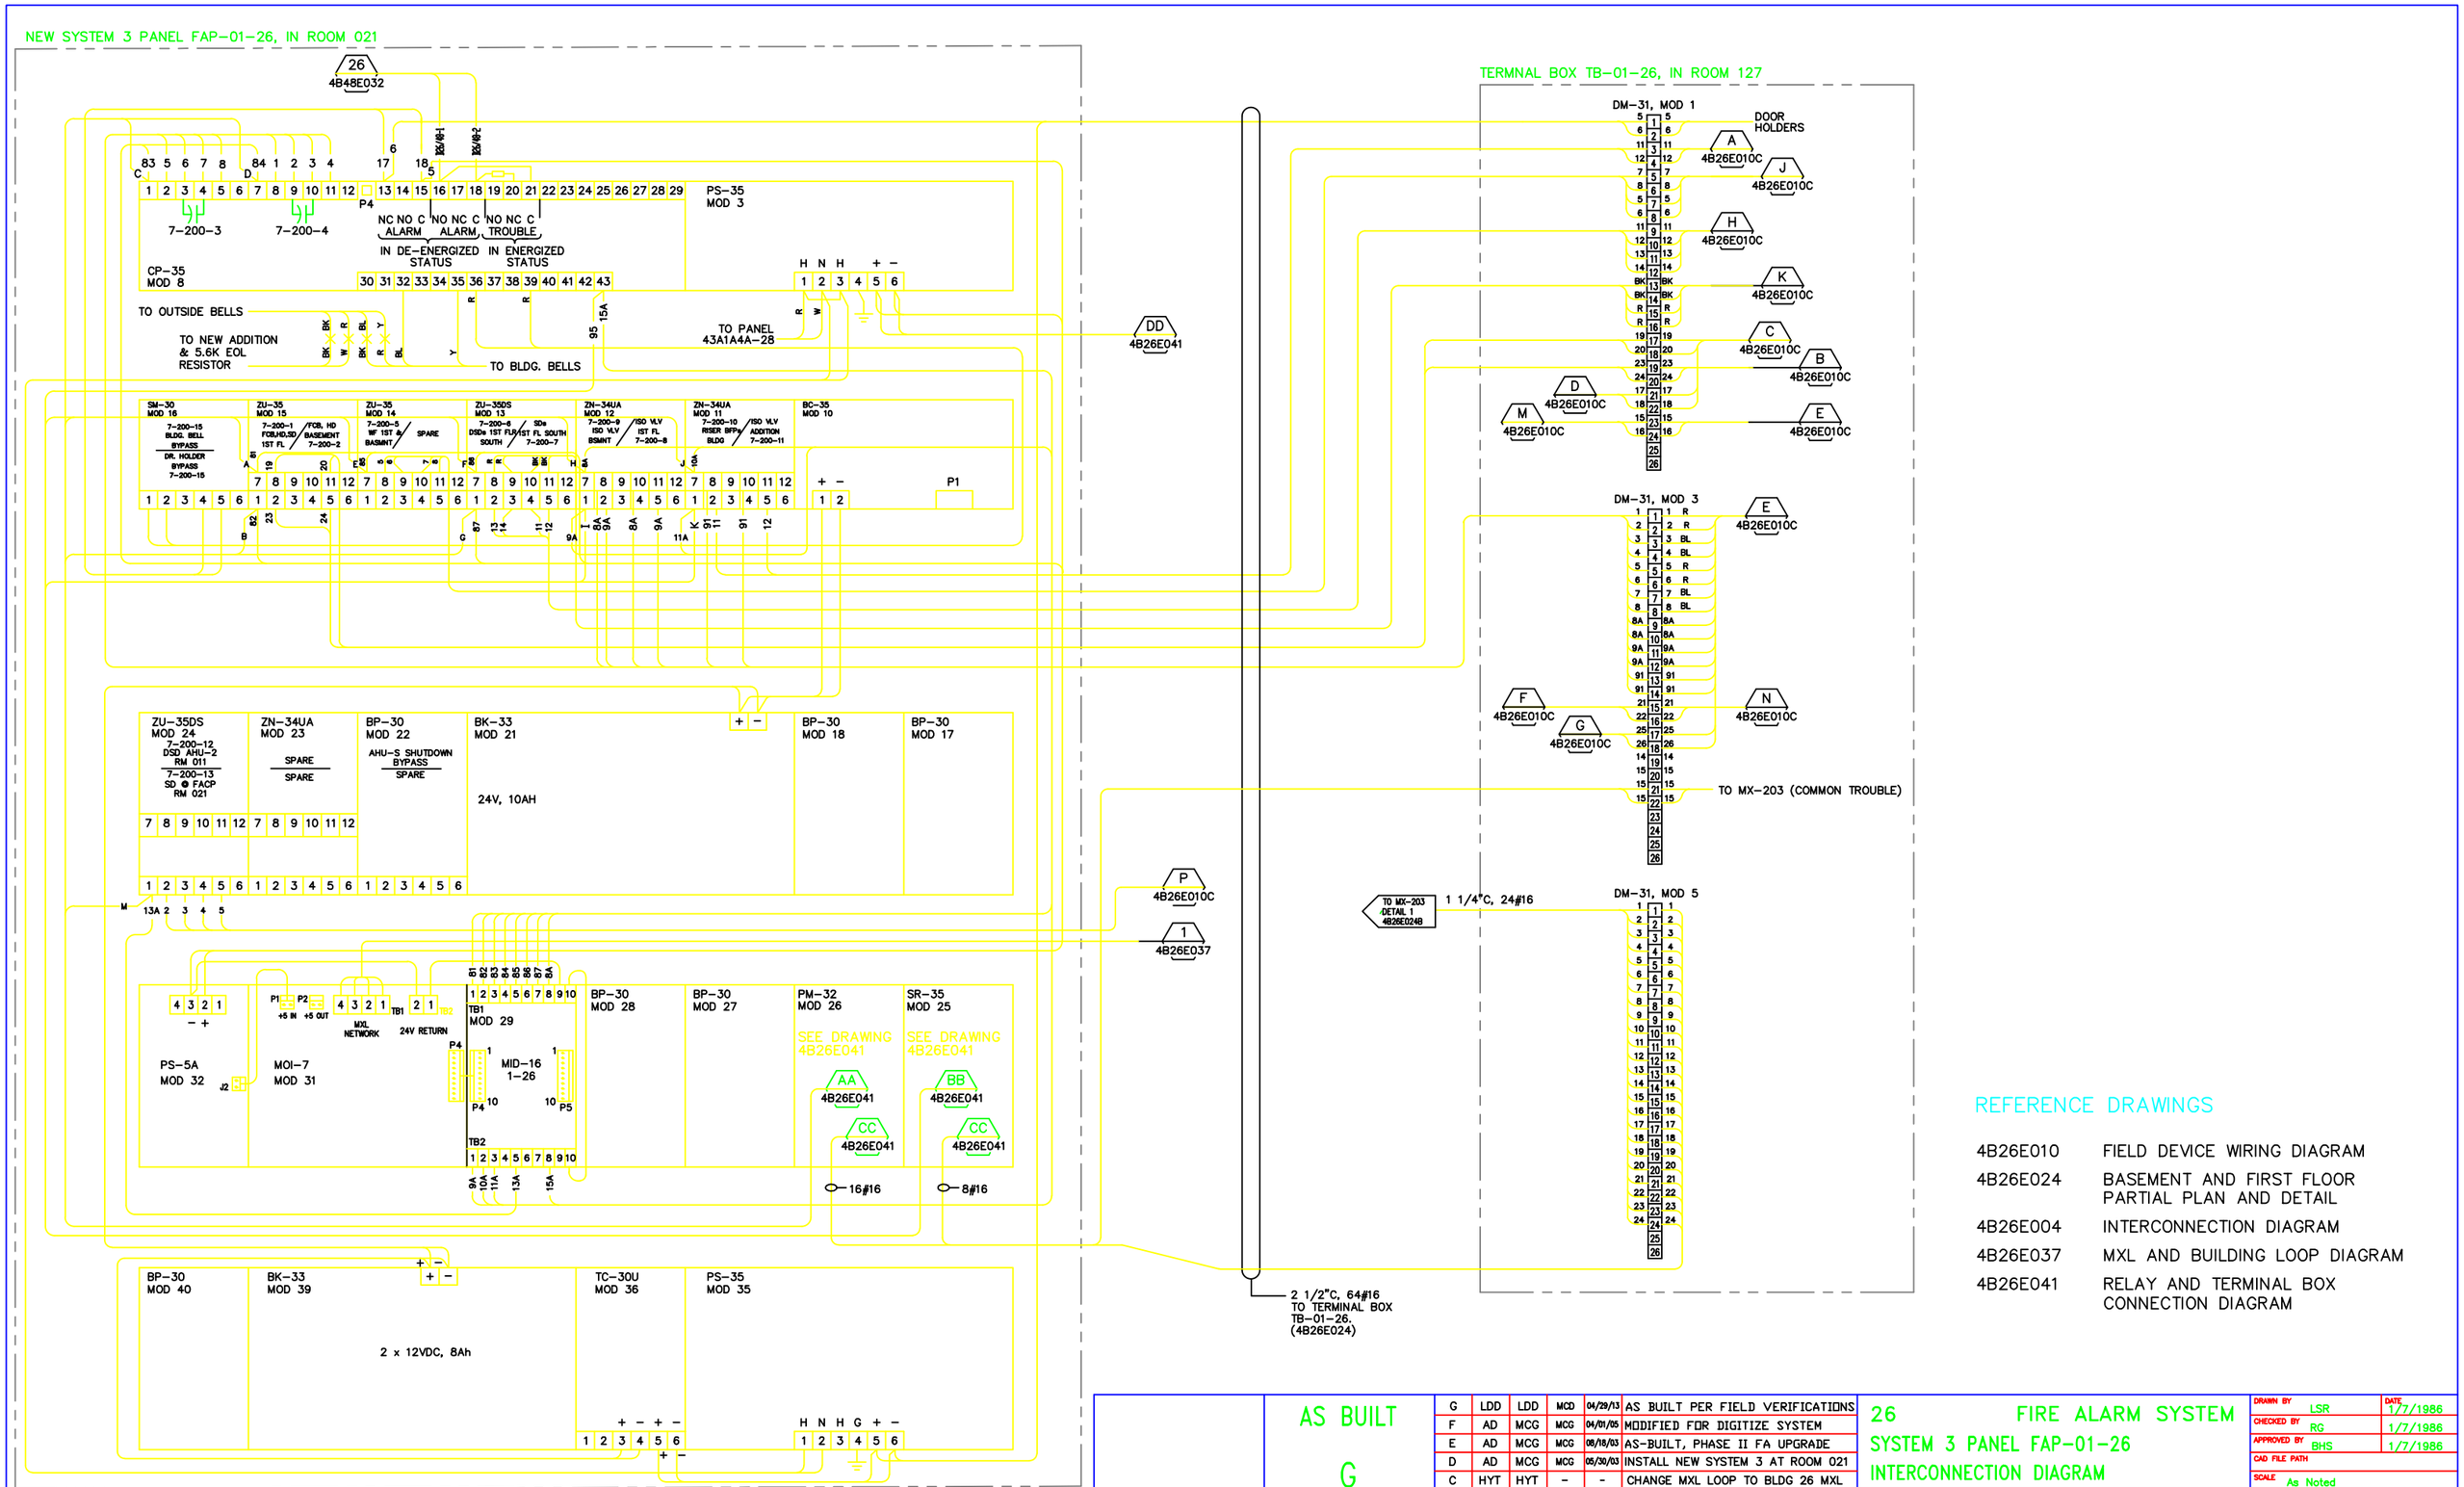

REFERENCE DRAWINGS

4B26E010	FIELD DEVICE WIRING DIAGRAM
4B26E024	BASEMENT AND FIRST FLOOR PARTIAL PLAN AND DETAIL
4B26E004	INTERCONNECTION DIAGRAM
4B26E037	MXL AND BUILDING LOOP DIAGRAM
4B26E041	RELAY AND TERMINAL BOX CONNECTION DIAGRAM

AS BUILT

G

4/29/2013

REVISION NUMBER	DRAWN BY	CHECKED BY	APPR'D BY	DATE	REMARKS
G	LDD	LDD	MCD	04/29/13	AS BUILT PER FIELD VERIFICATIONS
F	AD	MCG	MCG	04/01/05	MODIFIED FOR DIGITIZE SYSTEM
E	AD	MCG	MCG	08/18/03	AS-BUILT, PHASE II FA UPGRADE
D	AD	MCG	MCG	05/30/03	INSTALL NEW SYSTEM 3 AT ROOM 021
C	HYT	HYT	-	-	CHANGE MXL LOOP TO BLDG 26 MXL
B	HYT	HYT	-	-	FIRE ALARM REPLACEMENT PROJECT
A	LSR	JEH	ROB	10/19/93	REDRAWN ON AUTOCAD AS-BUILT

PROFESSIONAL SEAL (IF REVISION, APPLIES ONLY TO REVISED WORK)

ISSUE (PROGRESS, ESTIMATE, BID, CONSTRUCTION, CONFORMED, REVISION, RECORD)

26 FIRE ALARM SYSTEM

SYSTEM 3 PANEL FAP-01-26

INTERCONNECTION DIAGRAM

UNIVERSITY OF CALIFORNIA
LAWRENCE BERKELEY NATIONAL LABORATORY
FACILITIES DIVISION

DRAWN BY	LSR	DATE 1/7/1986
CHECKED BY	RG	1/7/1986
APPROVED BY	BHS	1/7/1986
CAD FILE PATH		
SCALE	As Noted	
DRAWING NO.	4B26E004G	SHEET 1 OF 1
PROJECT NO.	FAB040	