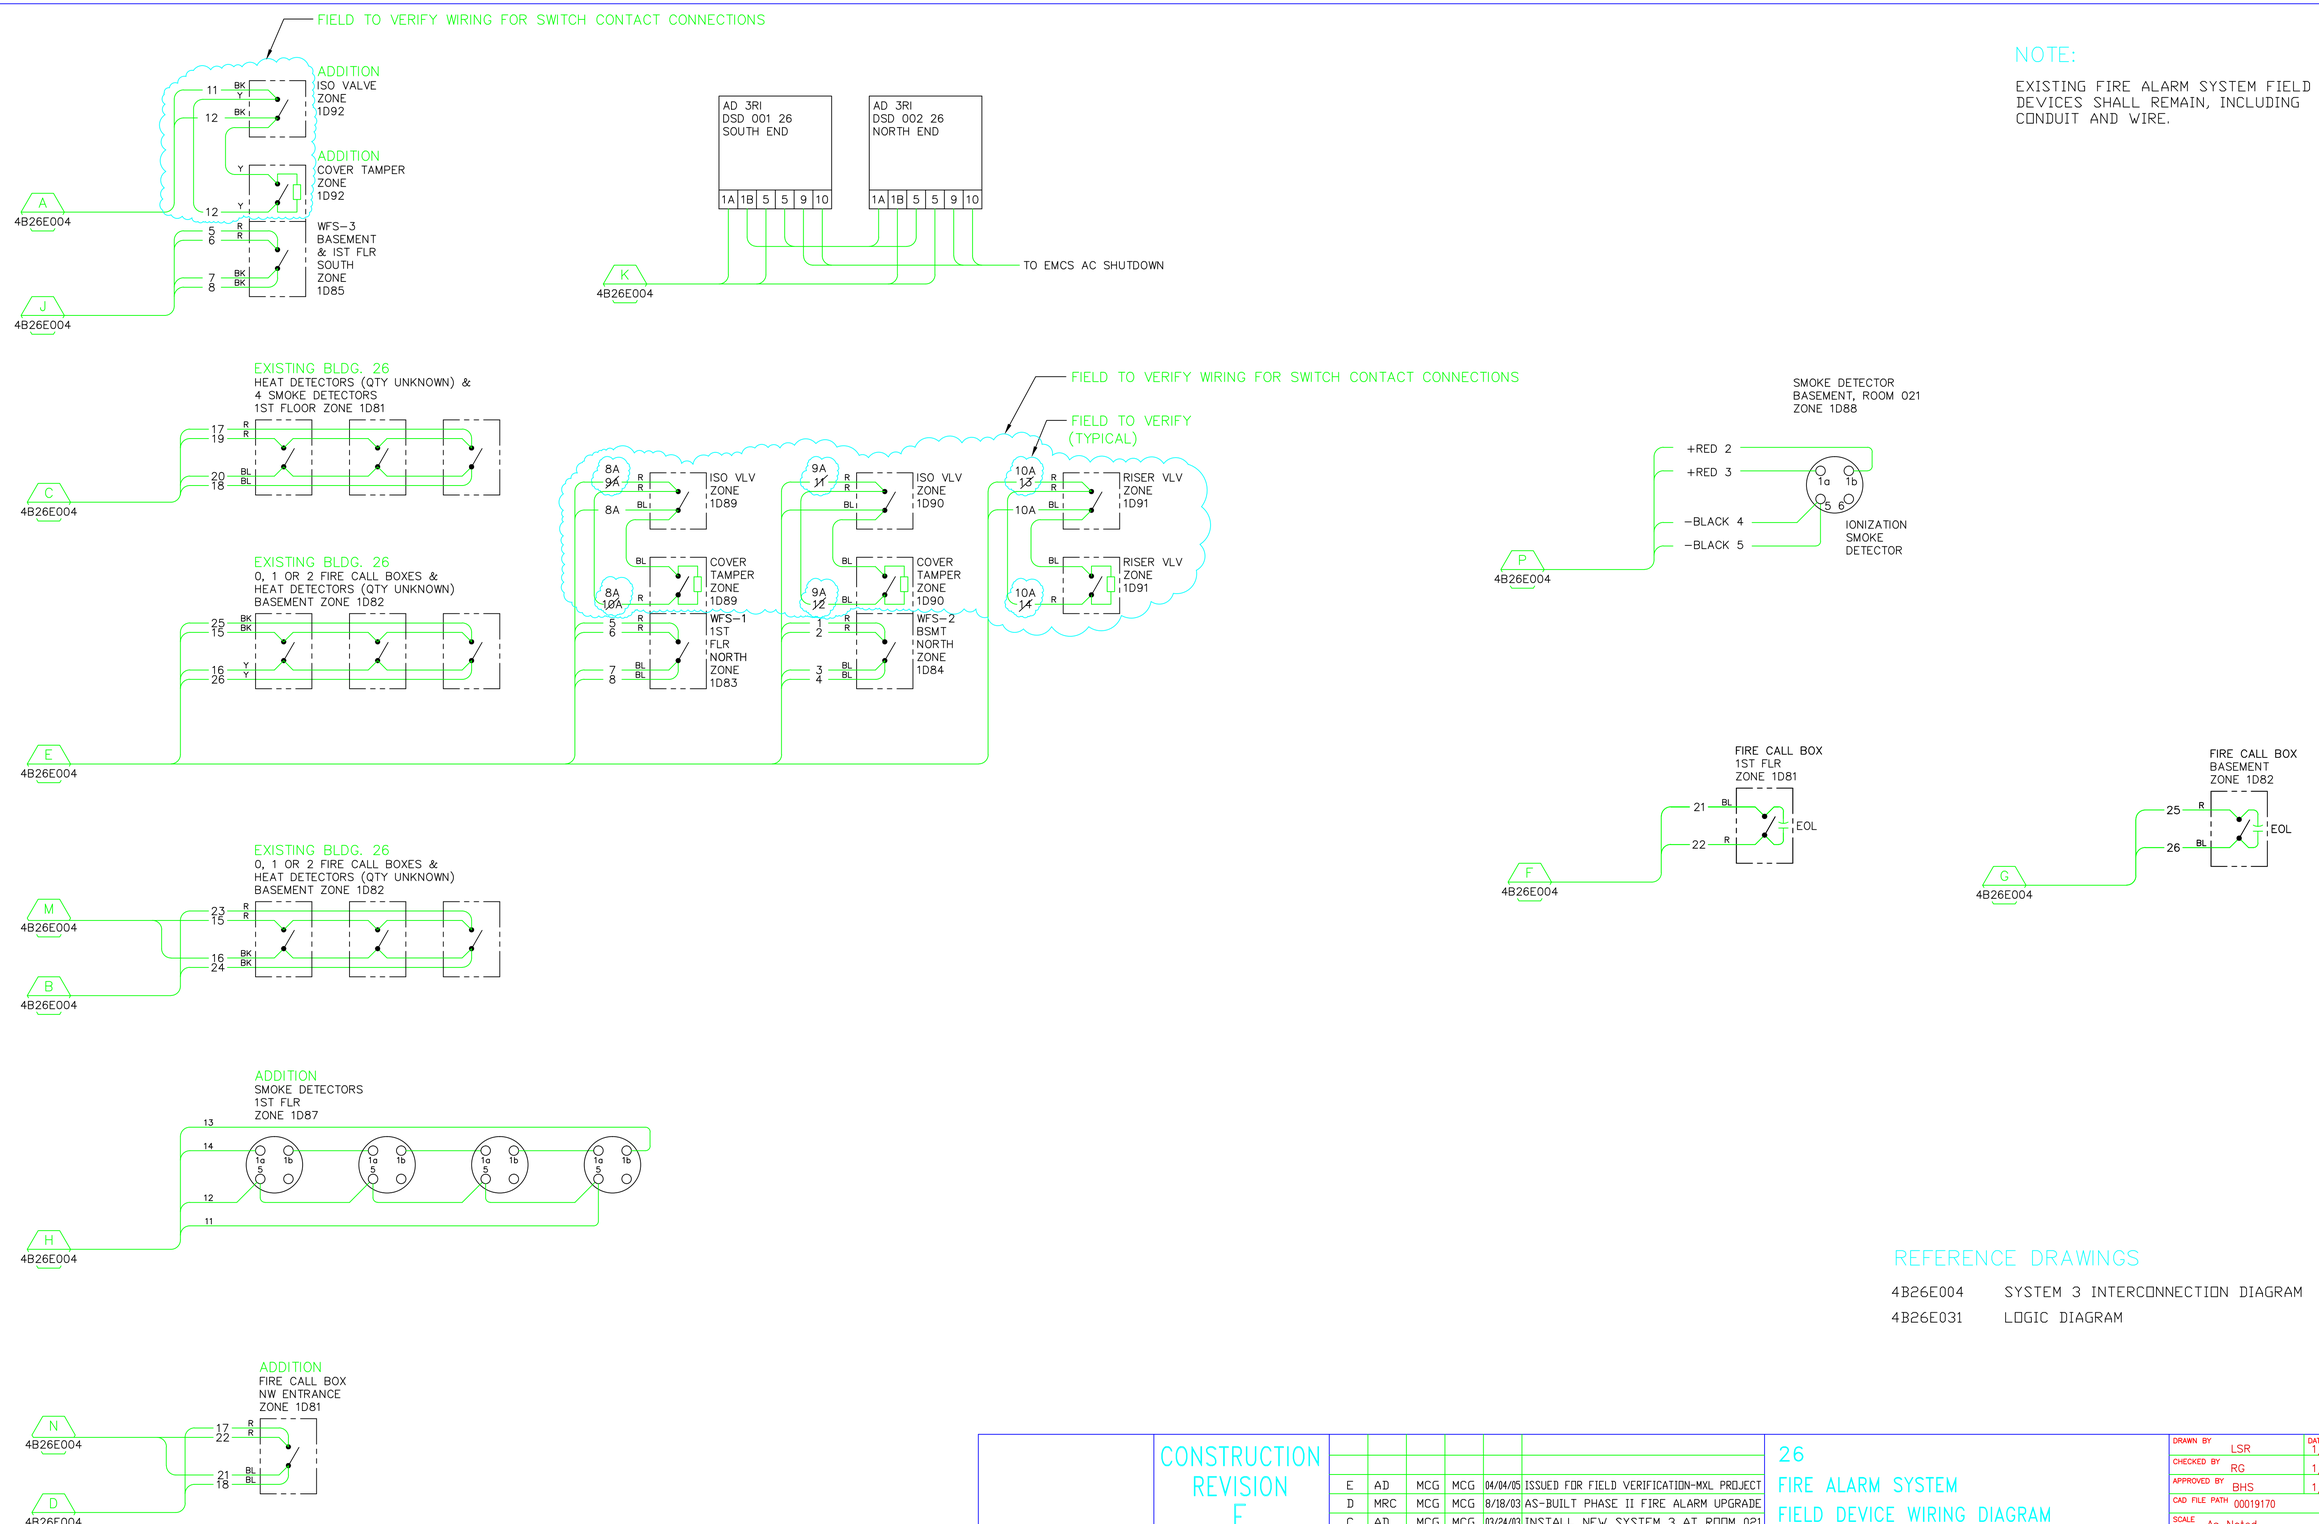

NOTE:

EXISTING FIRE ALARM SYSTEM FIELD DEVICES SHALL REMAIN, INCLUDING CONDUIT AND WIRE.

REFERENCE DRAWINGS

4B26E004	SYSTEM 3 INTERCONNECTION DIAGRAM
4B26E031	LOGIC DIAGRAM

CONSTRUCTION REVISION E 4/4/2005

REVISION NUMBER	DRAWN BY	CHECKED BY	APPR'D BY	DATE	REMARKS
E	AD	MCG	MCG	04/04/05	ISSUED FOR FIELD VERIFICATION-MXL PROJECT
D	MRC	MCG	MCG	8/18/03	AS-BUILT PHASE II FIRE ALARM UPGRADE
C	AD	MCG	MCG	03/24/03	INSTALL NEW SYSTEM 3 AT ROOM 021
B	HYT	-	-	-	FIRE ALARM REPLACEMENT PROJECT
A	LSR	JEH	ROB	10/19/93	REDRAWN ON AUTO CAD AS-BUILT

PROFESSIONAL SEAL (IF REVISION, APPLIES ONLY TO REVISED WORK)

ISSUE (PROGRESS, ESTIMATE, BID, CONSTRUCTION, CONFORMED, REVISION, RECORD)

26
FIRE ALARM SYSTEM
FIELD DEVICE WIRING DIAGRAM

UNIVERSITY OF CALIFORNIA
LAWRENCE BERKELEY NATIONAL LABORATORY
FACILITIES DIVISION

DRAWN BY	LSR	DATE 1/7/1986
CHECKED BY	RG	1/7/1986
APPROVED BY	BHS	1/7/1986
CAD FILE PATH	00019170	
SCALE	As Noted	
DRAWING NO.	4B26E010E	SHEET 1 OF 1
PROJECT NO.	FA8040	