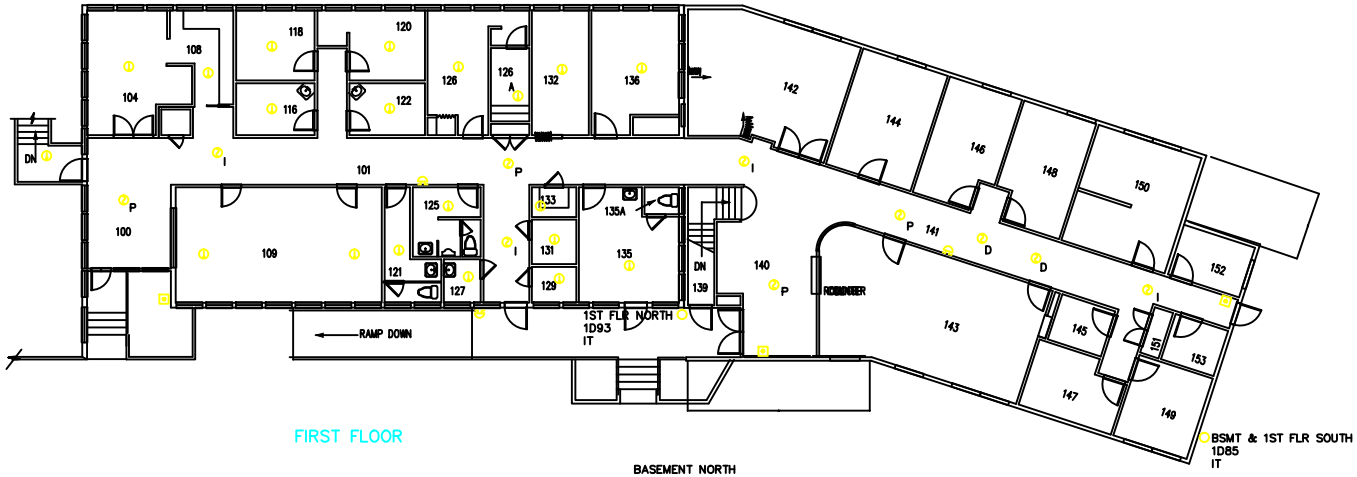

FIRST FLOOR

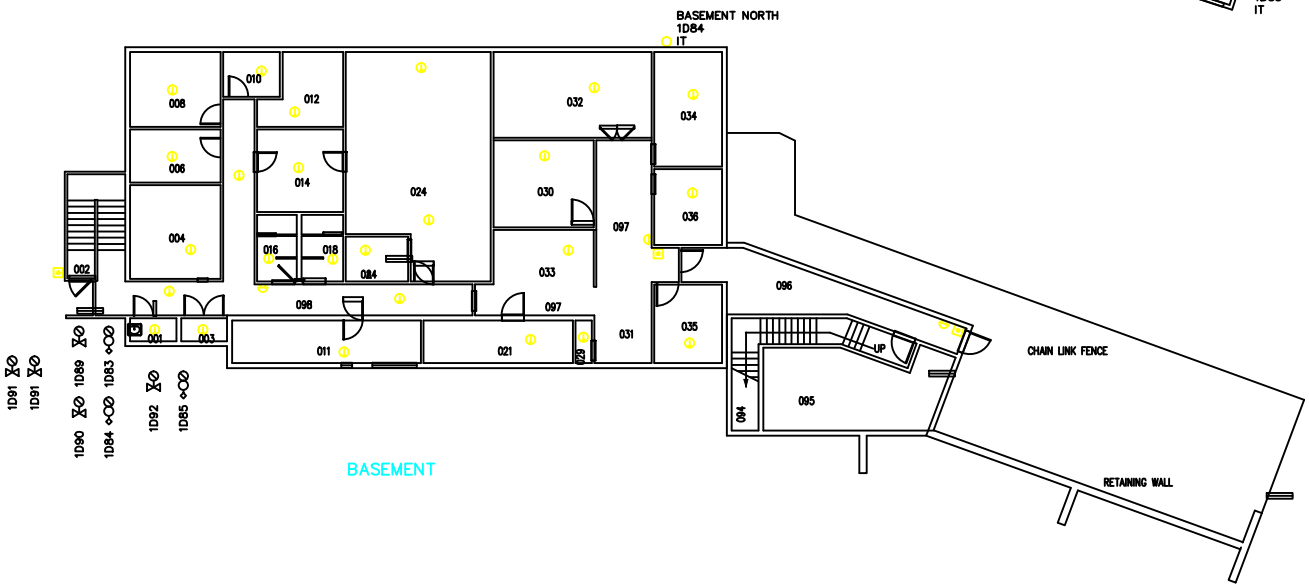

BASEMENT

FIRE ALARM SYMBOLS

- MANUAL STATION (CALL POINT) (BASIC SYMBOL)
- MANUAL ALARM BOX (PULL STATION AND PULL BOX)
- TELEPHONE STATION (TELEPHONE CALL POINT)
- AUTOMATIC DETECTION AND SUPERVISORY DEVICES (BASIC SYMBOL)
- HEAT DETECTOR (THERMAL DETECTOR) INCLUDES FIXED TEMPERATURE, RATE COMPENSATION, AND RATE-OF-RISE DETECTORS
- SMOKE DETECTOR INCLUDES PHOTOELECTRIC AND IONIZATION TYPE DETECTORS
- GAS DETECTOR
- FLAME DETECTOR (FLICKER DETECTOR) INCLUDES ULTRAVIOLET, INFRARED AND VISIBLE RADIATION TYPE DETECTORS
- FLOW DETECTOR/SWITCH
- PRESSURE DETECTOR/SWITCH
- LEVEL DETECTOR/SWITCH
- TAMPER DETECTOR/SWITCH
- VALVE WITH TAMPER DETECTOR/SWITCH
- SPEAKER/HORN (ELECTRIC HORN)
- BELL (GONG)
- HORN WITH LIGHT
- ILLUMINATED EXIT SIGN
- ILLUMINATED EXIT SIGN WITH DIRECTION ARROW

REFERENCE DRAWINGS

1. 4B26E004 SYS 3 WIRING AND ELEVATION
2. 4B26E010 LOGIC AND DEVICE WIRING
3. 4B00E255 FIRE ALARM LOOPS – SOUTH SECTION

0 5 10 20

N

REVISION NUMBER	DRAWN BY	CHECKED BY	APPR'D BY	DATE	REMARKS
A	LSR	JEH	RGB	10/30/90	REDRAWN ON AUTOCAD AS-BUILT

26
FIRE ALARM SYSTEM
BASEMENT & 1ST FLOOR PLAN

UNIVERSITY OF CALIFORNIA
LAWRENCE BERKELEY NATIONAL LABORATORY
FACILITIES DEPARTMENT

DRAWN BY	LSR	DATE 07/19/90
CHECKED BY	RG	07/19/90
APPROVED BY	RMG	10/30/90
CAD FILE PATH	00007700	
SCALE	As Noted	
DRAWING NO.	4B26E011A	SHEET 1 OF 1
PROJECT NO.	FAB040	