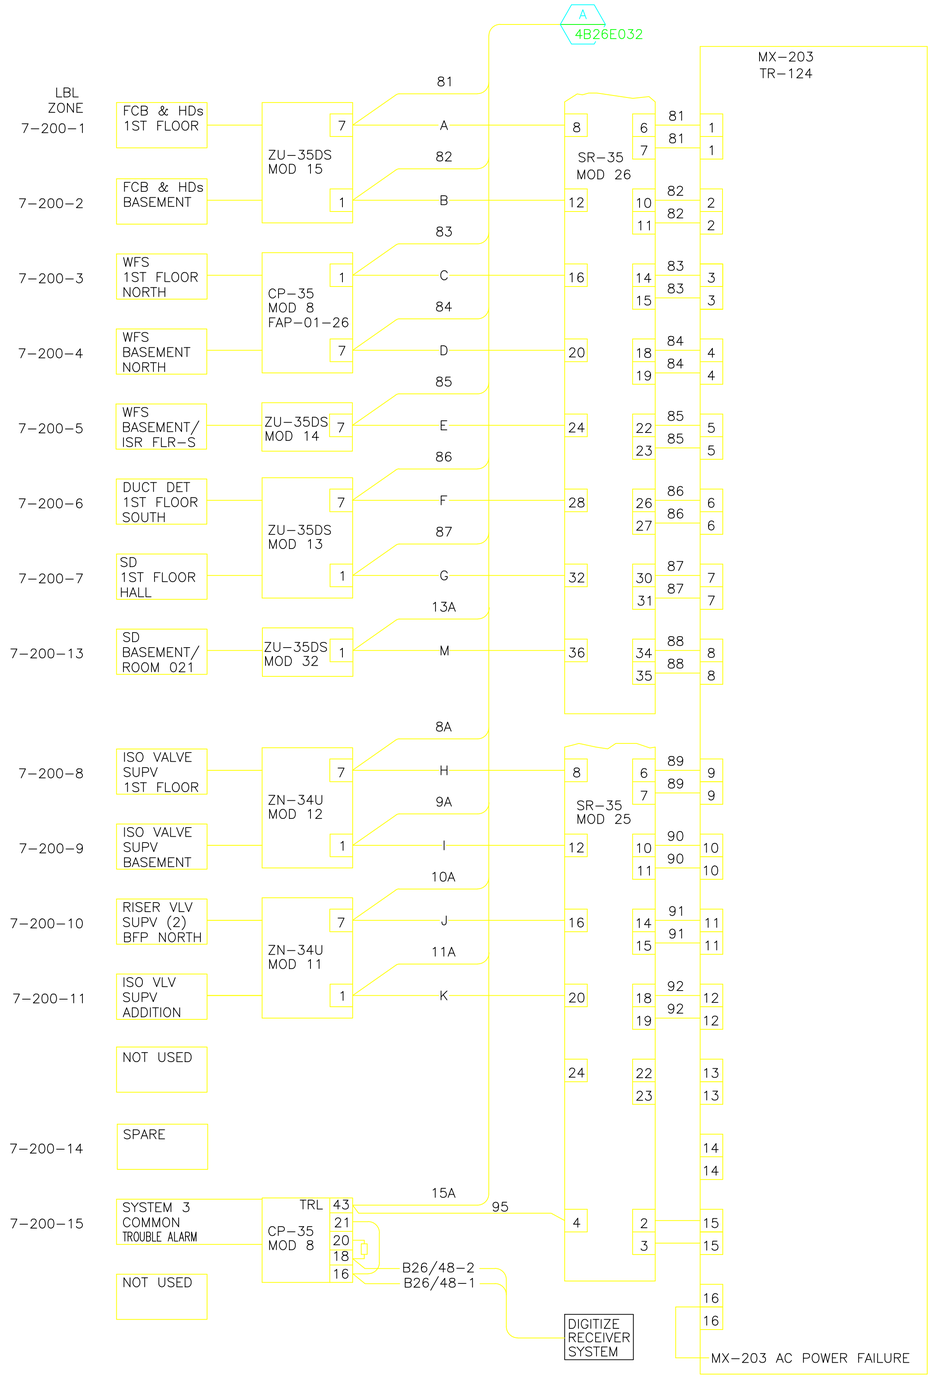

AS BUILT

E

4/29/2013

REVISION NUMBER	DRAWN BY	CHECKED BY	APPR'D BY	DATE	REMARKS
E	LDD	LDD	MCD	04/29/13	AS BUILT PER FIELD VERIFICATIONS
D	AD	MCG	MCG	04/01/05	MODIFIED FOR DIGITIZE SYSTEM
C	MRC	MCG	MCG	8/18/03	AS-BUILT PHASE II FIRE ALARM UPGRADE
B	AD	MCG	MCG	05/30/03	INSTALL NEW SYS 3 PANEL AT RM 021 & CONNECT (E) & (N) MOD'S
A	HYT	HYT			

PROFESSIONAL SEAL (IF REVISION, APPLIES ONLY TO REVISED WORK)

ISSUE (PROGRESS, ESTIMATE, BID, CONSTRUCTION, CONFORMED, REVISION, RECORD)

26 BLDG 26

REPLACEMENT FIRE ALARM SYSTEM

LOGIC DIAGRAM

UNIVERSITY OF CALIFORNIA
LAWRENCE BERKELEY NATIONAL LABORATORY
FACILITIES DIVISION

DRAWN BY	HYT	DATE 3/30/2001
CHECKED BY	HYT	3/30/2001
APPROVED BY		1/2/2020
CAD FILE PATH		
SCALE	Full	
DRAWING NO.	4B26E031E	SHEET
PROJECT NO.	FA8040	1 OF 1