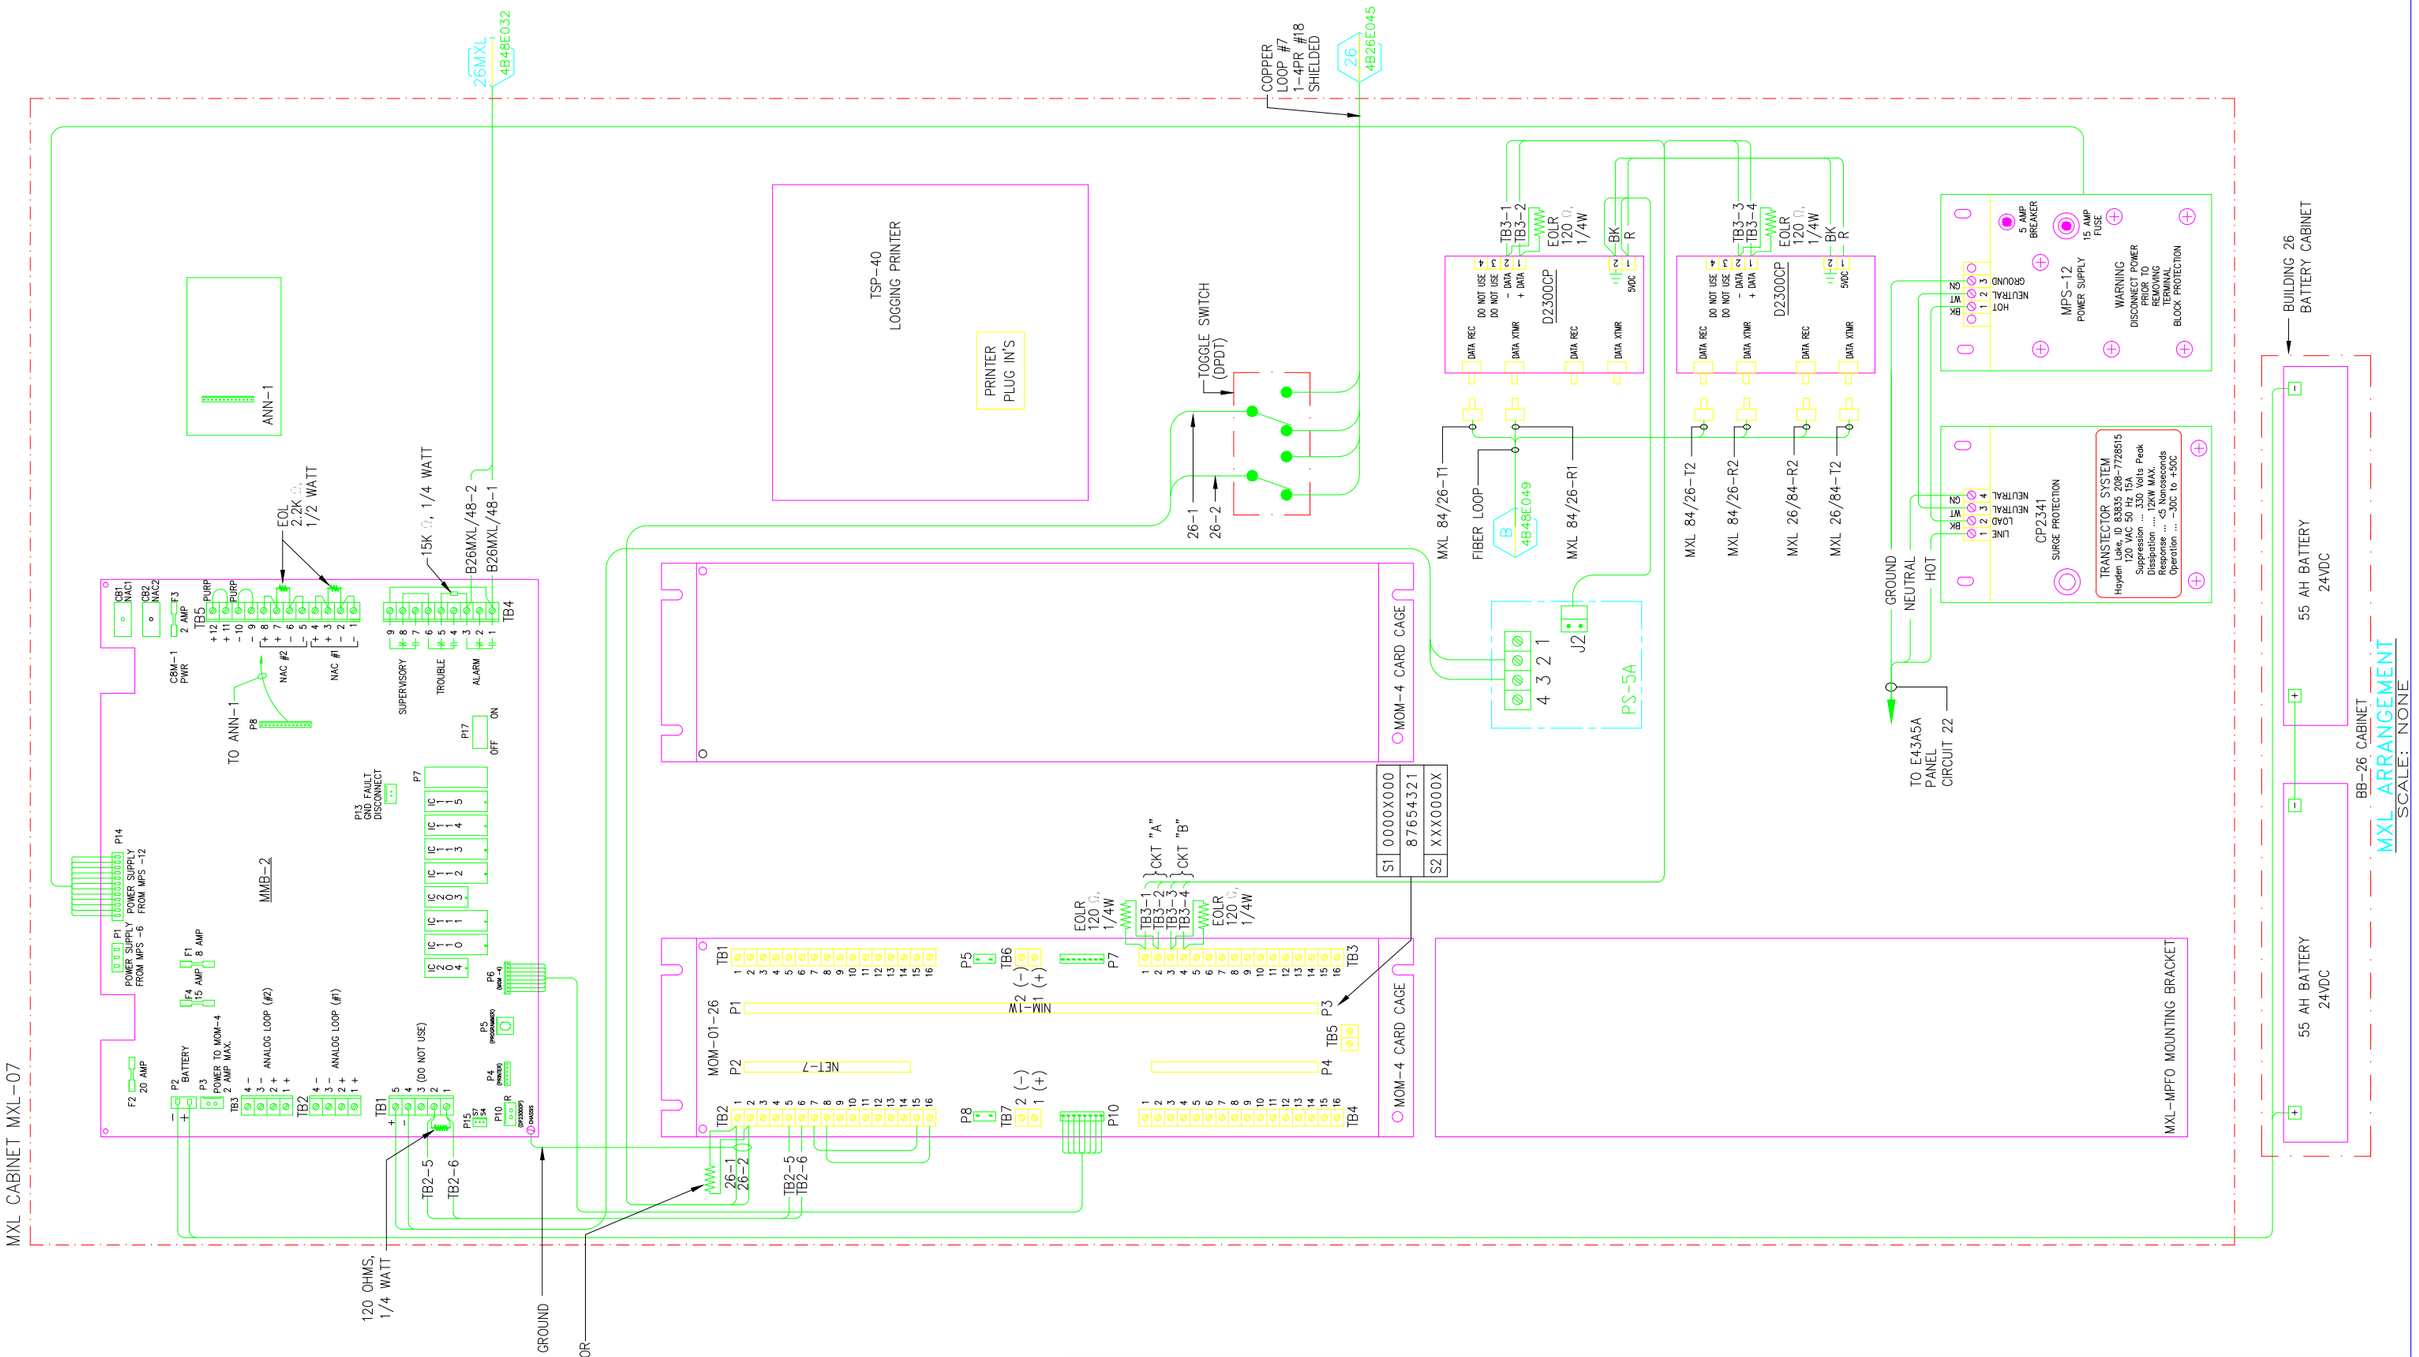

AS BUILT

G

4/29/2013

PROFESSIONAL SEAL (IF REVISION, APPLIES ONLY TO REVISED WORK)

ISSUE (PROGRESS, ESTIMATE, BID, CONSTRUCTION, CONFORMED, REVISION, RECORD)

REVISION NUMBER	DRAWN BY	CHECKED BY	APPR'D BY	DATE	REMARKS
G	LDD	LDD	MCD	04/29/13	AS BUILT PER FIELD VERIFICATIONS
F	AD	LDD	MCD	06/06/06	REVISED FOR MXL COPPER LOOP
E	AD	MCG	MCG	12/05/05	REVISED PER SIEMENS REVIEW
D	AD	MCG	MCG	04/06/05	ADDED FIBER & COOPER LOOPS FOR MXL
C	MRC	MCG	MCG	08/18/03	AS-BUILT PHASE II FIRE ALARM UPGRADE
B	AD	MCG	MCG	06/14/05	REVISED FOR MXL INSTALLATION
A	VDA	MCG	MCG	03/30/04	REVISE BLDG 28 FA SYSTEM TO BLDG 26 FAP-01-26 PNL

26 FIRE ALARM

MXL FIRE ALARM SYSTEM, LOOP 7

FAP ARRANGEMENT/WIRNG DIAGRAM

UNIVERSITY OF CALIFORNIA
LAWRENCE BERKELEY NATIONAL LABORATORY
FACILITIES DIVISION

DRAWN BY	HYT	DATE	3/20/2002
CHECKED BY	HYT		3/20/2002
APPROVED BY	–		
CAD FILE PATH			
SCALE	As Noted		
DRAWING NO.	4B26E036G	SHEET	1 OF 1
PROJECT NO.	FE5200		