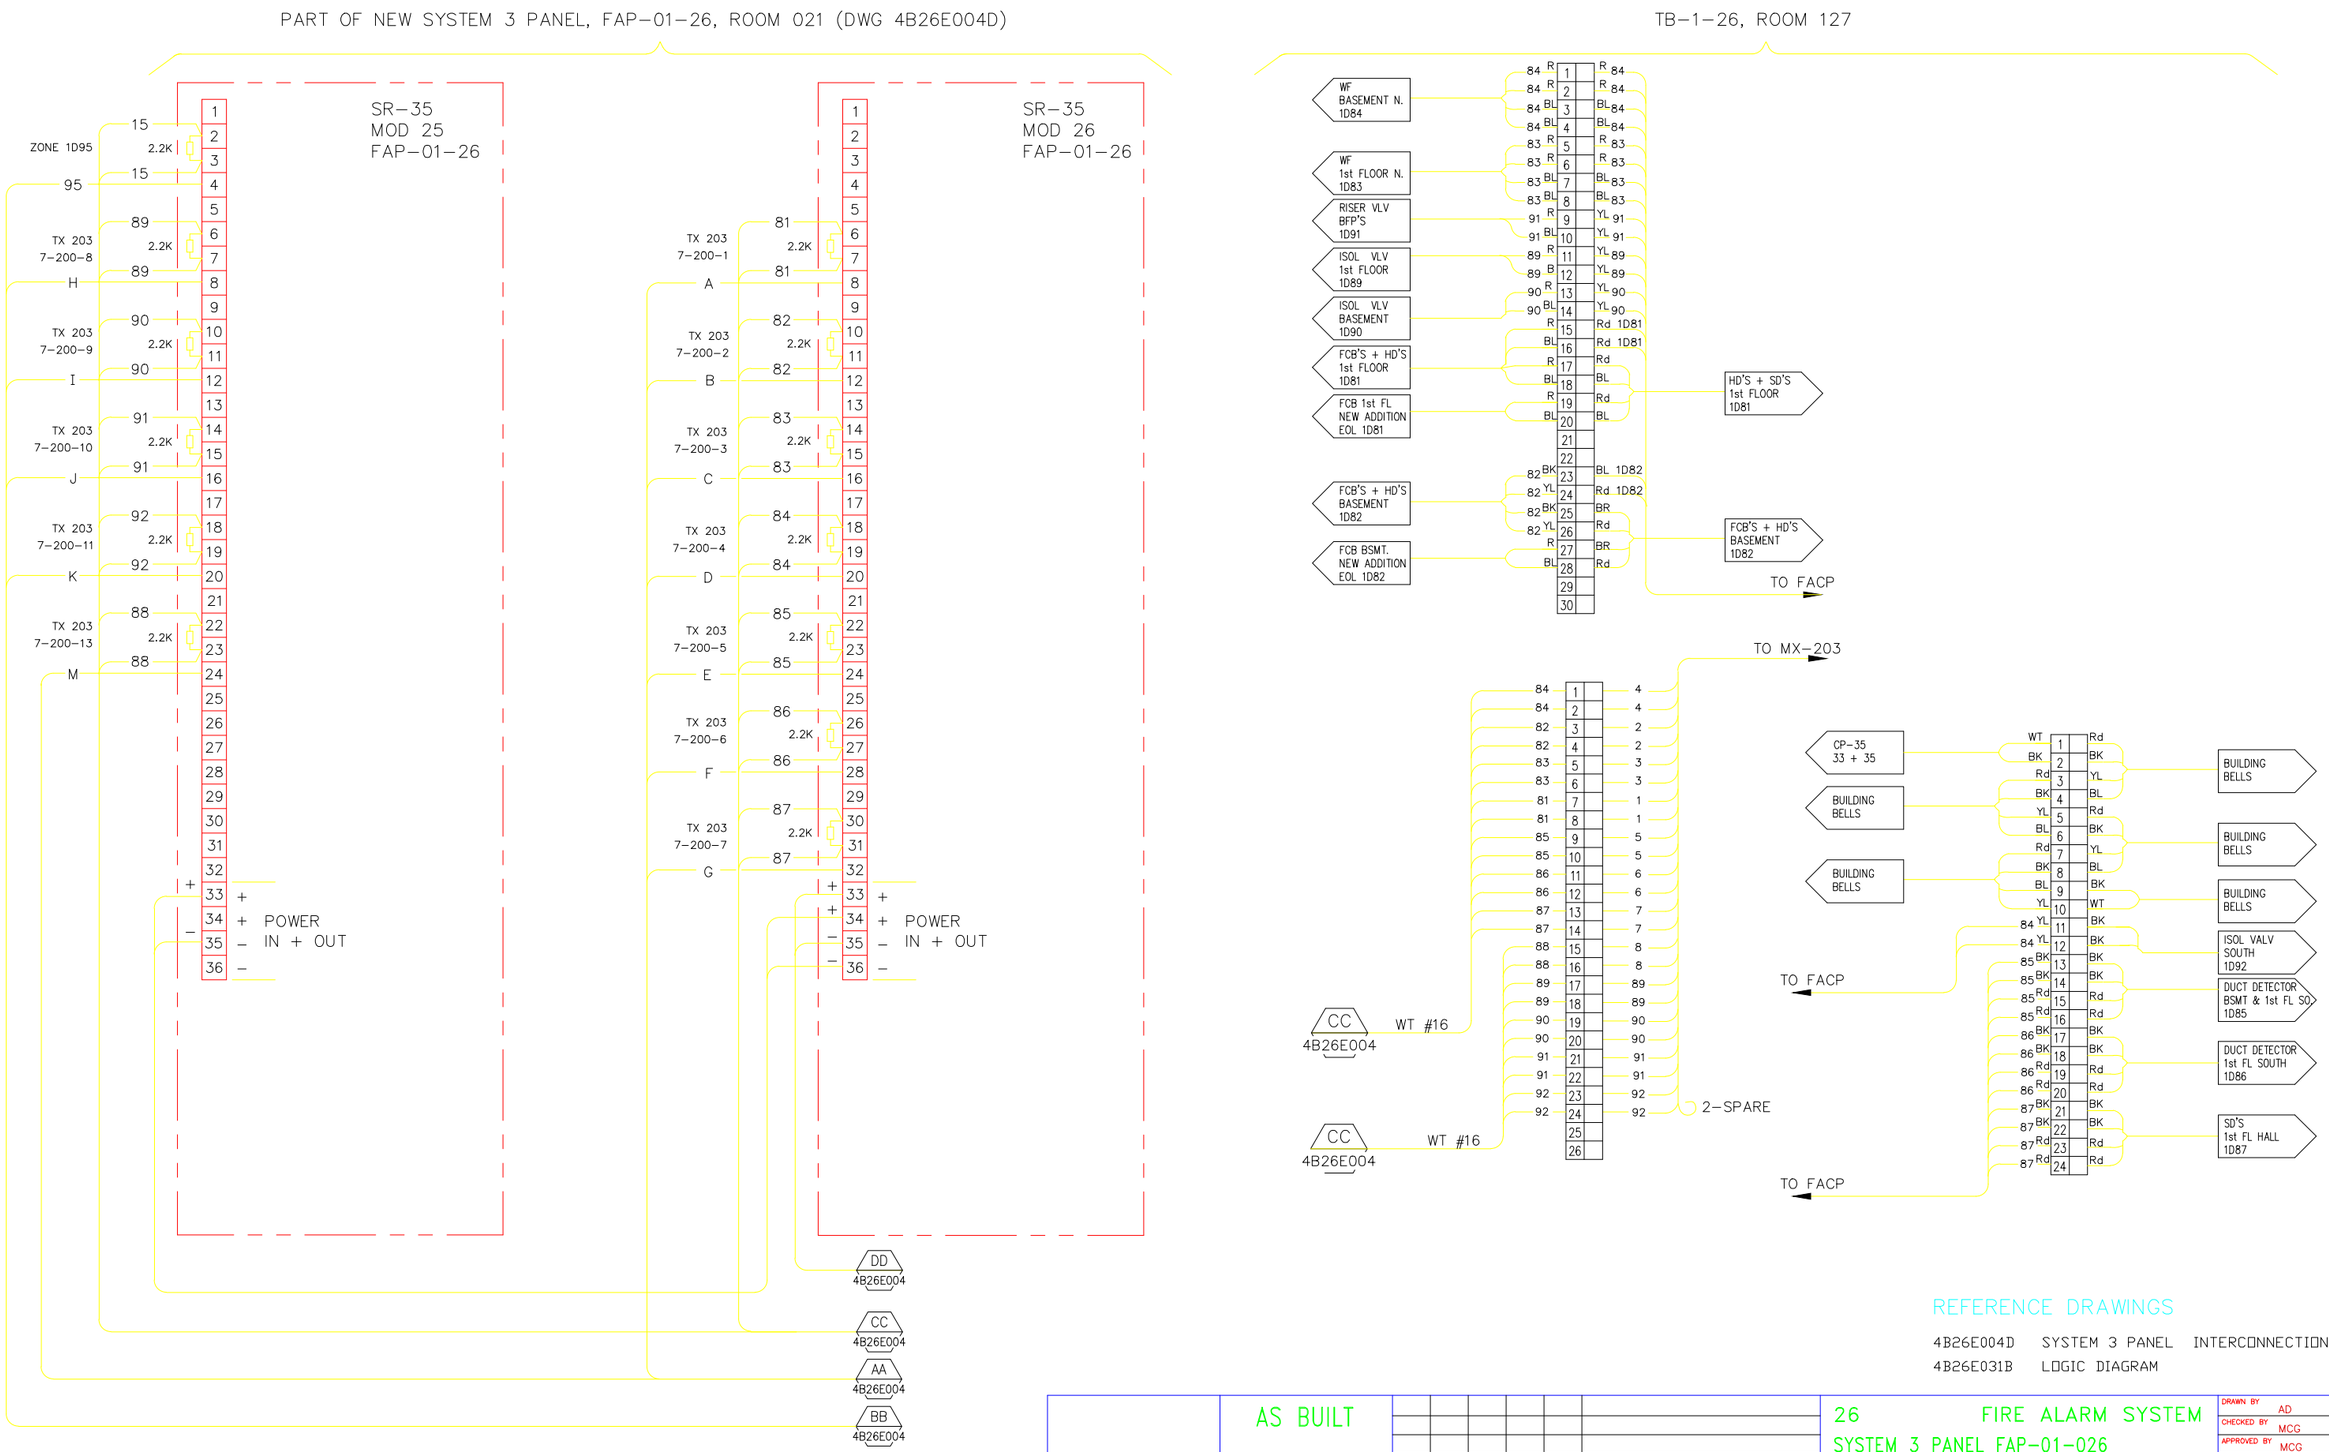

REFERENCE DRAWINGS

4B26E004D SYSTEM 3 PANEL INTERCONNECTION DIAGRAM
4B26E031B LOGIC DIAGRAM

AS BUILT
C
4/29/2013

REVISION NUMBER	DRAWN BY	CHECKED BY	APPR'D BY	DATE	REMARKS
C	LDD	LDD	MCD	04/29/13	AS BUILT PER FIELD VERIFICATIONS
B	AD	MCG	MCG	04/01/05	MODIFIED FOR DIGITIZE SYSTEM
A	MRC	AD	MCG	08/18/03	AS-BUILT, PHASE II "FA" UPGRADE

PROFESSIONAL SEAL (IF REVISION, APPLIES ONLY TO REVISED WORK)
ISSUE (PROGRESS, ESTIMATE, BID, CONSTRUCTION, CONFORMED, REVISION, RECORD)

26 FIRE ALARM SYSTEM
SYSTEM 3 PANEL FAP-01-026
SR-35 CONNECTION DIAGRAM

UNIVERSITY OF CALIFORNIA
LAWRENCE BERKELEY NATIONAL LABORATORY
FACILITIES DIVISION

DRAWN BY AD	DATE 3/25/200	
CHECKED BY MCG	3/26/200	
APPROVED BY MCG	4/9/2003	
CAD FILE PATH		
SCALE Full		
DRAWING NO. 4B26E041C	SHEET 1 OF 1	
PROJECT NO. FA8040		