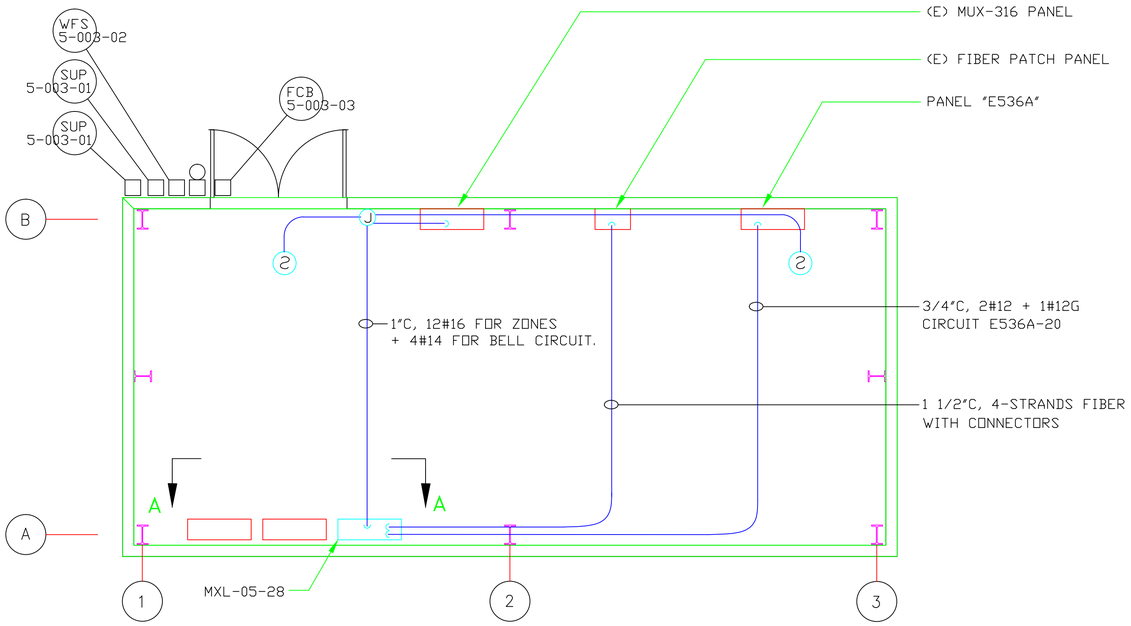

PLAN – BUILDING 28

(NOT TO SCALE)

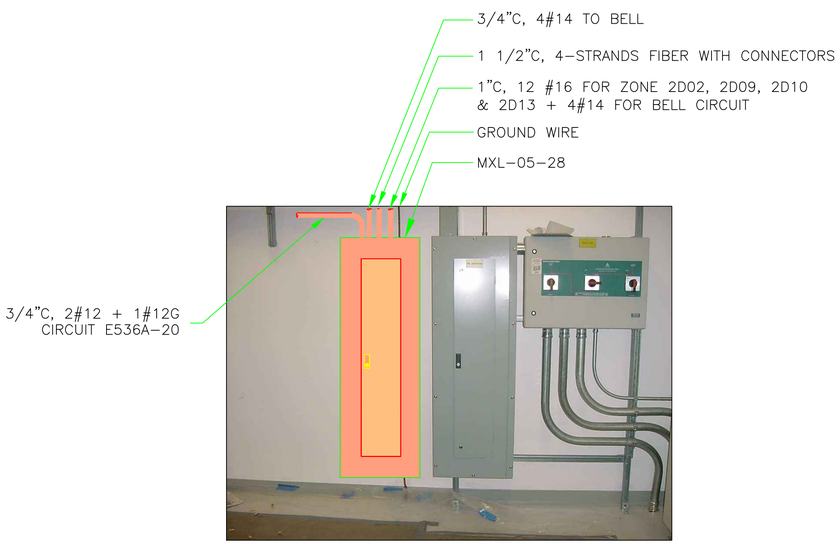

SECTION A-A

NOT TO SCALE

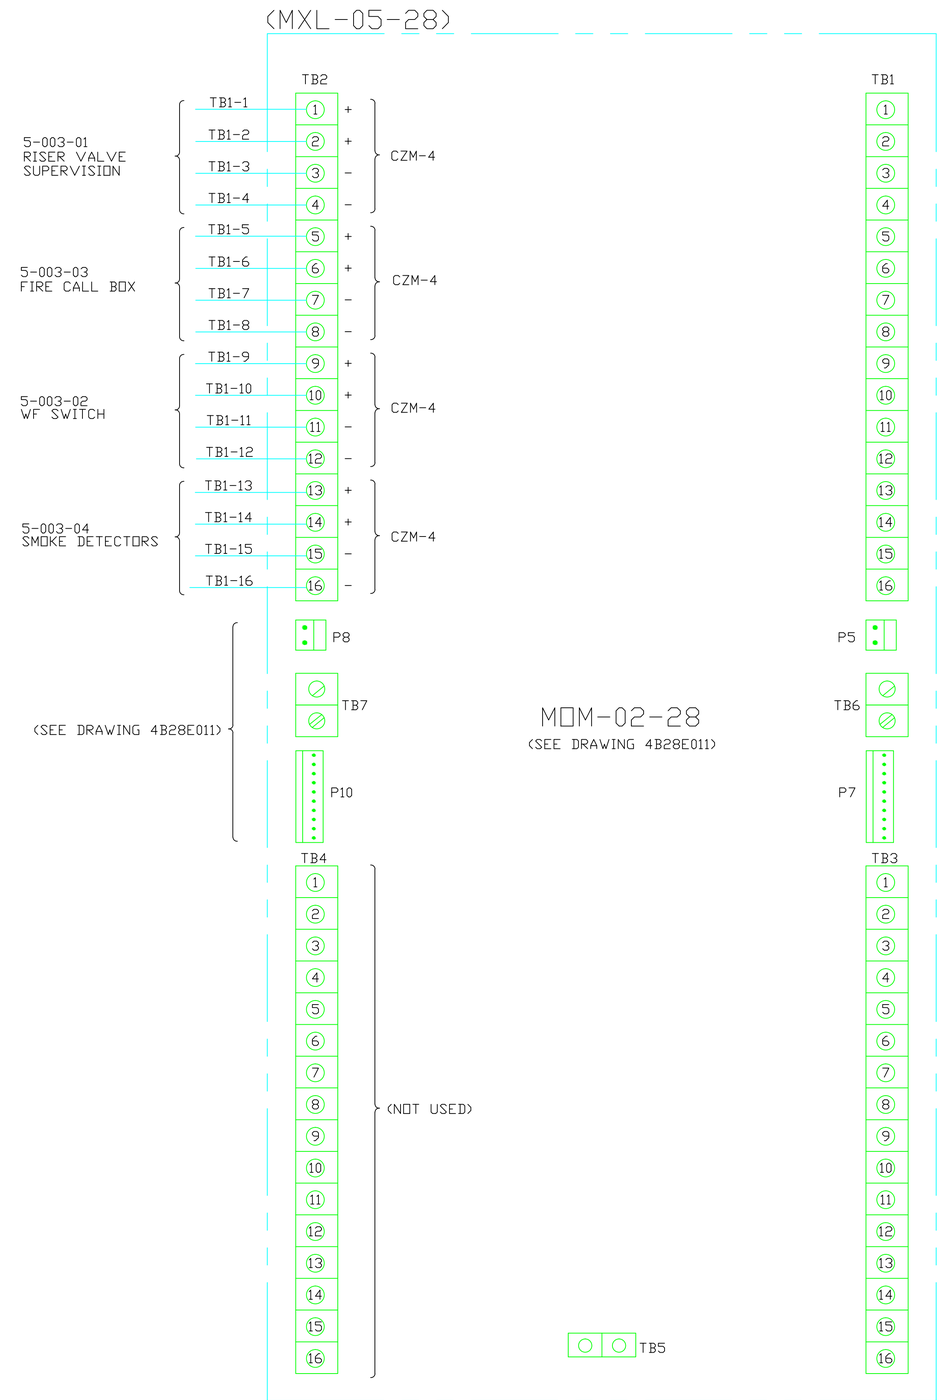

OLD ADDRESS	DESCRIPTION	MID-16 TERMINATION	MODULE TYPE & NO.	MXL-05-28 ADDRESS
2D02	RISER VALVE SUPERVISION	TB2,TERMINALS 1,2,3,4	CZM-4	5-003-01
2D10	FIRE CALL BOX	TB2,TERMINALS 5,6,7,8	CZM-4	5-003-03
2D09	WF SWITCH	TB2,TERMINALS 9,10,11,12	CZM-4	5-003-02
2D13	SMOKE DETECTOR	TB2,TERMINALS 13,14,15,16	CZM-4	5-003-04

REVISION NUMBER	DRAWN BY	CHECKED BY	APPR'D BY	DATE	REMARKS
D	LDD	LDD	MCD	4/30/13	AS BUILT PER FIELD VERIFICATIONS
C	AD	LDD	MCD	7/08/06	REVISED FOR MXL COPPER LOOP
B	MRC	AD	MCG	6/24/04	PHASE III FIRE ALARM SYSTEM UPGRADE
A	VDA	MCG	MCG	3/30/04	REVISE B28 FA SYSTEM TO B26 FAP-01-26 PNL.

28 FIRE ALARM SYSTEM
MOM-4 CARD CAGE, LOOP 5
WIRING DIAGRAM, PLAN & SECTION

UNIVERSITY OF CALIFORNIA LAWRENCE BERKELEY LABORATORY
FACILITIES DEPARTMENT

		DATE
DRAWN BY	AD	6/24/2004
CHECKED BY	MCG	6/24/2004
APPROVED BY	MCG	6/24/2004
CAD FILE PATH		
SCALE	NONE	
DRAWING NO.	4B28E012D	
PROJECT NO.	FB4010	
SHEET	1 OF 1	