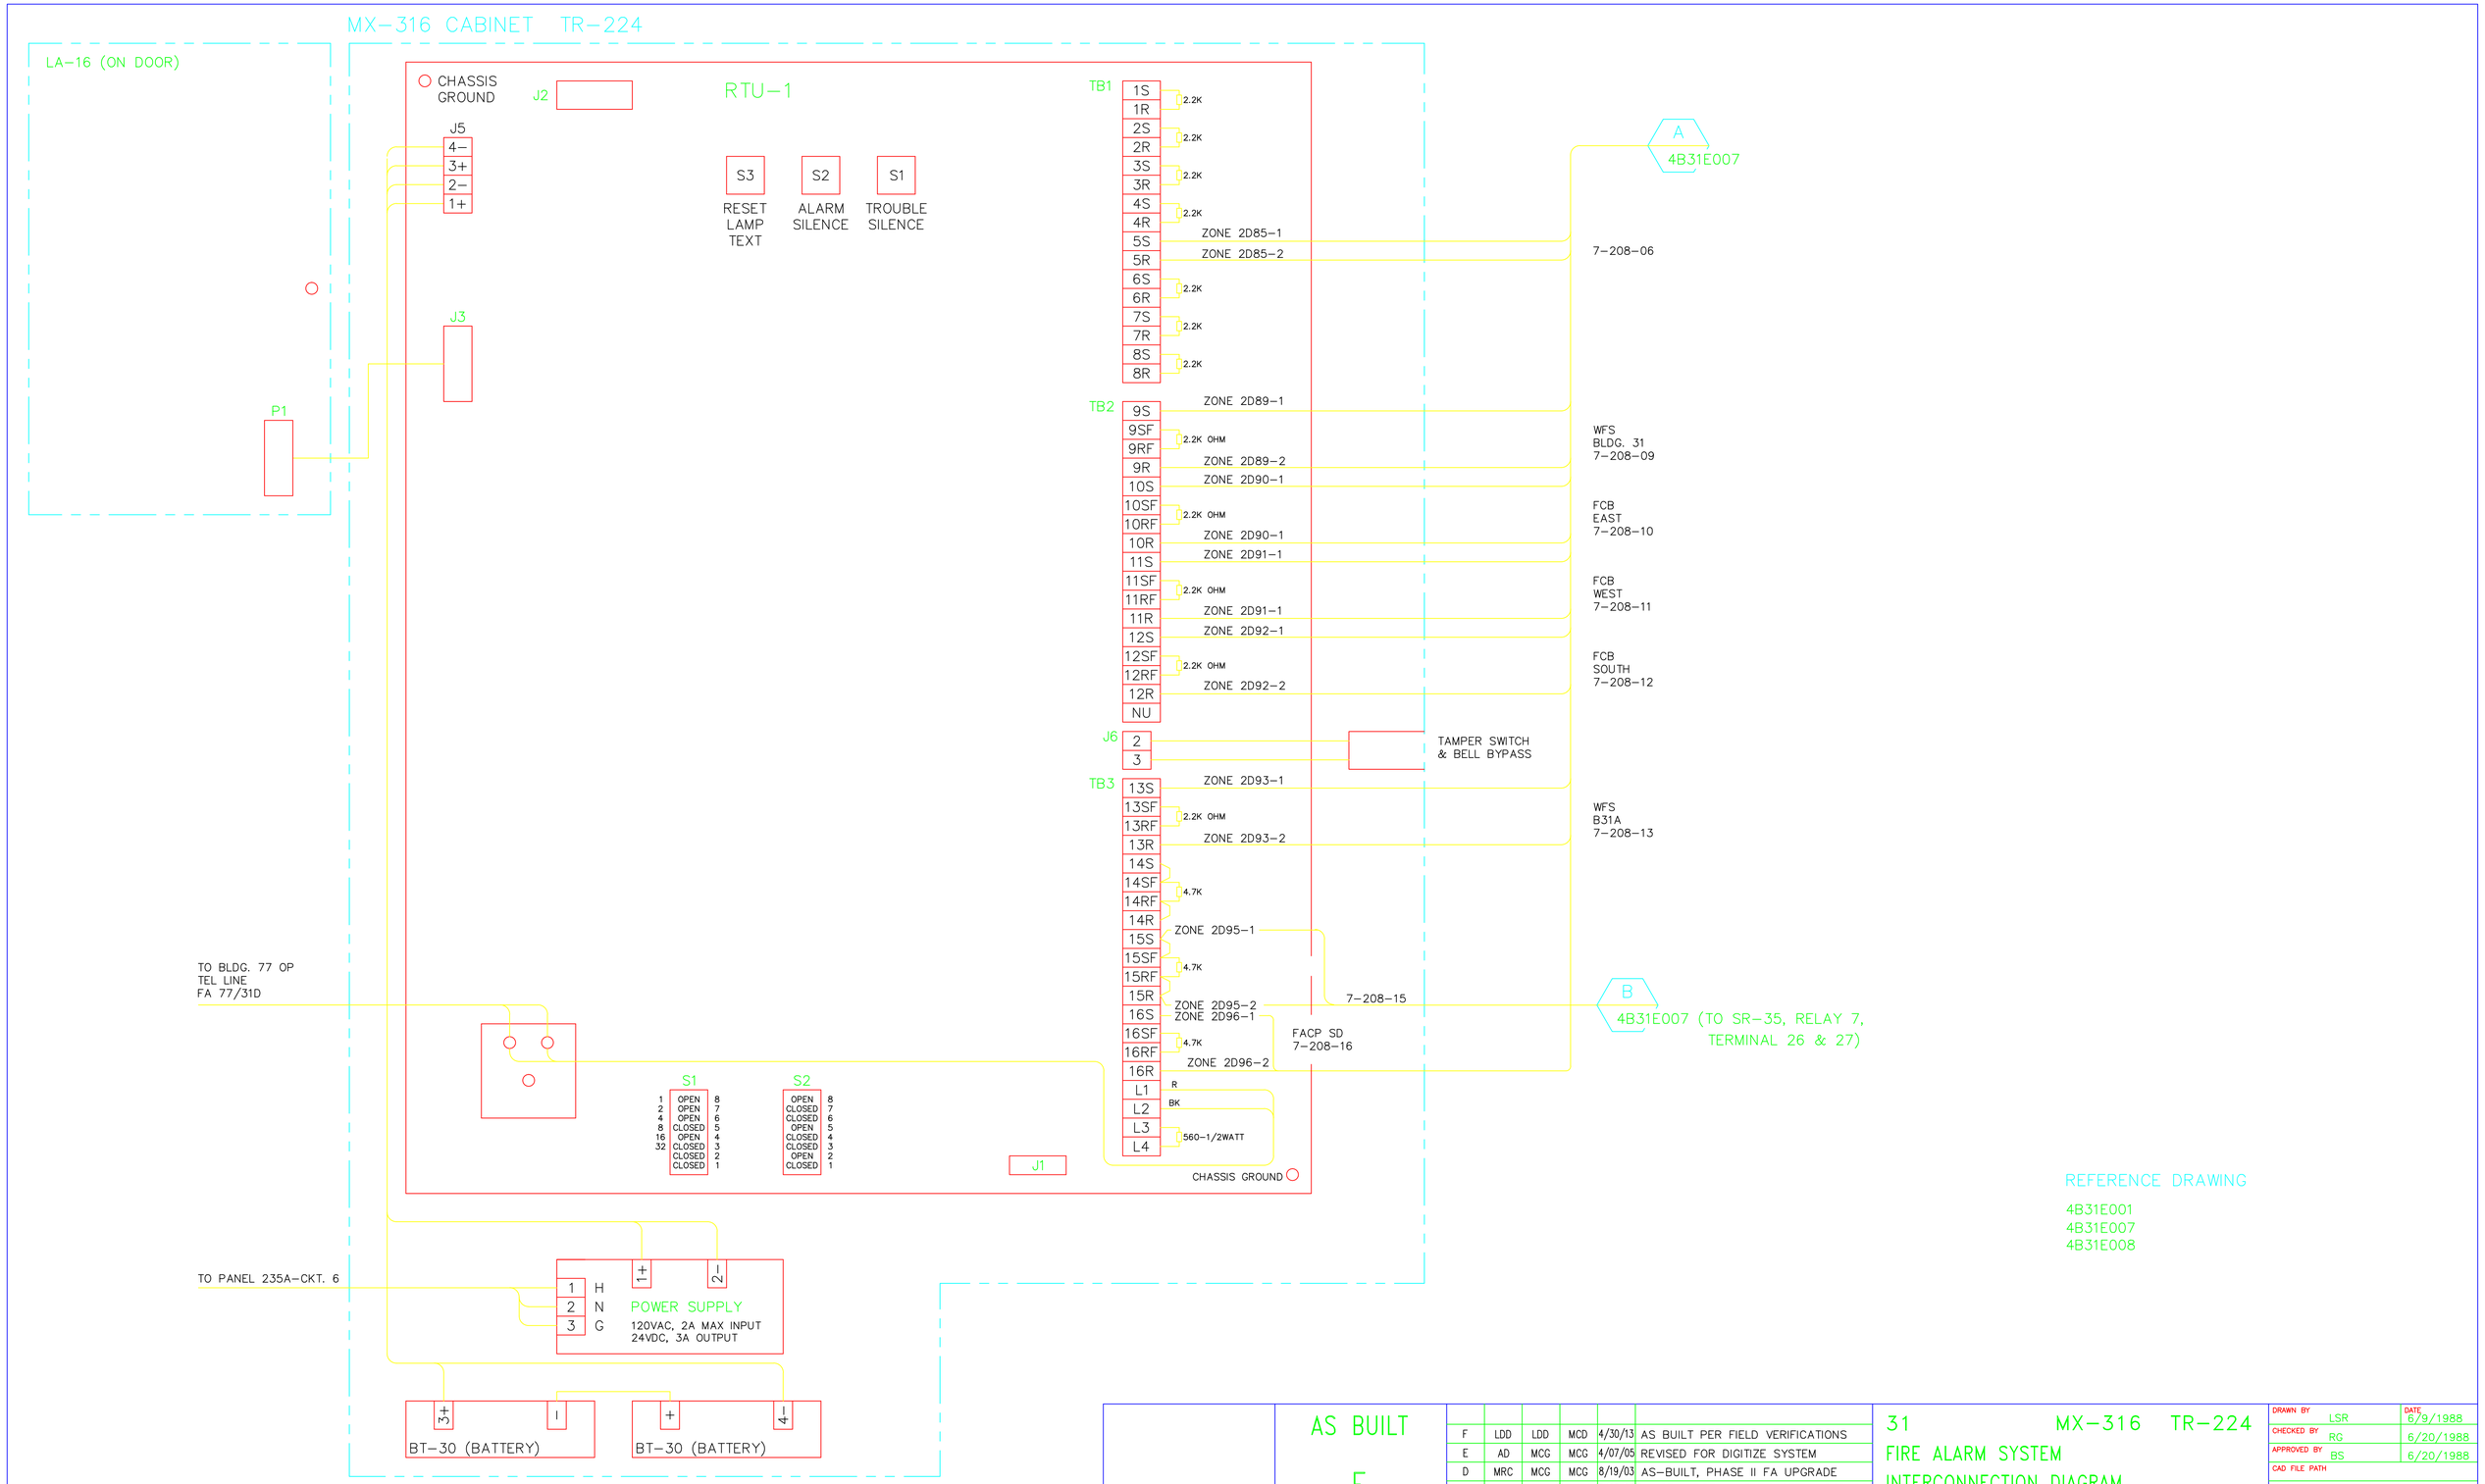


AS BUILT

F

4/30/2013

PROFESSIONAL SEAL (IF REVISION, APPLIES ONLY TO REVISED WORK)

ISSUE (PROGRESS, ESTIMATE, BID, CONSTRUCTION, CONFORMED, REVISION, RECORD)

| REVISION NUMBER | DRAWN BY | CHECKED BY | APPR'D BY | DATE | REMARKS |
|---|---|---|---|---|---|
| F | LDD | LDD | MCD | 4/30/13 | AS BUILT PER FIELD VERIFICATIONS |
| E | AD | MCG | MCG | 4/07/05 | REVISED FOR DIGITIZE SYSTEM |
| D | MRC | MCG | MCG | 8/19/03 | AS-BUILT, PHASE II FA UPGRADE |
| C | AD | MCG | MCG | 7/25/03 | PHASE II FIRE ALARM SYSTEM UPGRADE |
| B | LM | MCG | MCG | 6/25/98 | CONSTRUCTION COMPLETE, FIELD TO VERIFY |
| A | LSR | RB | RBaker | 6/9/94 | REDRAWN ON AUTOCAD, ADDED B31A |

31 MX-316 TR-224

FIRE ALARM SYSTEM

INTERCONNECTION DIAGRAM

UNIVERSITY OF CALIFORNIA
LAWRENCE BERKELEY NATIONAL LABORATORY
FACILITIES DIVISION

| | | DATE |
|---|---|---|
| DRAWN BY | LSR | 6/9/1988 |
| CHECKED BY | RG | 6/20/1988 |
| APPROVED BY | BS | 6/20/1988 |
| CAD FILE PATH | | |
| SCALE | As Noted | |
| DRAWING NO. | 4B31E003F | SHEET 1 OF 1 |
| PROJECT NO. | FA8040 | |