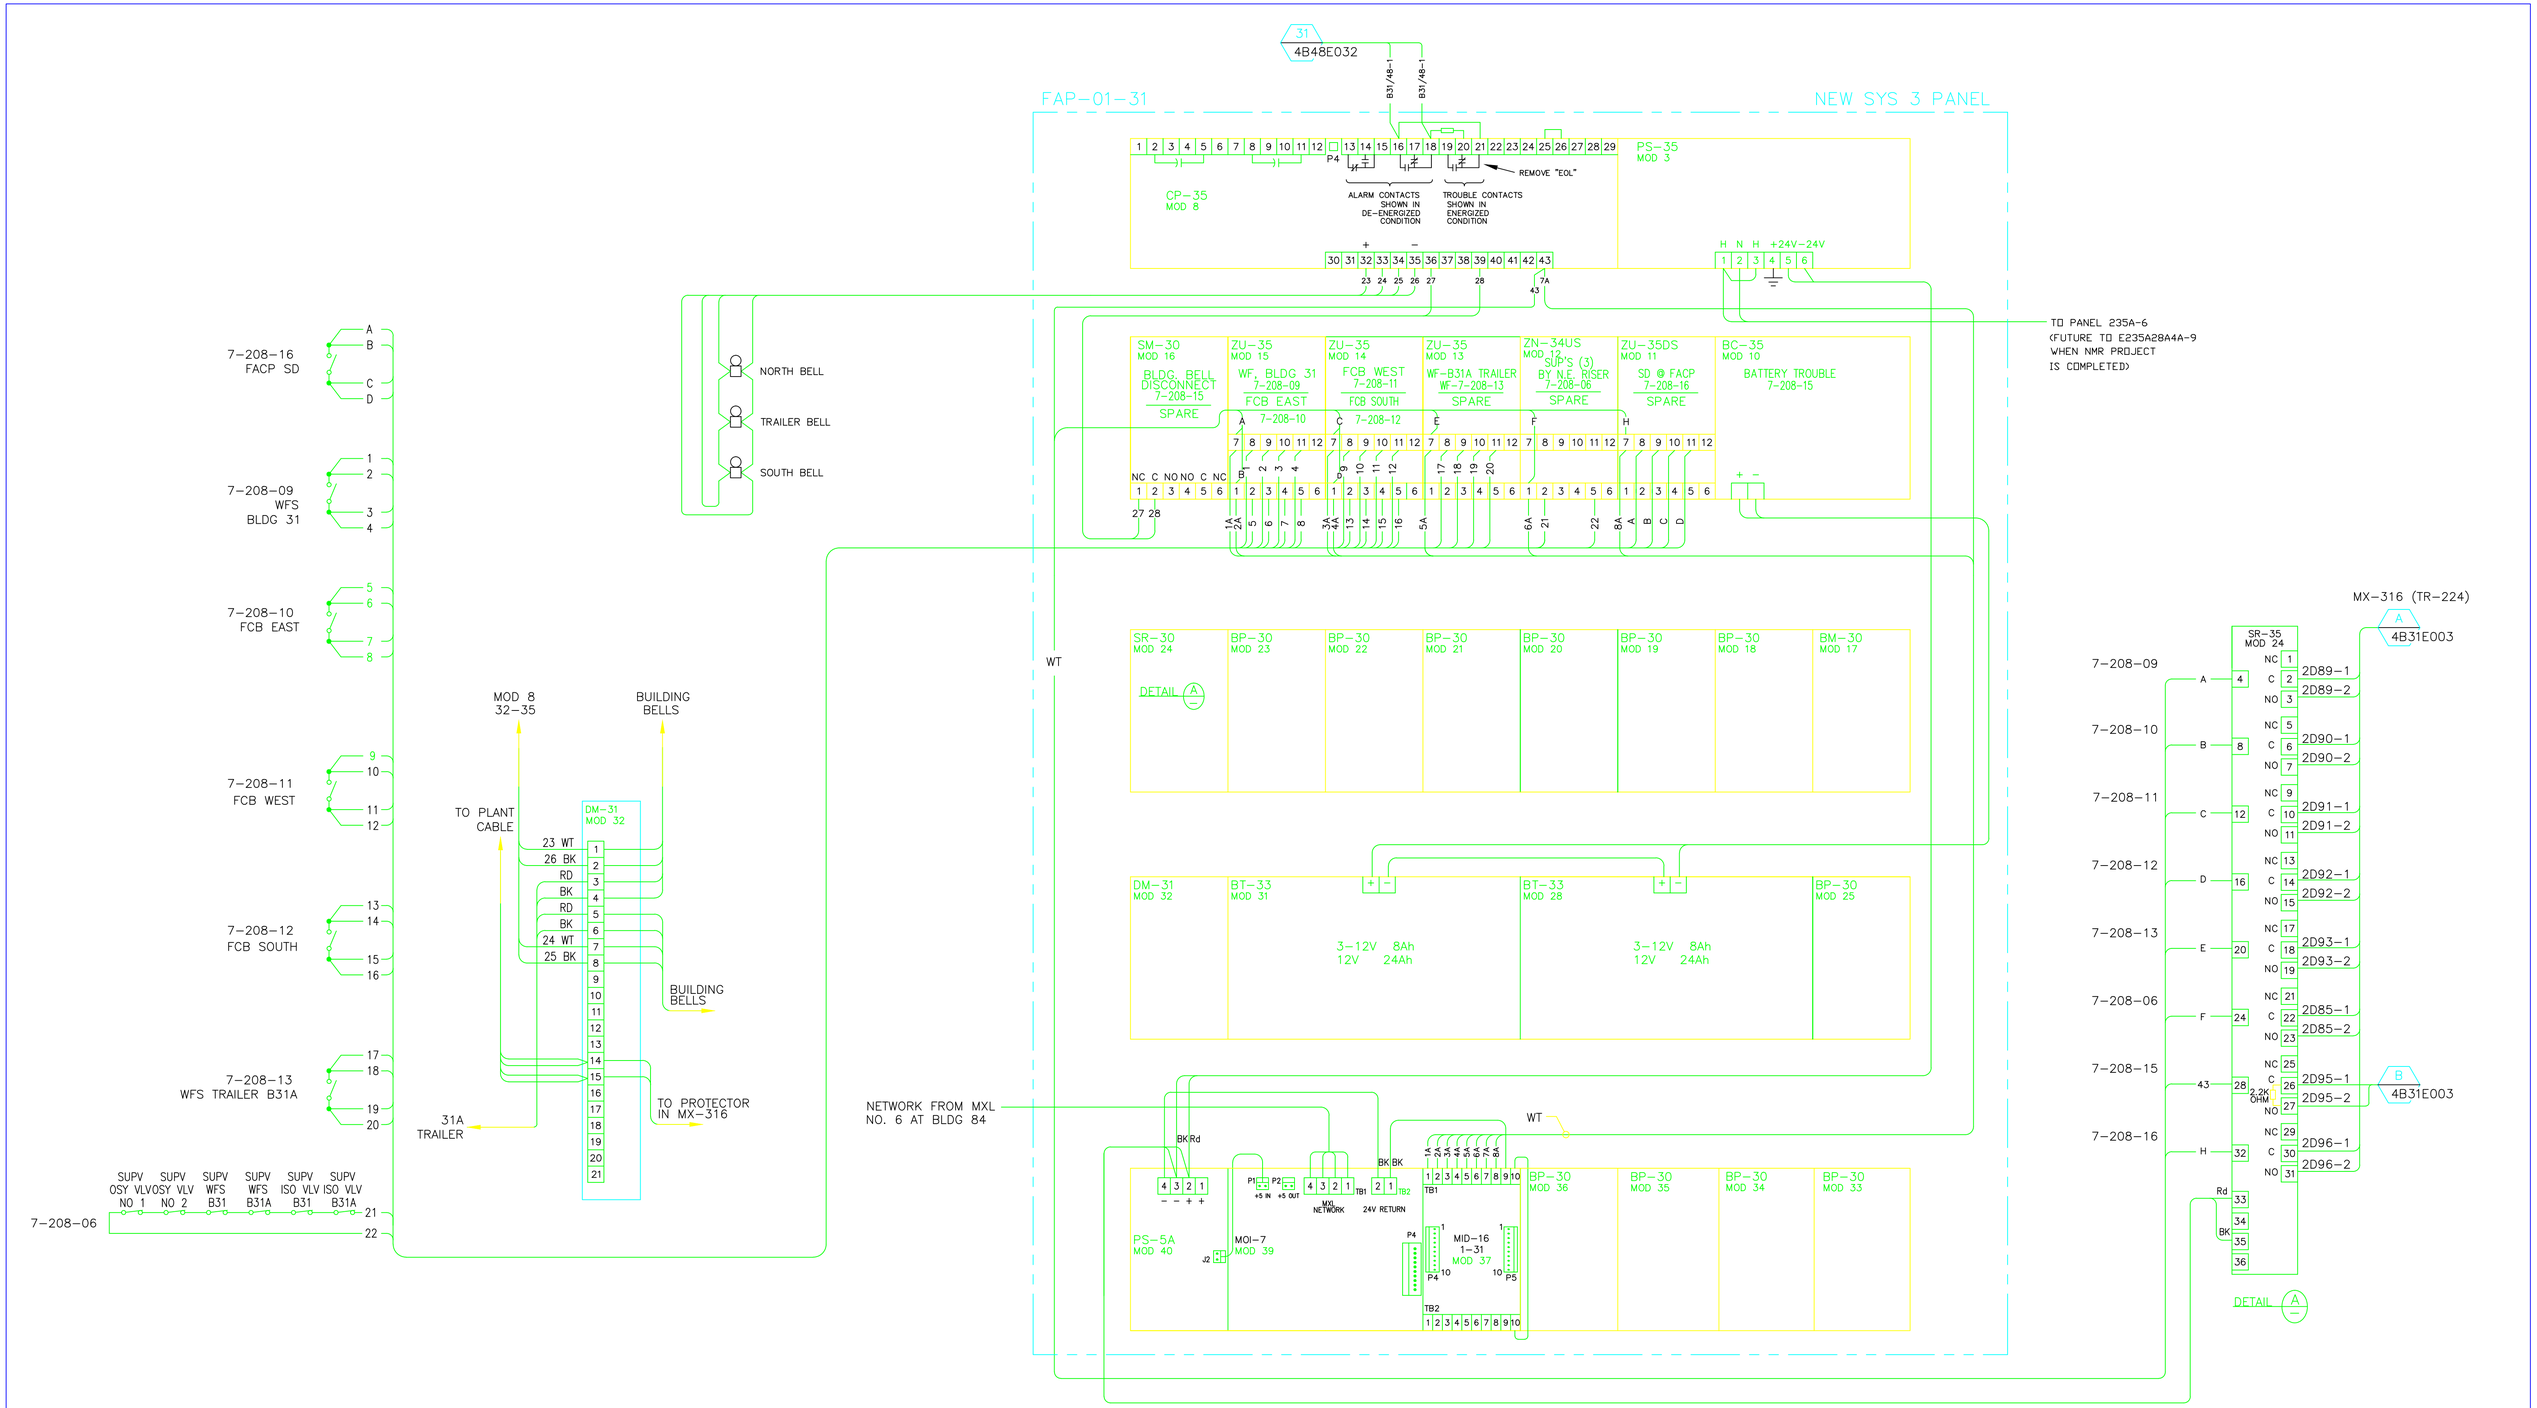

REFERENCE DRAWINGS:

4B31E001
4B31E003
4B31E008

AS BUILT

D
4/30/2013

REVISION NUMBER	DRAWN BY	CHECKED BY	APPR'D BY	DATE	REMARKS
D	LDD	LDD	MCD	4/30/13	AS BUILT PER FIELD VERIFICATIONS
C	AD	MCG	MCG	4/07/05	REVISED FOR MXL/DIGITIZE SYSTEMS
B	MRC	MCG	MCG	8/19/03	AS-BUILT, PHASE II FA UPGRADE
A	MRC	AD	MCG	7/25/03	PHASE II FIRE ALARM SYSTEM UPGRADE

PROFESSIONAL SEAL (IF REVISION, APPLIES ONLY TO REVISED WORK)

ISSUE: (PROGRESS, ESTIMATE, BID, CONSTRUCTION, CONFORMED, REVISION, RECORD)

31 FIRE ALARM SYSTEM
SYSTEM 3 PANEL FAP-01-31
INTERCONNECTION DIAGRAM

UNIVERSITY OF CALIFORNIA
LAWRENCE BERKELEY NATIONAL LABORATORY
FACILITIES DIVISION

DRAWN BY HYT	DATE 2/12/2002	
CHECKED BY HYT	2/12/2002	
APPROVED BY		
CAD FILE PATH		
SCALE As Noted		
DRAWING NO. 4B31E007D	SHEET 1 OF 1	
PROJECT NO. FA8040		