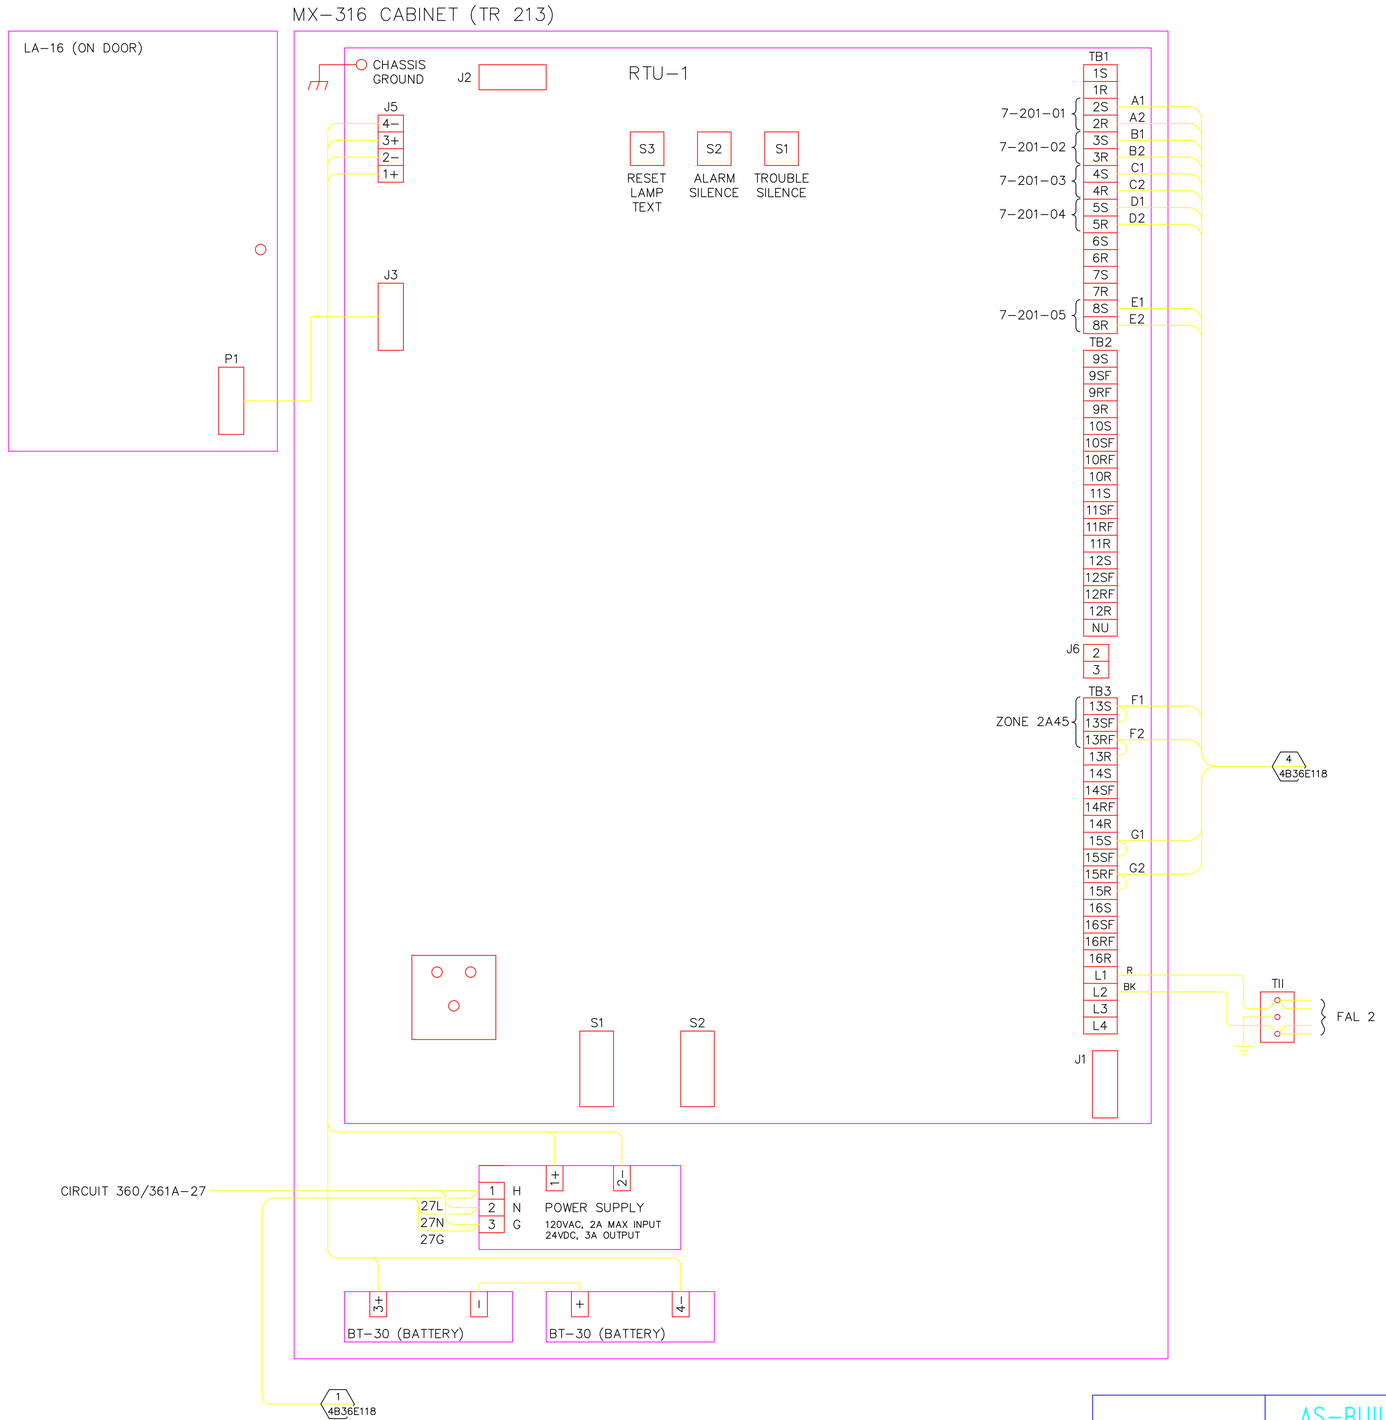

SEE 4B36E120 FOR OLD & NEW ZONE ADDRESS CROSS REFERENCES

REFERENCE DRAWINGS:

4B36E118	SYSTEM WIRING
4B36E119	
4B36E120	

DISTRIBUTION

1-FACILITIES M&O ELECTRIC SHOP BLDG. 76 - FILE I

1-ELEC. SECTION STICK FILE

ORIGINAL TO FLAT FILE IN 90F

PROFESSIONAL SEAL (IF REVISION, APPLIES ONLY TO REVISED WORK)

AS-BUILT

E

4/30/2013

ISSUE (PROGRESS, ESTIMATE, BID, CONSTRUCTION, CONFORMED, REVISION, RECORD)

REVISION NUMBER	DRAWN BY	CHECKED BY	APPR'D BY	DATE	REMARKS
E	LDD	LDD	MCD	4/30/13	AS BUILT PER FIELD VERIFICATIONS
D	RZT	MCG	MCG	4/04/05	REVISED FOR DIGITIZE SYSTEM.
C	MRC	AD	MCG	4/17/04	AS-BUILT, FIRE ALARM PHASE II UPGRADE
B	LDD	LDD	MCG	7/18/01	AS BUILT - BLDG 42 DEMO
A	FWD	MCG	MCG	1/22/98	AS BUILT FROM BLDG 42 DEMO REPLACES 4B42E004

36 FIRE ALARM SYSTEM
MX-316 TERMINATIONS
TRANSMITTER 213

UNIVERSITY OF CALIFORNIA LAWRENCE BERKELEY LABORATORY
FACILITIES DEPARTMENT

DRAWN BY	FWD	DATE 1/22/2098
CHECKED BY	MCG	1/22/2098
APPROVED BY	MCG	1/22/2098
CAD FILE PATH		
SCALE	As Noted	
DRAWING NO.	4B36E112E	SHEET
PROJECT NO.	308040	1 OF 1