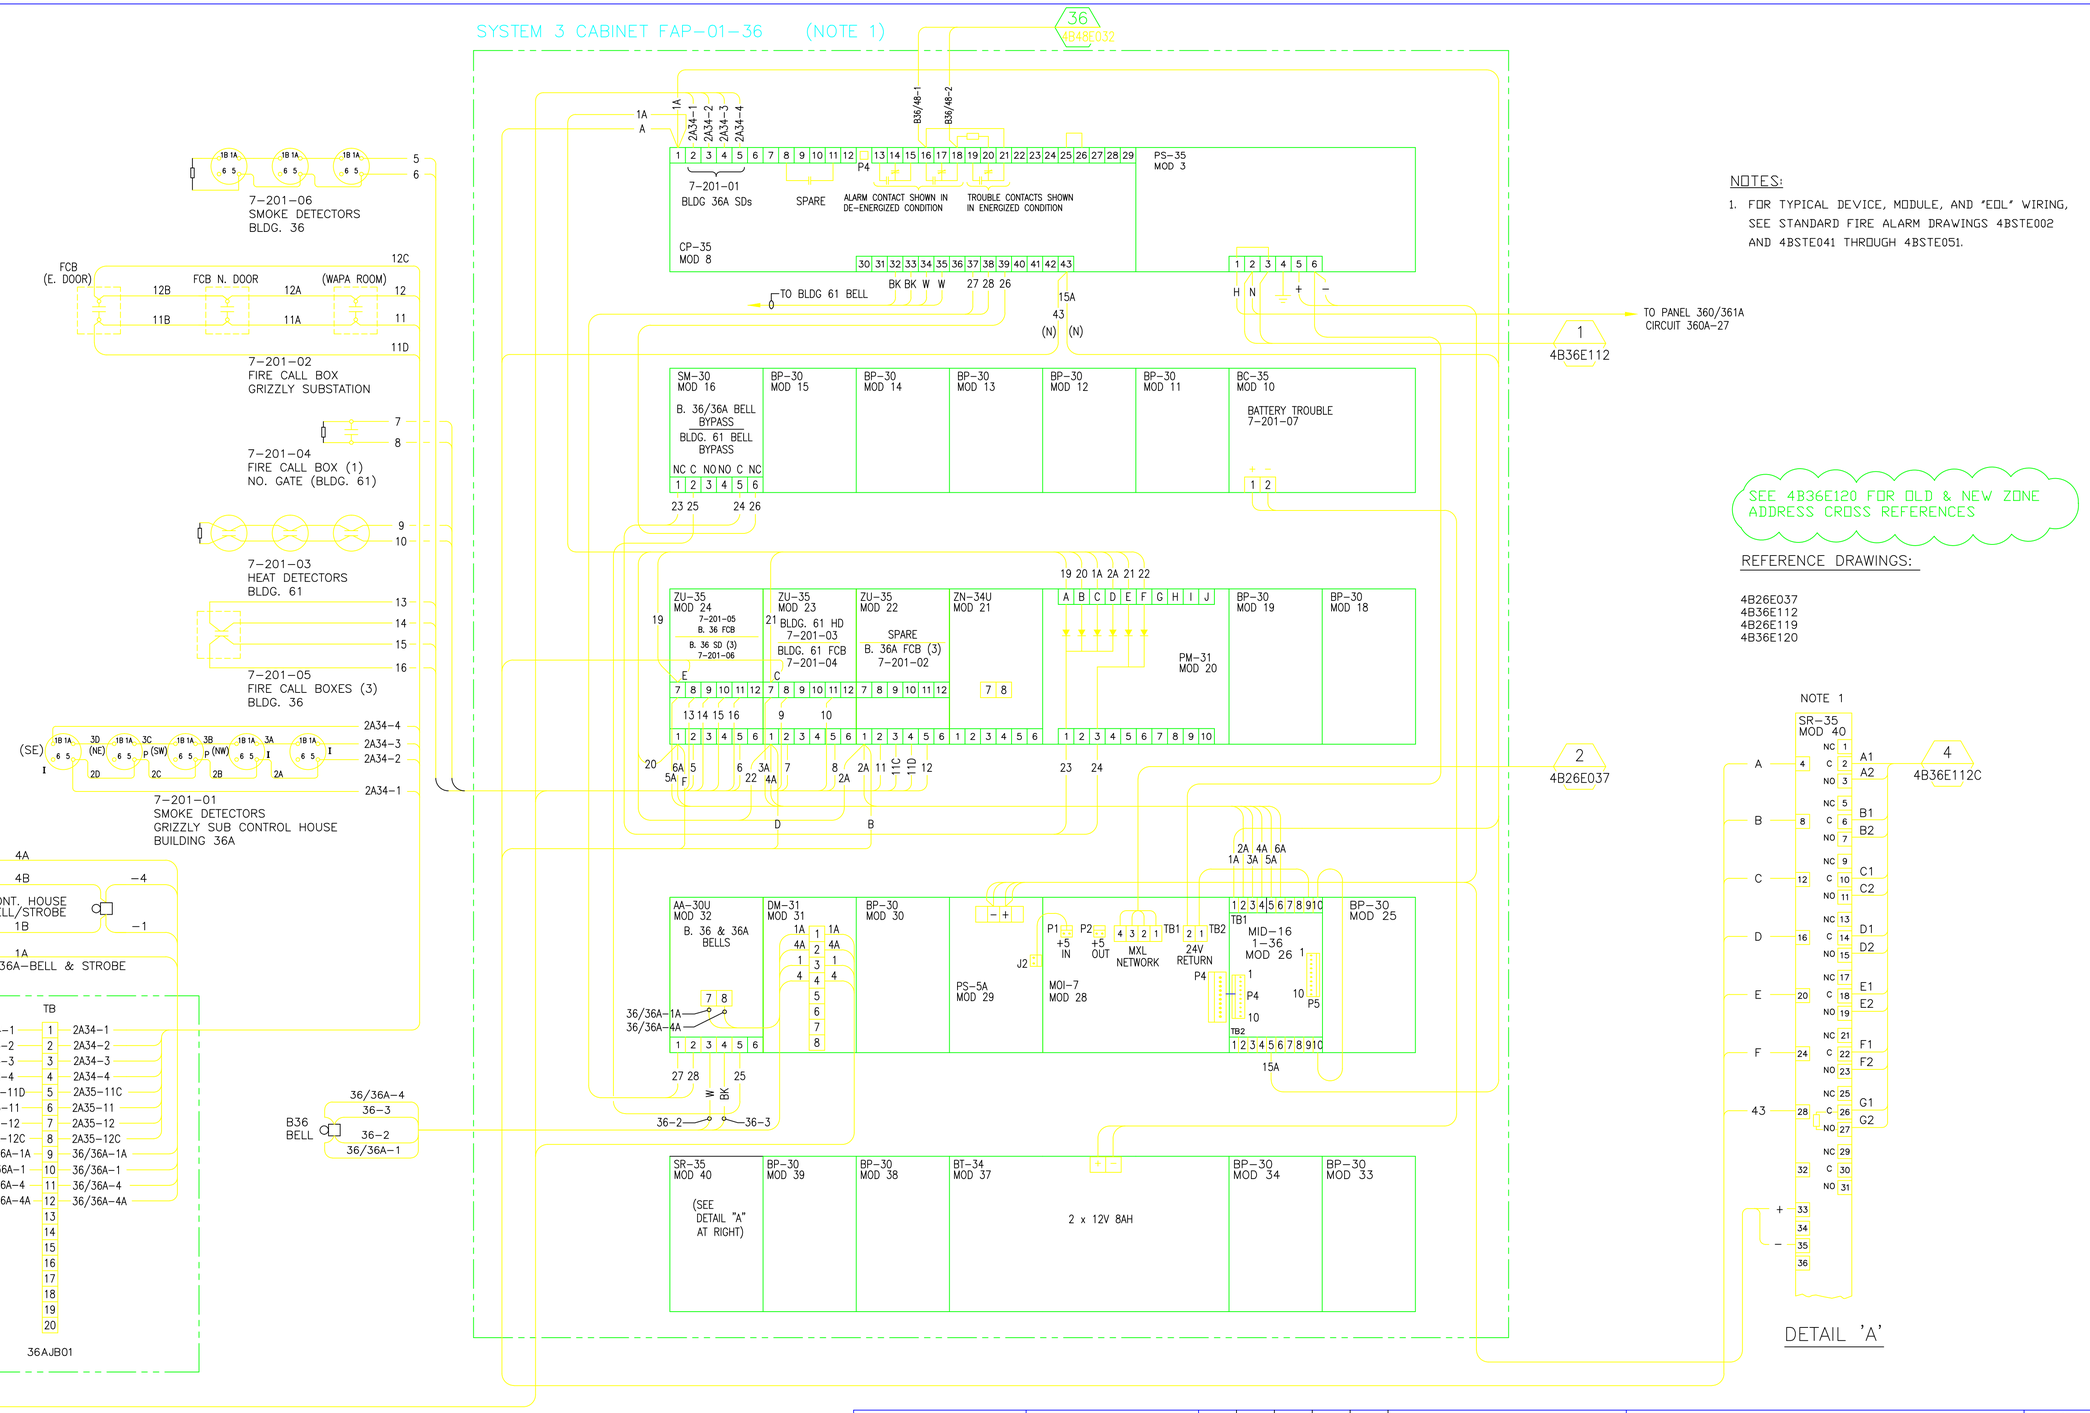

NOTES:

1. FOR TYPICAL DEVICE, MODULE, AND "EOL" WIRING, SEE STANDARD FIRE ALARM DRAWINGS 4BSTE002 AND 4BSTE041 THROUGH 4BSTE051.

PROFESSIONAL SEAL (IF REVISION, APPLIES ONLY TO REVISED WORK)	ISSUE (PROGRESS, ESTIMATE, BID, CONSTRUCTION, CONFORMED, REVISION, RECORD)	REVISION NUMBER	DRAWN BY	CHECKED BY	APPR'D BY	DATE	REMARKS
	AS BUILT						
	D	D	LDD	LDD	MCD	4/30/13	AS BUILT PER FIELD VERIFICATIONS
	4/30/2013	C	RZT	MCG	MCG	4/04/05	REVISED FOR MXL SYSTEM.
		B	AD	AD	MCG	02/17/04	AS-BUILT, PHASE II FA UPGRADE
		A	HYT	HYT	–	–	CHANGE MXL LOOP TO BLDG 26 MXL
		–	–				–

36 BLDG 36/36A
REPLACEMENT FIRE ALARM SYSTEM
SYSTEM 3 WIRING

UNIVERSITY OF CALIFORNIA
LAWRENCE BERKELEY NATIONAL LABORATORY
FACILITIES DIVISION

DRAWN BY HYT	DATE 5/8/2001	
CHECKED BY HYT	5/1/2001	
APPROVED BY –	1/2/2002	
CAD FILE PATH		
SCALE NONE		
DRAWING NO. 4B36E118D	SHEET 1 OF 1	
PROJECT NO. 308040		