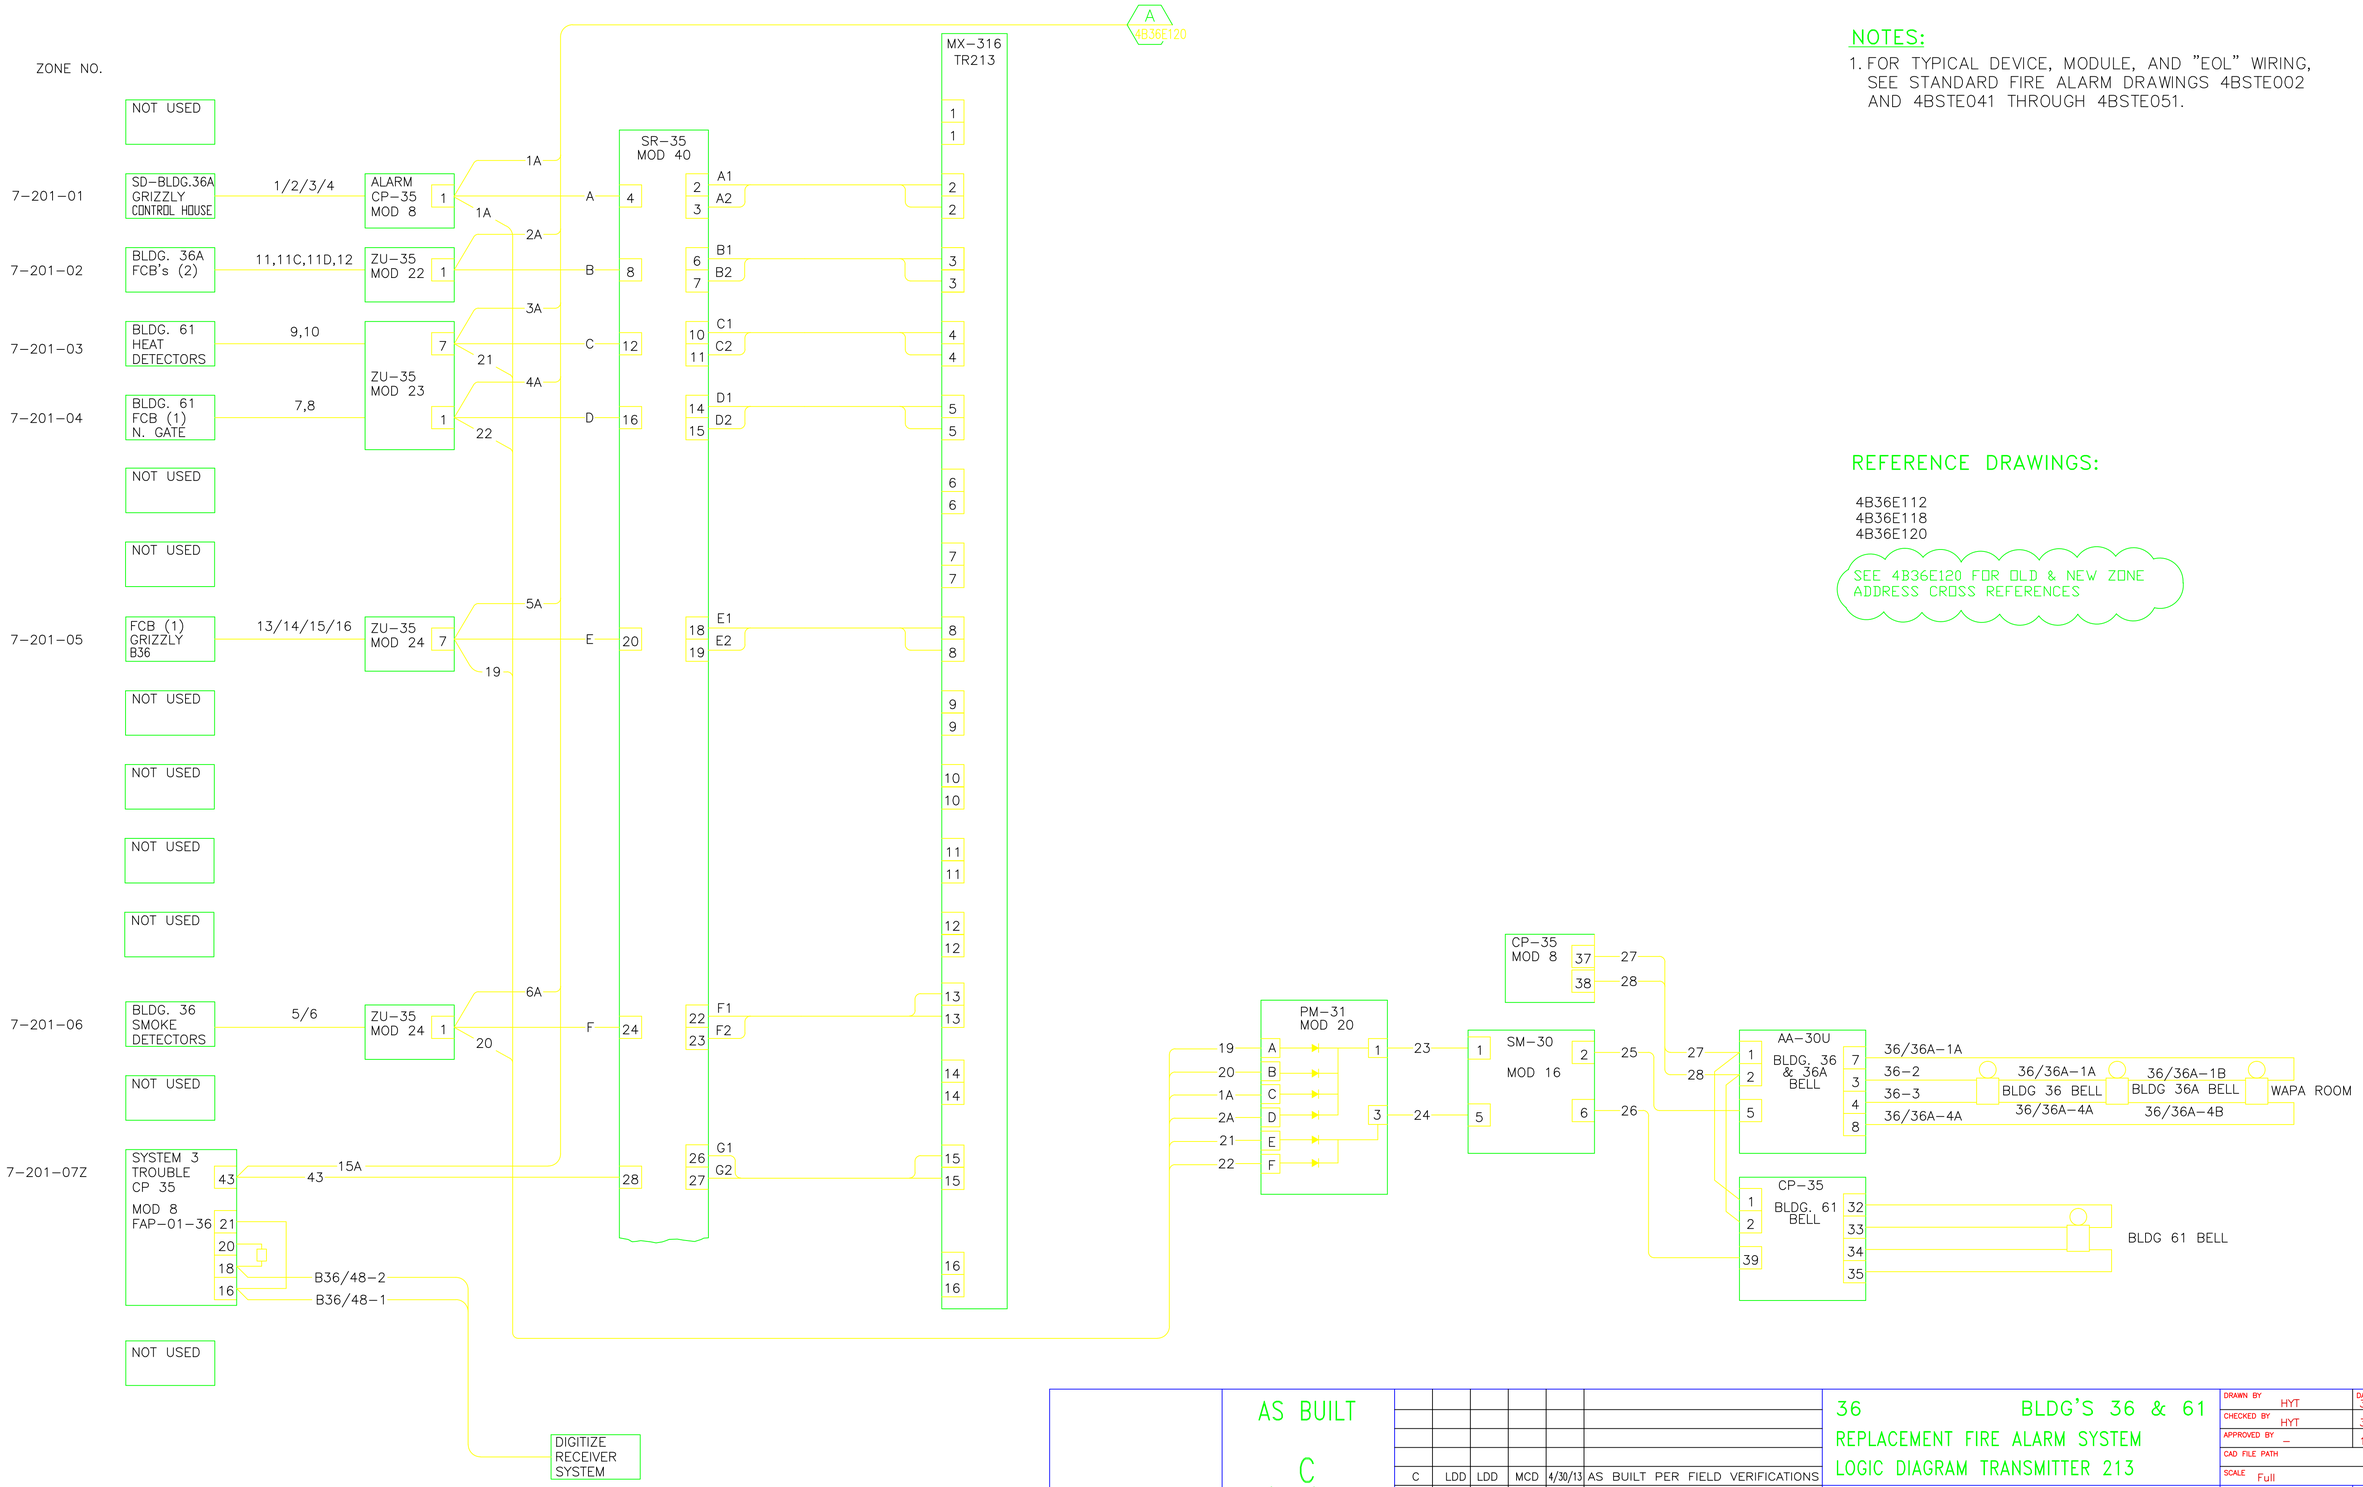

NOTES:

1. FOR TYPICAL DEVICE, MODULE, AND "EOL" WIRING, SEE STANDARD FIRE ALARM DRAWINGS 4BSTE002 AND 4BSTE041 THROUGH 4BSTE051.

REFERENCE DRAWINGS:

4B36E112
4B36E118
4B36E120

SEE 4B36E120 FOR OLD & NEW ZONE ADDRESS CROSS REFERENCES

PROFESSIONAL SEAL (IF REVISION, APPLIES ONLY TO REVISED WORK)	ISSUE (PROGRESS, ESTIMATE, BID, CONSTRUCTION, CONFORMED, REVISION, RECORD)	REVISION NUMBER	DRAWN BY	CHECKED BY	APPR'D BY	DATE	REMARKS
	AS BUILT	C	LDD	LDD	MCD	4/30/13	AS BUILT PER FIELD VERIFICATIONS
	C 4/30/2013	B	RZT	MCG	MCG	4/04/05	REVISED FOR MXL/DIGITIZE SYSTEM.
		A	AD	MCG	MCG	02/17/04	AS-BUILT, FIRE ALARM PHASE II UPGRADE

36 BLDG'S 36 & 61
REPLACEMENT FIRE ALARM SYSTEM
LOGIC DIAGRAM TRANSMITTER 213

UNIVERSITY OF CALIFORNIA
LAWRENCE BERKELEY NATIONAL LABORATORY
FACILITIES DIVISION

DRAWN BY HYT	DATE 3/30/2001	
CHECKED BY HYT	3/30/2001	
APPROVED BY –	1/2/2002	
CAD FILE PATH		
SCALE Full		
DRAWING NO. 4B36E119C	SHEET 1 OF 1	
PROJECT NO. 308040		