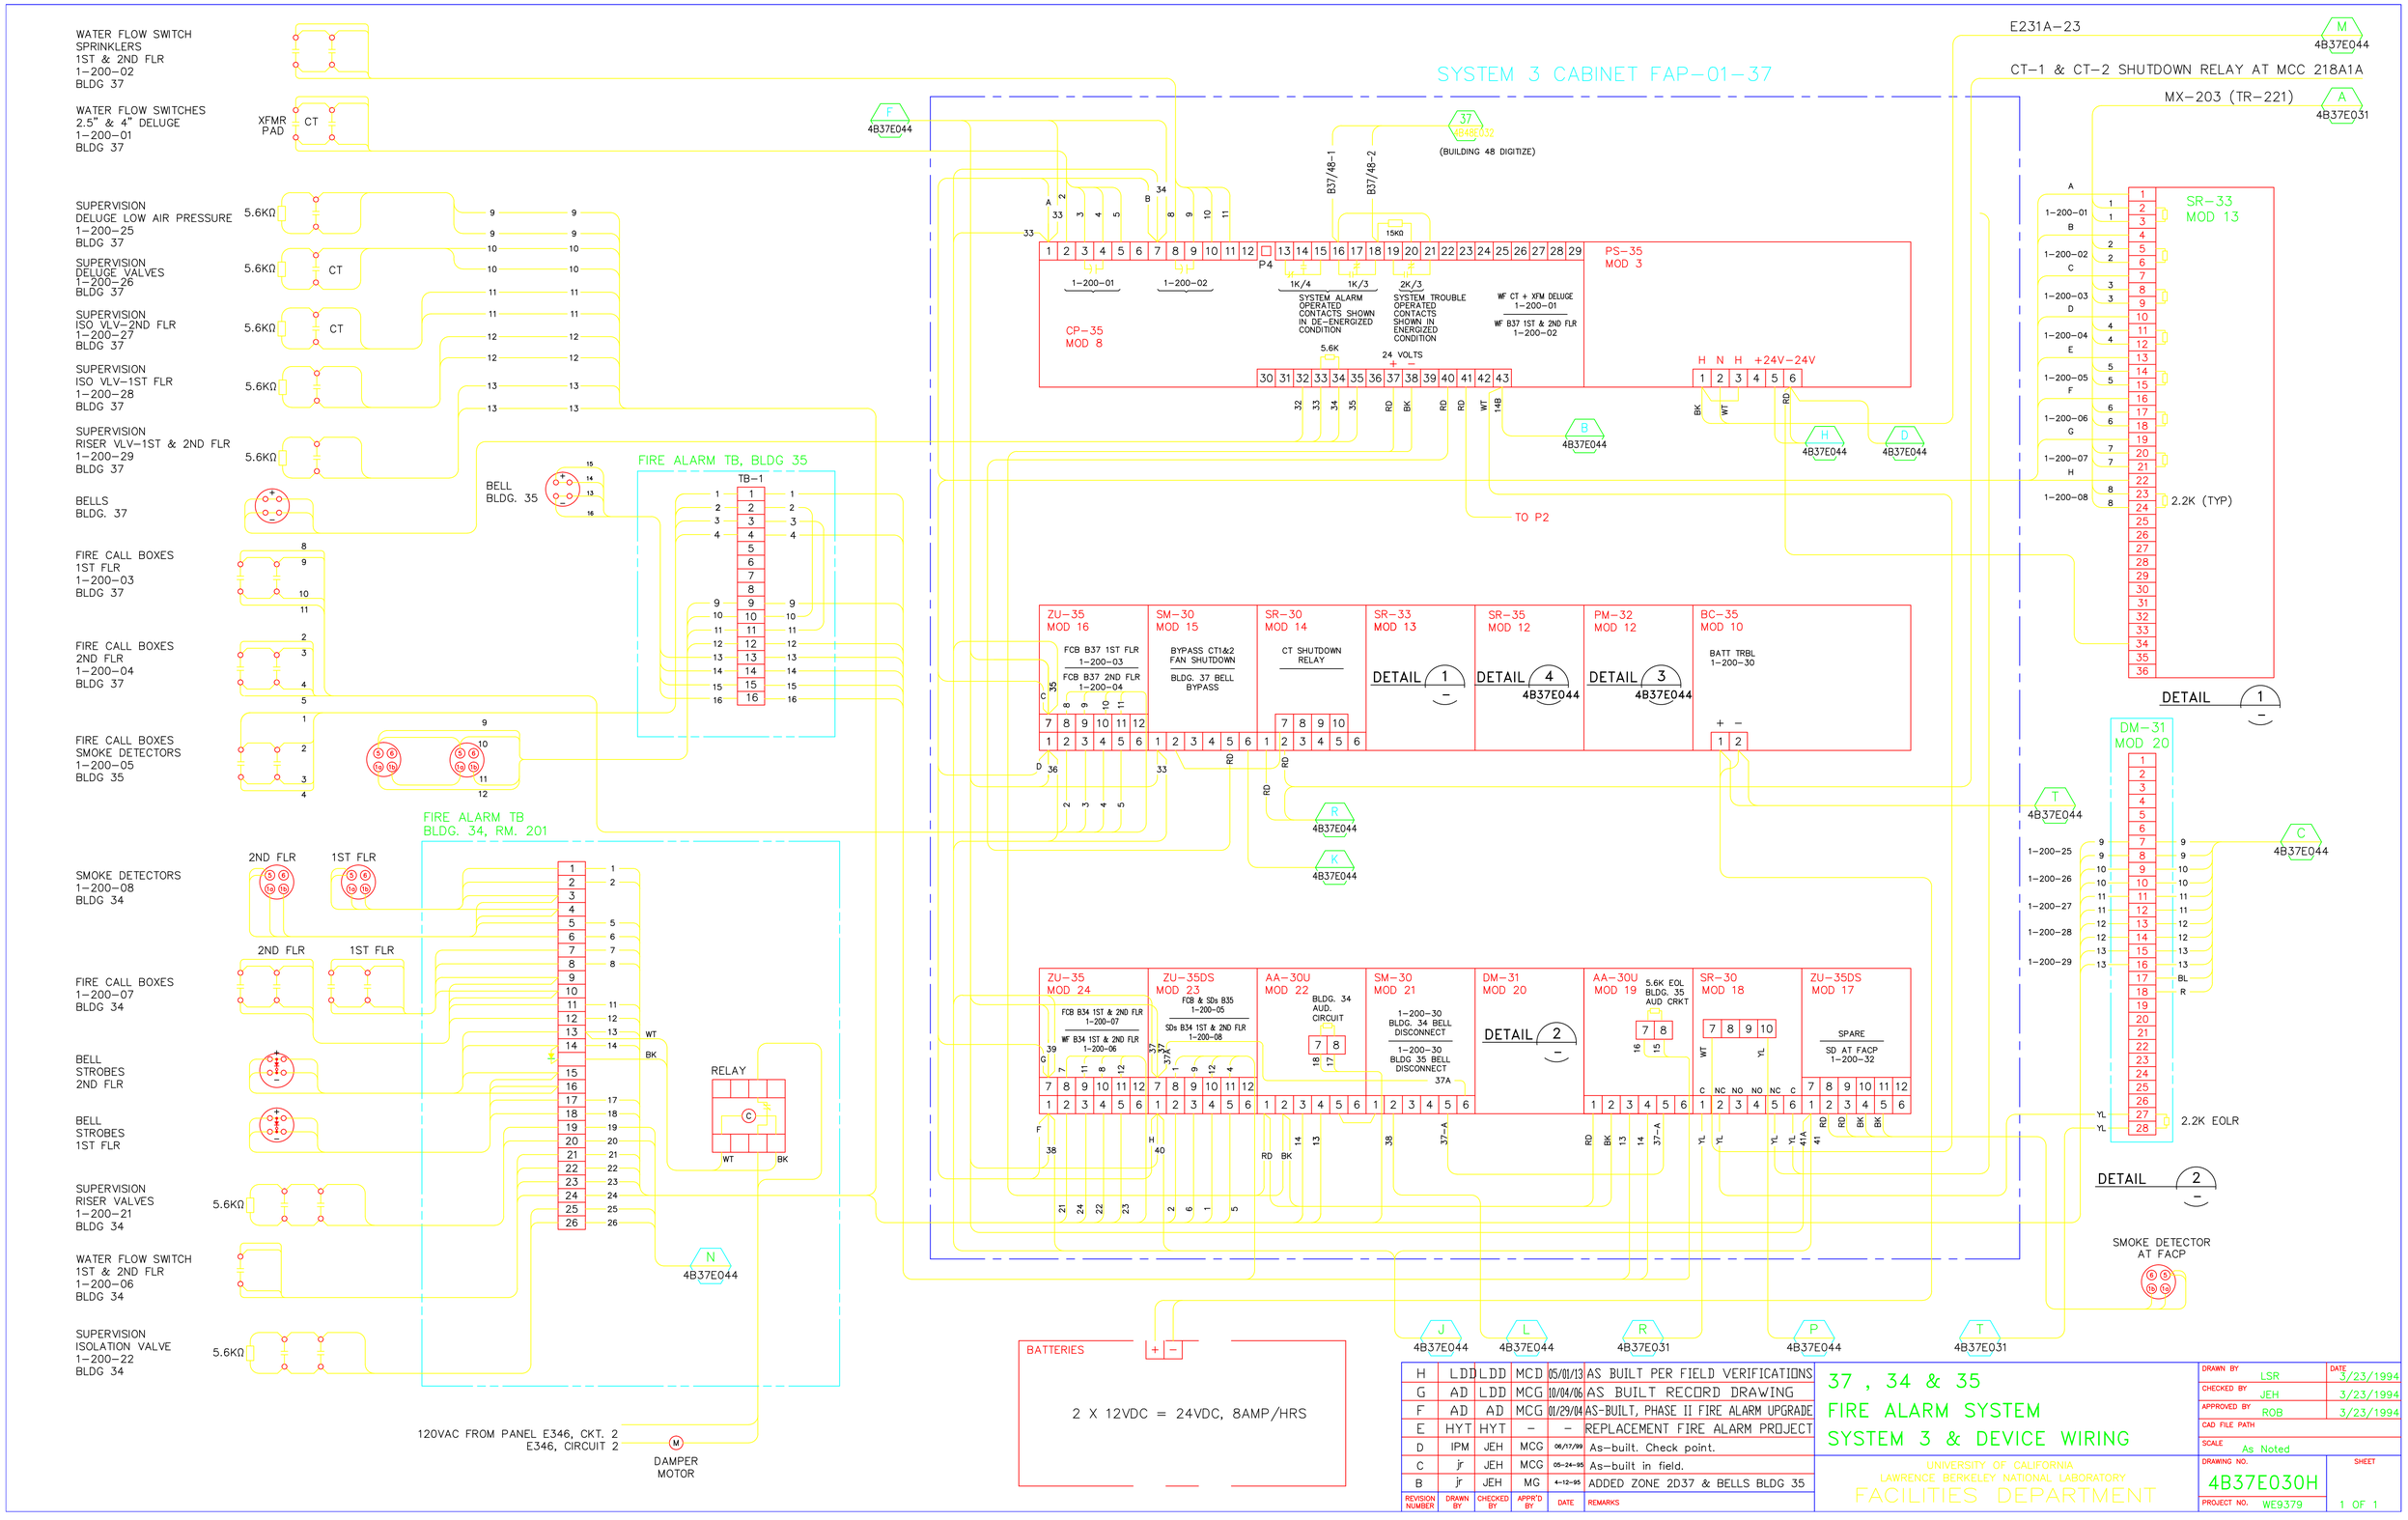

REVISION NUMBER	DRAWN BY	CHECKED BY	APPR'D BY	DATE	REMARKS
H	LDD	LDD	MCD	05/01/13	AS BUILT PER FIELD VERIFICATIONS
G	AD	LDD	MCG	10/04/06	AS BUILT RECORD DRAWING
F	AD	AD	MCG	01/29/04	AS-BUILT, PHASE II FIRE ALARM UPGRADE
E	HYT	HYT	–	–	REPLACEMENT FIRE ALARM PROJECT
D	IPM	JEH	MCG	06/17/99	As-built. Check point.
C	jr	JEH	MCG	05-24-95	As-built in field.
B	jr	JEH	MG	4-12-95	ADDED ZONE 2D37 & BELLS BLDG 35

37 , 34 & 35
FIRE ALARM SYSTEM
SYSTEM 3 & DEVICE WIRING

UNIVERSITY OF CALIFORNIA
LAWRENCE BERKELEY NATIONAL LABORATORY
FACILITIES DEPARTMENT

		DATE
DRAWN BY	LSR	3/23/1994
CHECKED BY	JEH	3/23/1994
APPROVED BY	ROB	3/23/1994
CAD FILE PATH		
SCALE	As Noted	
DRAWING NO.	4B37E030H	
PROJECT NO.	WE9379	
SHEET	1 OF 1	