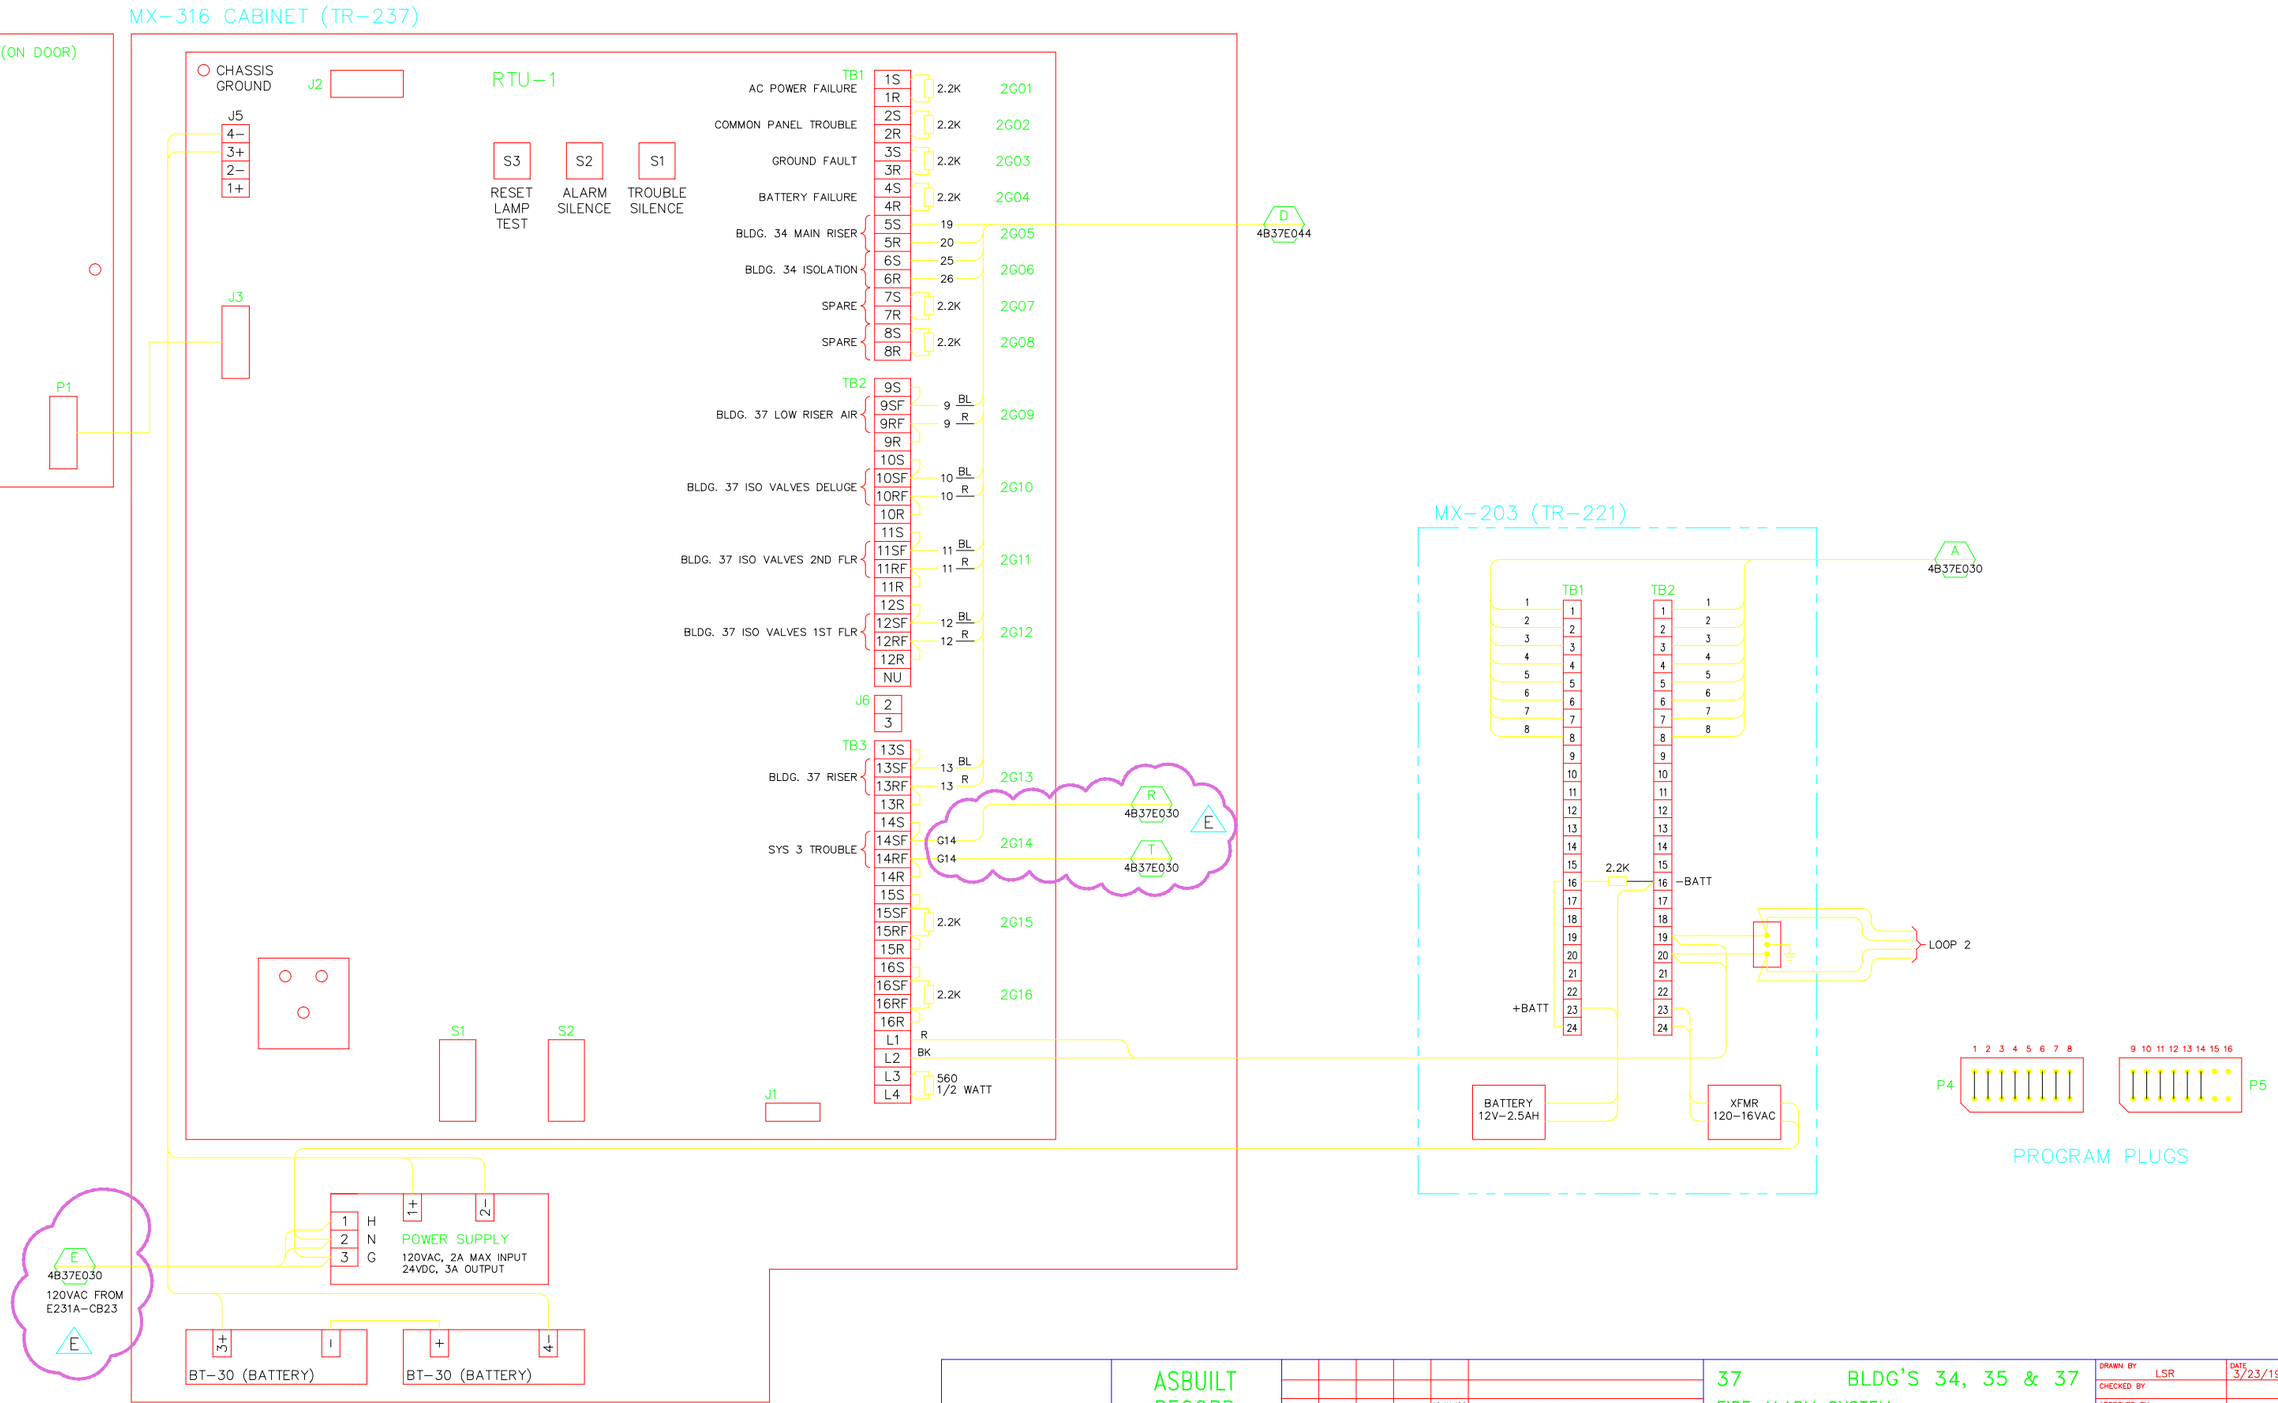

ASBUILT RECORD
E
10/11/2006

PROFESSIONAL SEAL (IF REVISION, APPLIES ONLY TO REVISED WORK)

ISSUE (PROGRESS, ESTIMATE, BID, CONSTRUCTION, CONFORMED, REVISION, RECORD)					
REVISION NUMBER	DRAWN BY	CHECKED BY	APPR'D BY	DATE	REMARKS
E	AD	LDD	MCD	10/11/06	AS-BUILT RECORD DRAWING
D	RZT	MCG	MCG	4/06/05	REVISED FOR DIGITIZE SYSTEM.
C	AD	AD	MCG	01/29/04	AS-BUILT, PHASE II FA UPGRADE
B	IPM	JEH	ROB	11/3/99	AS BUILD
A	LSR	JEH	ROB	3/24/94	REDRAWN ON AUTOCAD AS-BUILT

37 BLDG'S 34, 35 & 37
FIRE ALARM SYSTEM
MX-203 & MX-316 WIRING

UNIVERSITY OF CALIFORNIA
LAWRENCE BERKELEY NATIONAL LABORATORY
FACILITIES DIVISION

DRAWN BY	LSR	DATE	3/23/1994
CHECKED BY			
APPROVED BY			
CAD FILE PATH	00021544		
SCALE	As Noted		
DRAWING NO.	4B37E031E	SHEET	1 OF 1
PROJECT NO.	WE9379		