FIRE ALARM SYMBOLS

- MANUAL ALARM BOX (PULL STATION AND PULL BOX)
- SMOKE DETECTOR INCLUDES PHOTOELECTRIC AND IONIZATION TYPE DETECTORS
- FLOW DETECTOR/SWITCH
- PRESSURE DETECTOR/SWITCH
- TAMPER DETECTOR/SWITCH
- VALVE WITH TAMPER DETECTOR/SWITCH
- FIRE ALARM BELL WITH STROBE
- FIRE ALARM BELL

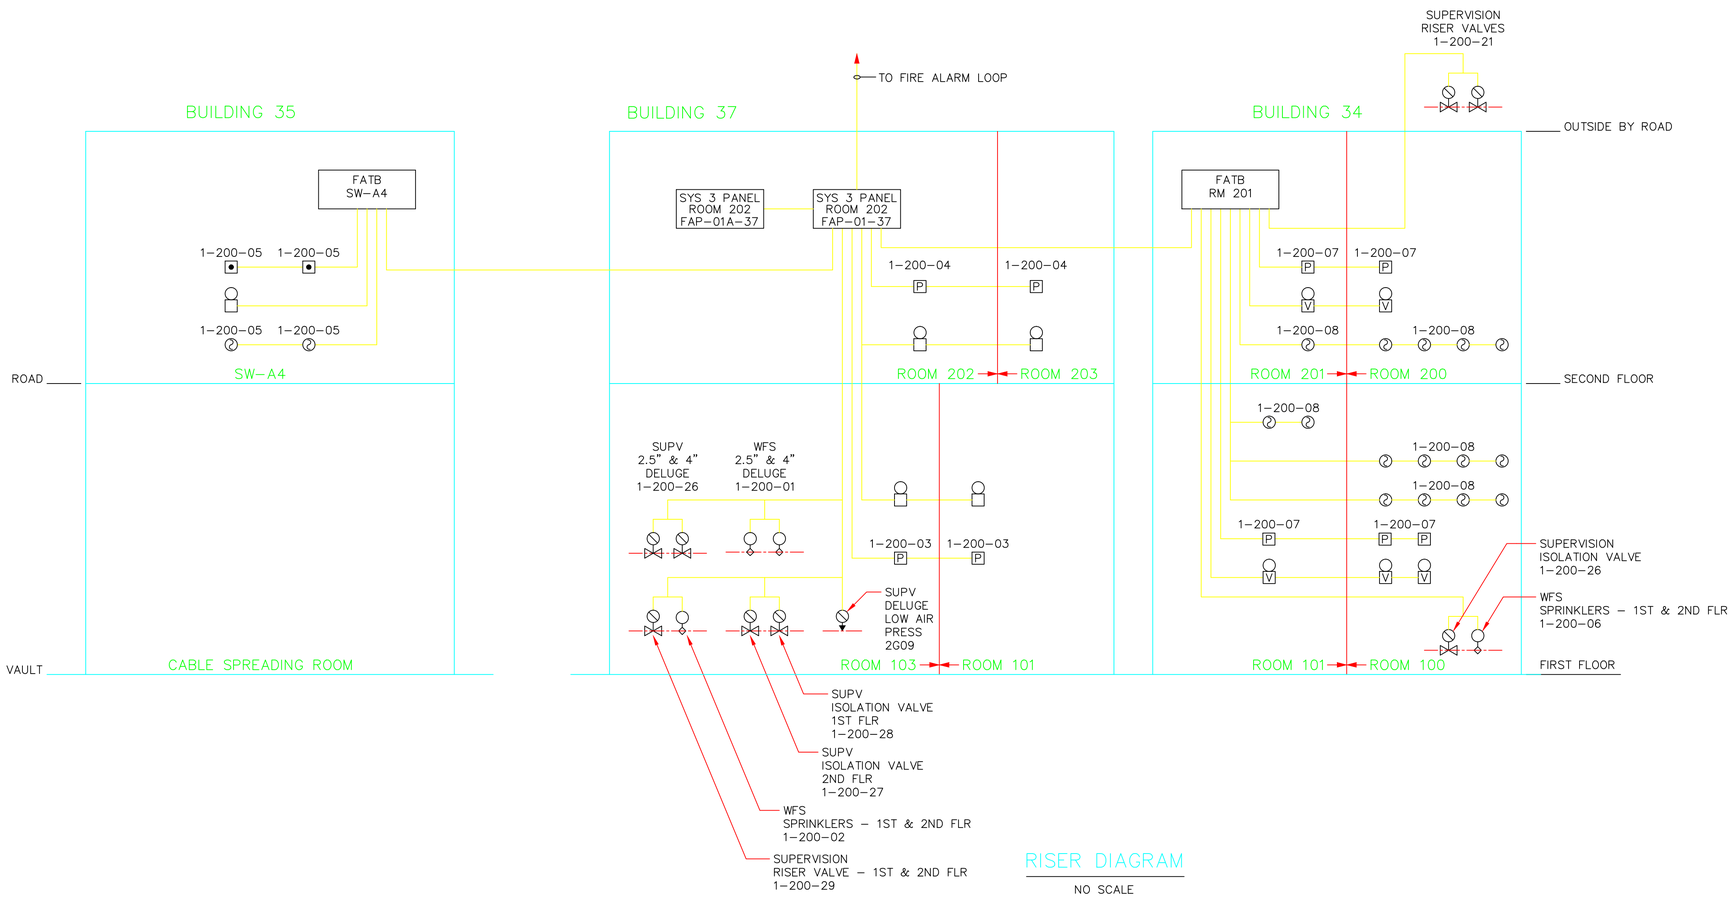

RISER DIAGRAM

NO SCALE

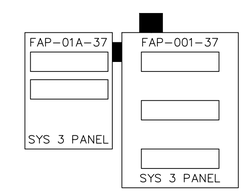

FIRE ALARM PANELS
BLDG. 37 - RM. 202

ELEVATION

(NO SCALE)

AS BUILT

F

5/1/2013

REVISION NUMBER	DRAWN BY	CHECKED BY	APPR'D BY	DATE	REMARKS
F	LDD	LDD	MCD	05/01/13	AS-BUILT PER FIELD VERIFICATIONS
E	AD	AD	MCG	01/29/04	AS-BUILT, PHASE II FA UPGRADE
D	HYT	HYT	-	-	REPLACEMENT FIRE ALARM PROJECT
C	jr	JEH	MCG	05-10-95	As-built drawing. No changes from Revision B.
B	jr	JEH	MGupta	04-11-95	ADDED BUILDING 35
A	LSR	JEH	RBaker	03-24-94	REDRAWN ON AUTOCAD AS-BUILT

PROFESSIONAL SEAL (IF REVISION, APPLIES ONLY TO REVISED WORK)

ISSUE (PROGRESS, ESTIMATE, BID, CONSTRUCTION, CONFORMED, REVISION, RECORD)

37 BLDG'S 34, 35 & 37

FIRE ALARM SYSTEM

RISER DIAGRAM & PANEL ELEVATION

UNIVERSITY OF CALIFORNIA
LAWRENCE BERKELEY NATIONAL LABORATORY
FACILITIES DIVISION

		DATE
DRAWN BY	LSR	3/23/1994
CHECKED BY	JEH	3/25/1994
APPROVED BY	ROB	3/25/1994
CAD FILE PATH		
SCALE	As Noted	
DRAWING NO.	4B37E032F	SHEET
PROJECT NO.	WE9379	1 OF 1