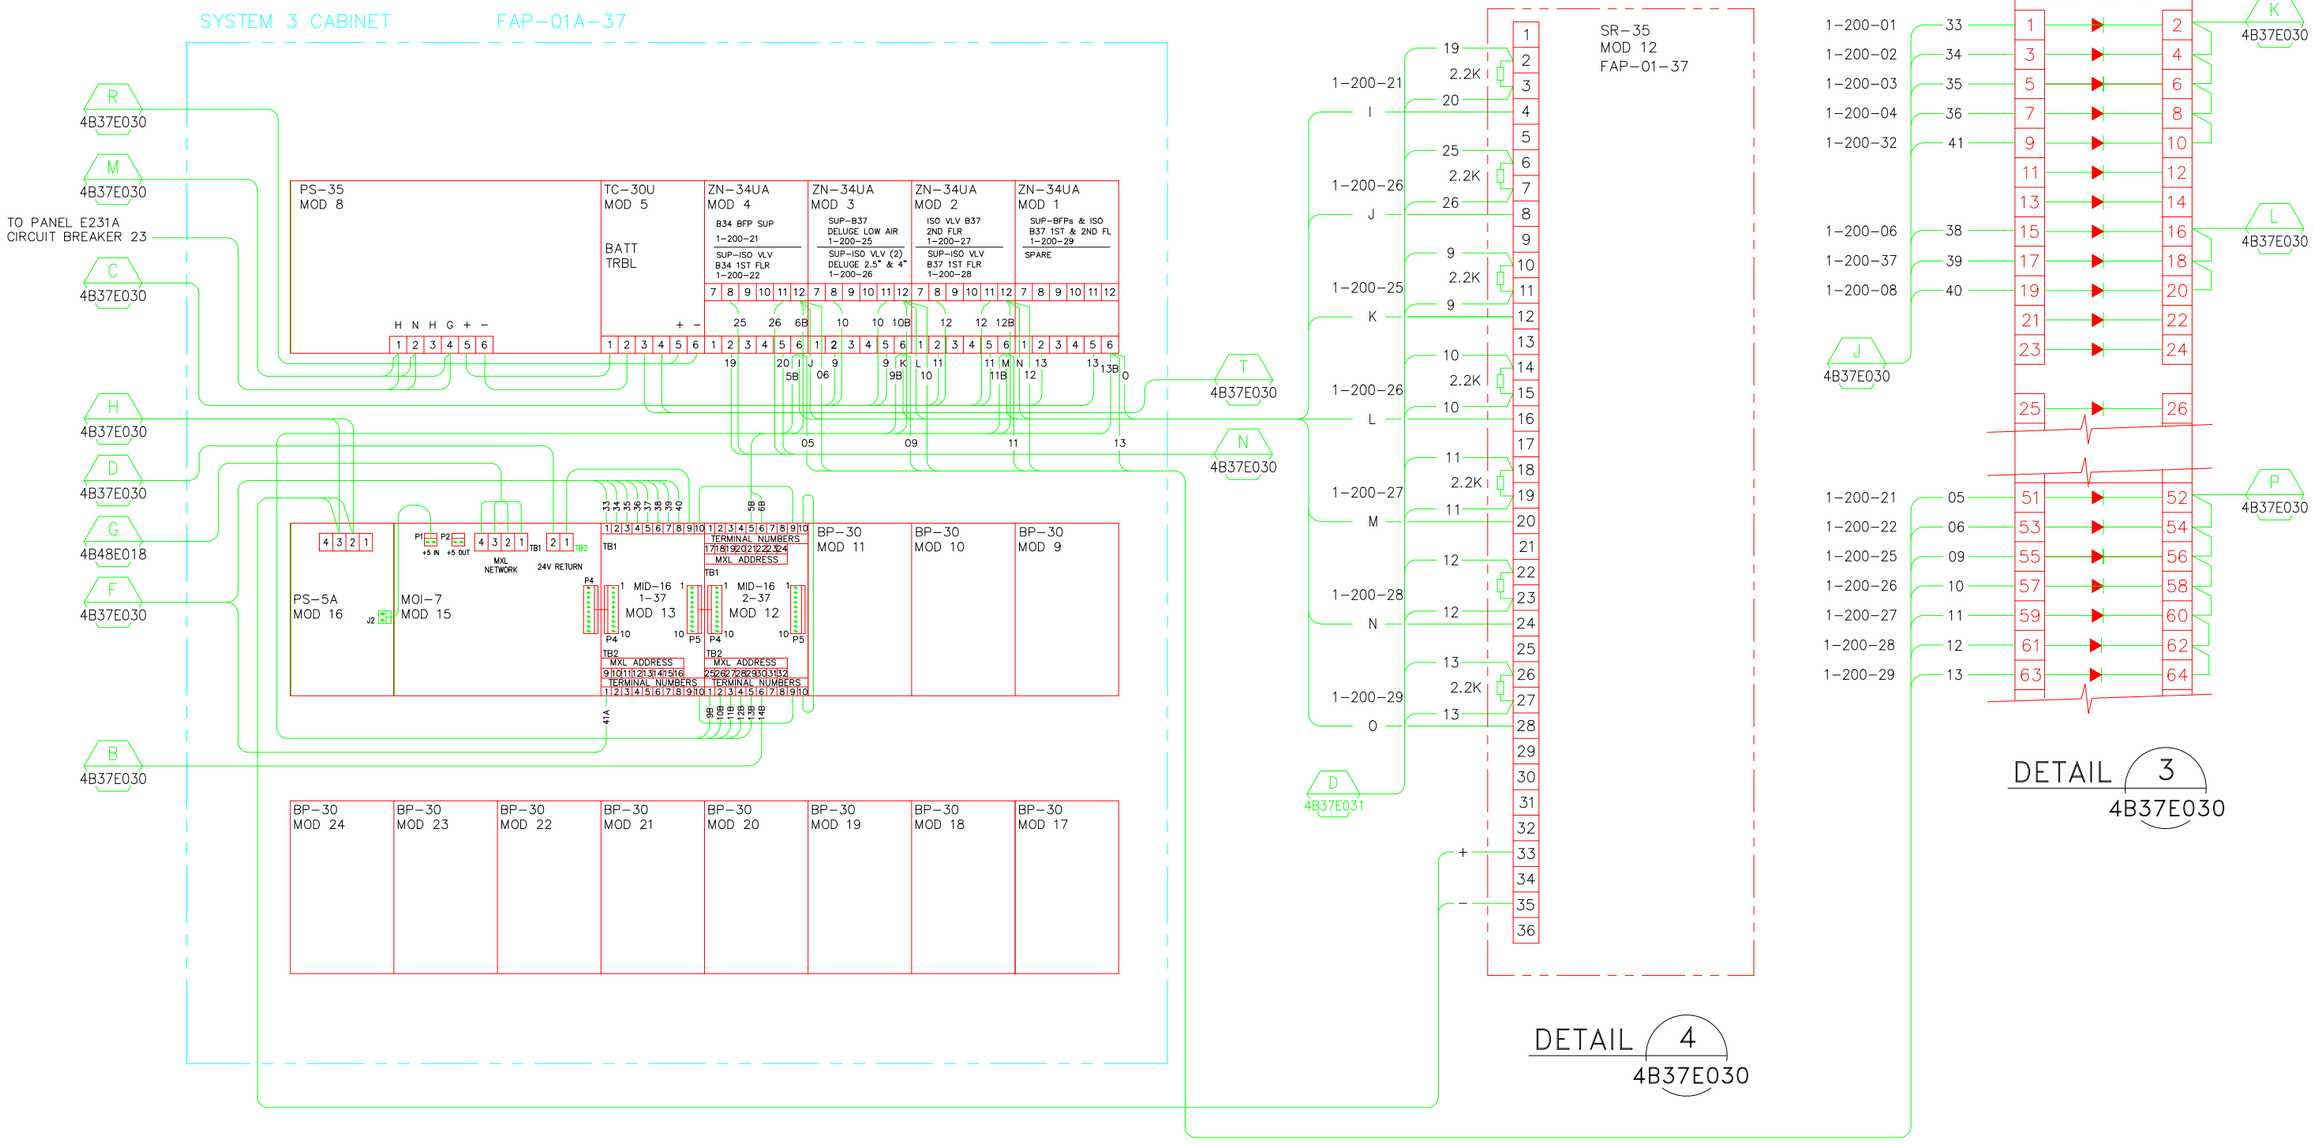

D	LDD	LDD	MCD	4/30/13	AS-BUILT PER FIELD VERIFICATIONS	
C	AD	LDD	MCD	9/27/06	AS-BUILT RECORD DRAWING	
B	RZT	MCG	MCG	4/04/05	ADDED WIRING FOR MXL SYSTEM.	
A	AD	AD	MCG	1/29/04	AS-BUILT, REPLACEMENT FIRE ALARM PROJECT	
REVISION NUMBER	DRAWN BY	CHECKED BY	APPR'D BY	DATE	REMARKS	

PROFESSIONAL SEAL (IF REVISION, APPLIES ONLY TO REVISED WORK)

ISSUE (PROGRESS, ESTIMATE, BID, CONSTRUCTION, CONFORMED, REVISION, RECORD)

AS BUILT

D
4/30/2013

37 BLDG'S 34, 35,37
REPLACEMENT FIRE ALARM SYSTEM
SYSTEM 3 FAP-01A-37

UNIVERSITY OF CALIFORNIA
LAWRENCE BERKELEY NATIONAL LABORATORY
FACILITIES DIVISION

DRAWN BY HYT DATE 6/1/2001
CHECKED BY HYT 6/1/2001
APPROVED BY
CAD FILE PATH
SCALE Full
DRAWING NO. 4B37E044D
SHEET 1 OF 1
PROJECT NO. WE9379