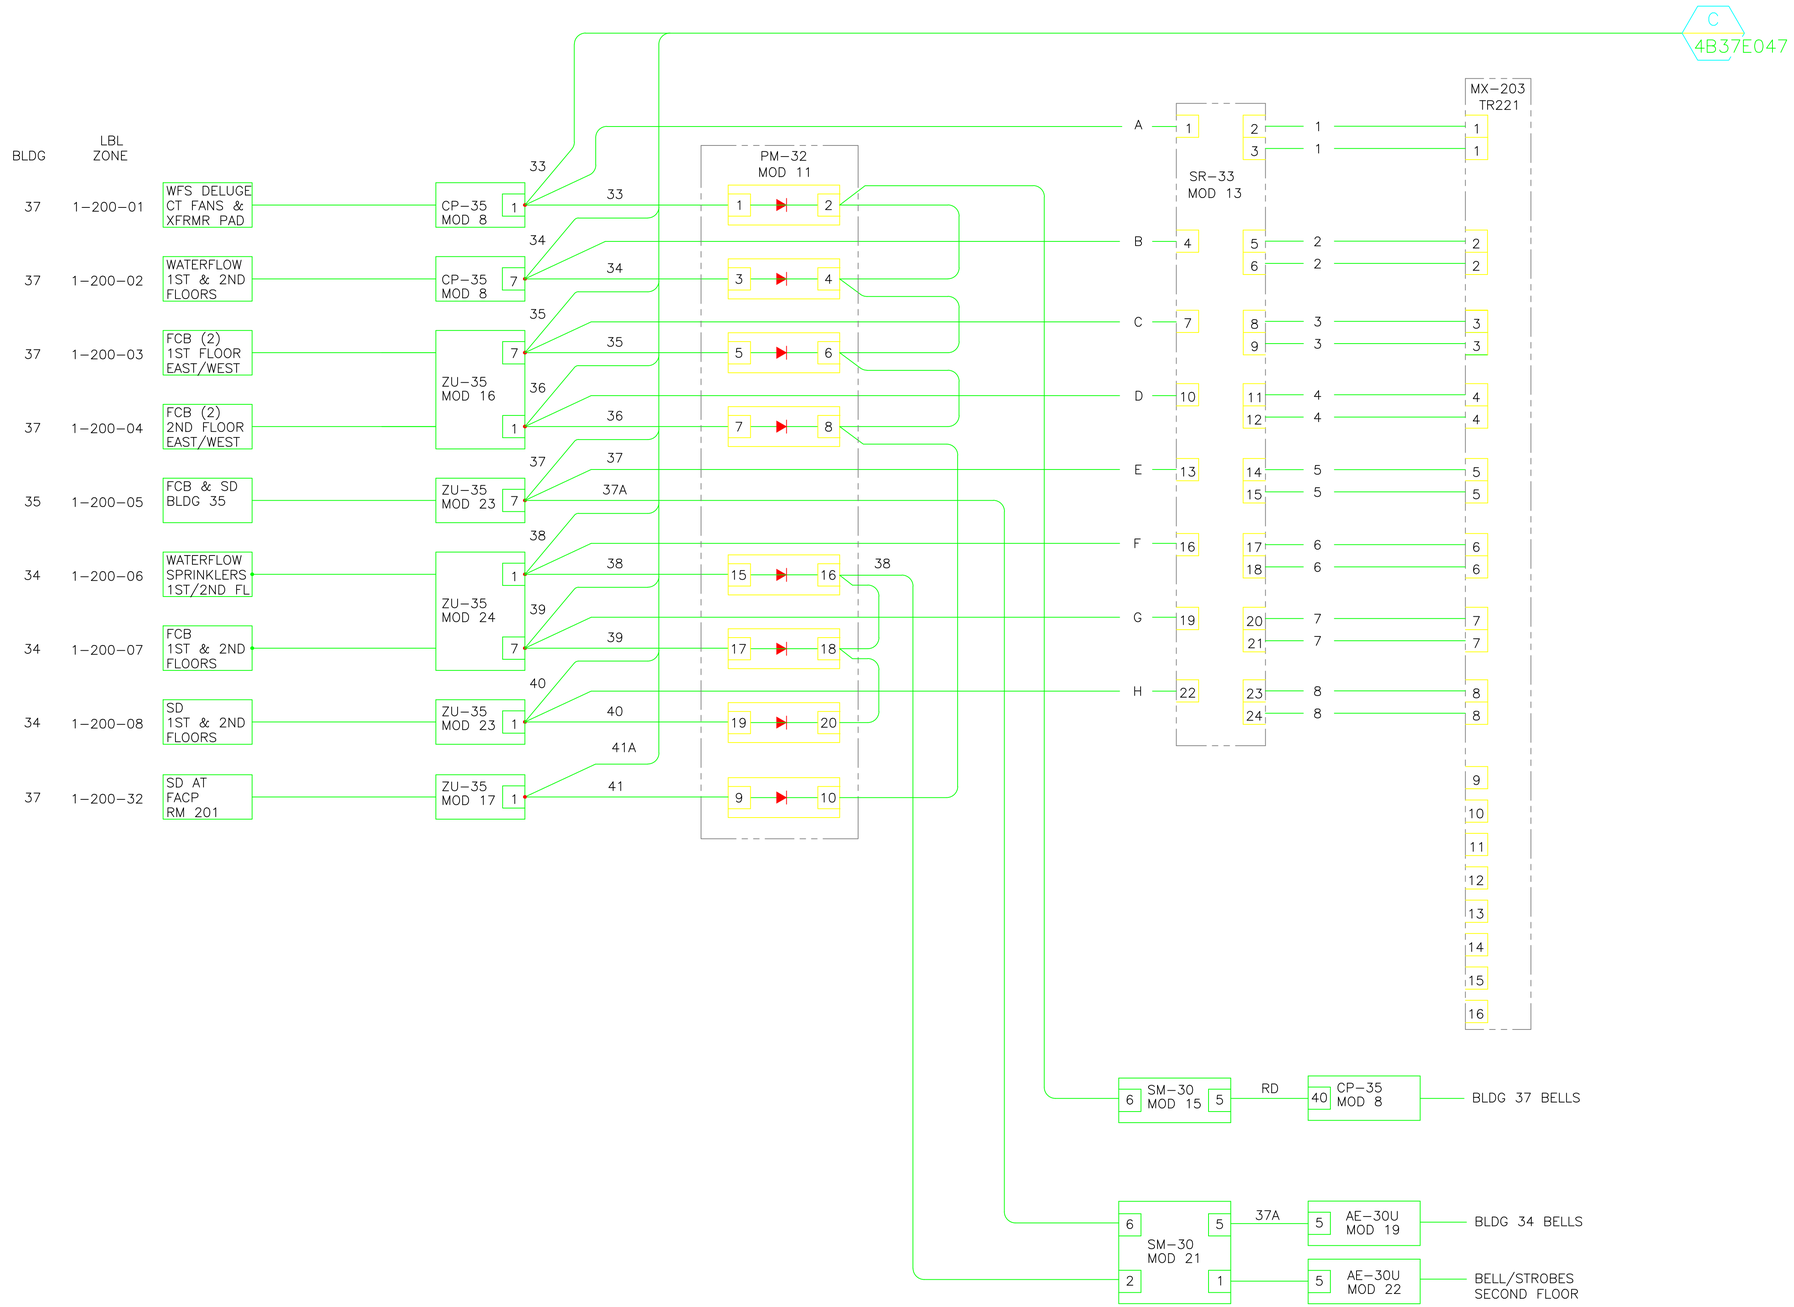

PROFESSIONAL SEAL (IF REVISION, APPLIES ONLY TO REVISED WORK)	ISSUE (PROGRESS, ESTIMATE, BID, CONSTRUCTION, CONFORMED, REVISION, RECORD)	REVISION NUMBER	DRAWN BY	CHECKED BY	APPR'D BY	DATE	REMARKS
	AS BUILT B 4/30/2013	B	LDD	LDD	MCD	4/30/13	AS-BUILT PER FIELD VERIFICATIONS
		A	AD	LDD	MCD	10/18/06	AS-BUILT RECORD DRAWING

37 BLDG'S 34, 35, 37
REPLACEMENT FIRE ALARM SYSTEM
LOGIC

UNIVERSITY OF CALIFORNIA
LAWRENCE BERKELEY NATIONAL LABORATORY
FACILITIES DIVISION

DRAWN BY HYT	DATE 3/30/2001	
CHECKED BY HYT	3/30/2001	
APPROVED BY		
CAD FILE PATH		
SCALE Full		
DRAWING NO. 4B37E045B		SHEET 1 OF 1
PROJECT NO. WE9379		