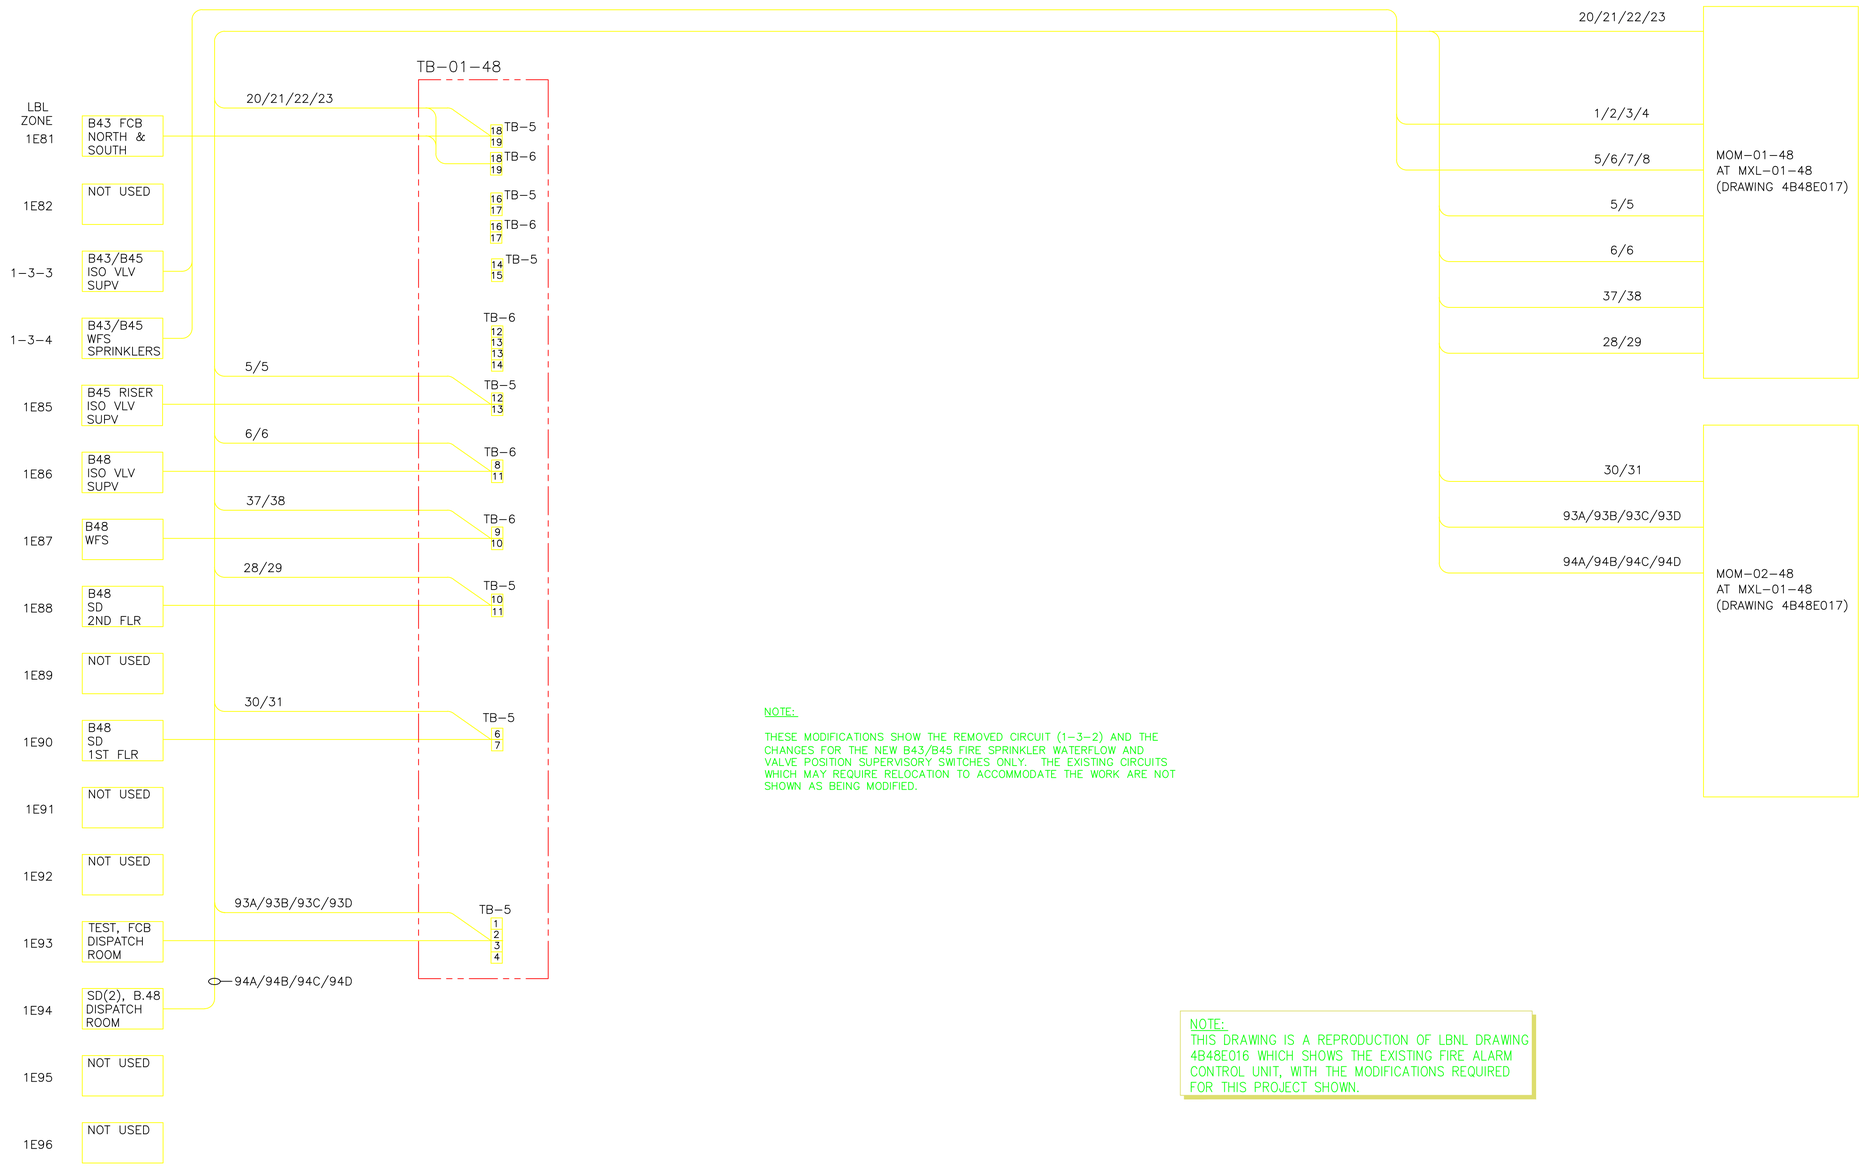

NOTE:

THESE MODIFICATIONS SHOW THE REMOVED CIRCUIT (1-3-2) AND THE CHANGES FOR THE NEW B43/B45 FIRE SPRINKLER WATERFLOW AND VALVE POSITION SUPERVISORY SWITCHES ONLY. THE EXISTING CIRCUITS WHICH MAY REQUIRE RELOCATION TO ACCOMMODATE THE WORK ARE NOT SHOWN AS BEING MODIFIED.

NOTE:
THIS DRAWING IS A REPRODUCTION OF LBNL DRAWING 4B48E016 WHICH SHOWS THE EXISTING FIRE ALARM CONTROL UNIT, WITH THE MODIFICATIONS REQUIRED FOR THIS PROJECT SHOWN.

HYT Corporation
Fire Protection Engineers and Consultants
3498 Clayton Road - Suite 101
Concord, California 94519
Phone: (925) 681-2731
FAX: (925) 681-2733
CONSULTING FIRM

CONSULTING FIRM

RPR
1629 Telegraph Avenue
Suite 200
Oakland, CA 94612
Tel 510 272 0654
Fax 510 444 0279
CONSULTING A/E FIRM

REGISTERED PROFESSIONAL ENGINEER
BRET B. TREADDER
No. 1165
Exp. 9/30/12
FIRE PROTECTION
STATE OF CALIFORNIA
PROFESSIONAL SEAL (IF REVISION, APPLIES ONLY TO REVISED WORK)

RECORD DRAWING - AS BUILT

ISSUE (PROGRESS, ESTIMATE, BID, CONSTRUCTION, CONFORMED, REVISION, AS-BUILT)

REVISION NUMBER	DRAWN BY	CHECKED BY	APPR'D BY	DATE	REMARKS
A	HYT	HYT		05.22.13	AS-BUILT RECORD DRAWING
2	HYT	HYT		12.02.11	100% CONSTRUCTION DOCUMENTS REVIEW COMMENTS
1	HYT	HYT		11.10.11	100% CONSTRUCTION DOCUMENTS
0	HYT	HYT		09.30.11	75% CONSTRUCTION DOCUMENTS

BUILDING 45
FIRE STATION REPLACEMENT

FIRE ALARM - NOTES & DETAILS

UNIVERSITY OF CALIFORNIA
LAWRENCE BERKELEY NATIONAL LABORATORY
FACILITIES DIVISION

DRAWN BY	HYT	DATE 05.22.13
CHECKED BY	HYT	05.22.13
APPROVED BY		
CAD FILE PATH		
SCALE	AS NOTED	
DRAWING NO.	4B45E023A	SHEET FA0.2
PROJECT NO.		35 OF 43