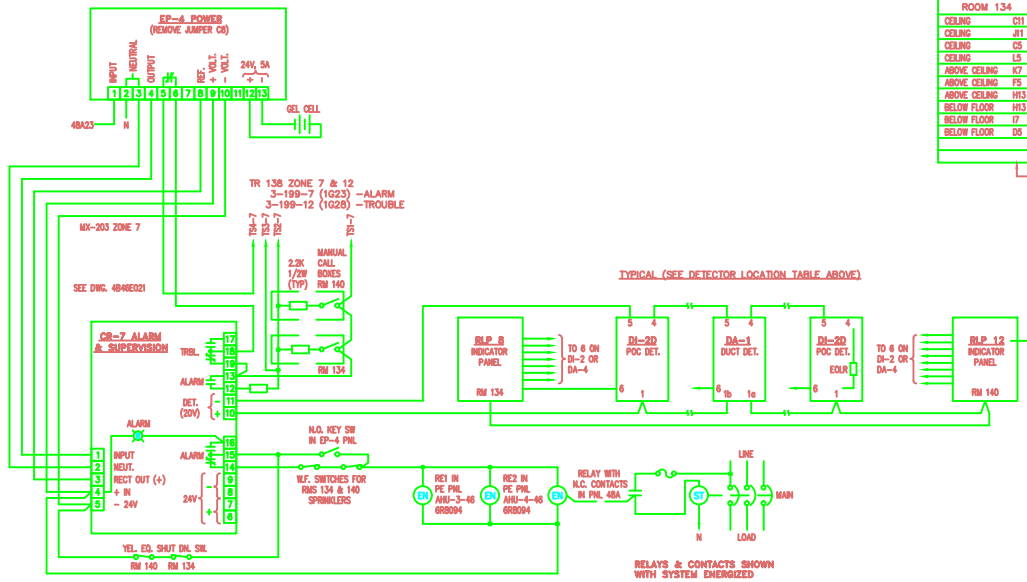

DETECTOR LOCATIONS			
ROOM 134		ROOM 140	
CEILING	C11	CEILING	M5
CEILING	J11	CEILING	F5
CEILING	C5	CEILING	F14
CEILING	L5	CEILING	M14
ABOVE CEILING	K7	ABOVE CEILING	M5
ABOVE CEILING	F5	ABOVE CEILING	F5
ABOVE CEILING	H13	ABOVE CEILING	F14
BELOW FLOOR	H13	ABOVE CEILING	M14
BELOW FLOOR	I7	BELOW FLOOR	M5
BELOW FLOOR	D5	BELOW FLOOR	F5
		BELOW FLOOR	F14
		BELOW FLOOR	M14

REFERENCE DWGS:

4B46E021 FIRE ALARM SYSTEM
4B46E023 LAYOUT
WAS 6R8103

DISTRIBUTION LIST:

2 - ELECTRIC SHOP B76 (FILE I & II)
1 - B90J (FILE III)
1 - STICK FILE
ORIGINAL - FLAT FILE B90F

WAS 3B46E019

REVISION NUMBER	DRAWN BY	CHECKED BY	APPROVED BY	DATE	REMARKS
E	LM	ROB	MCG	8/18/88	AUTOCAD CONVERSION
D	RG	LSR		11/85	AS BUILT
C	HW			2/84	REDRAWN

46 FIRE ALARM
ROOMS 134 & 140
WIRING DIAGRAM

UNIVERSITY OF CALIFORNIA LAWRENCE BERKELEY LABORATORY
FACILITIES DEPARTMENT

DRAWN BY	HW
DATE	7/14/84
CHECKED BY	–
APPROVED BY	BHS
DATE	2/84
CAD FILE PATH	00007152
SCALE	–
DRAWING NO.	4B46E019E
SHEET	—
PROJECT NO.	FA8040
	1 OF 1