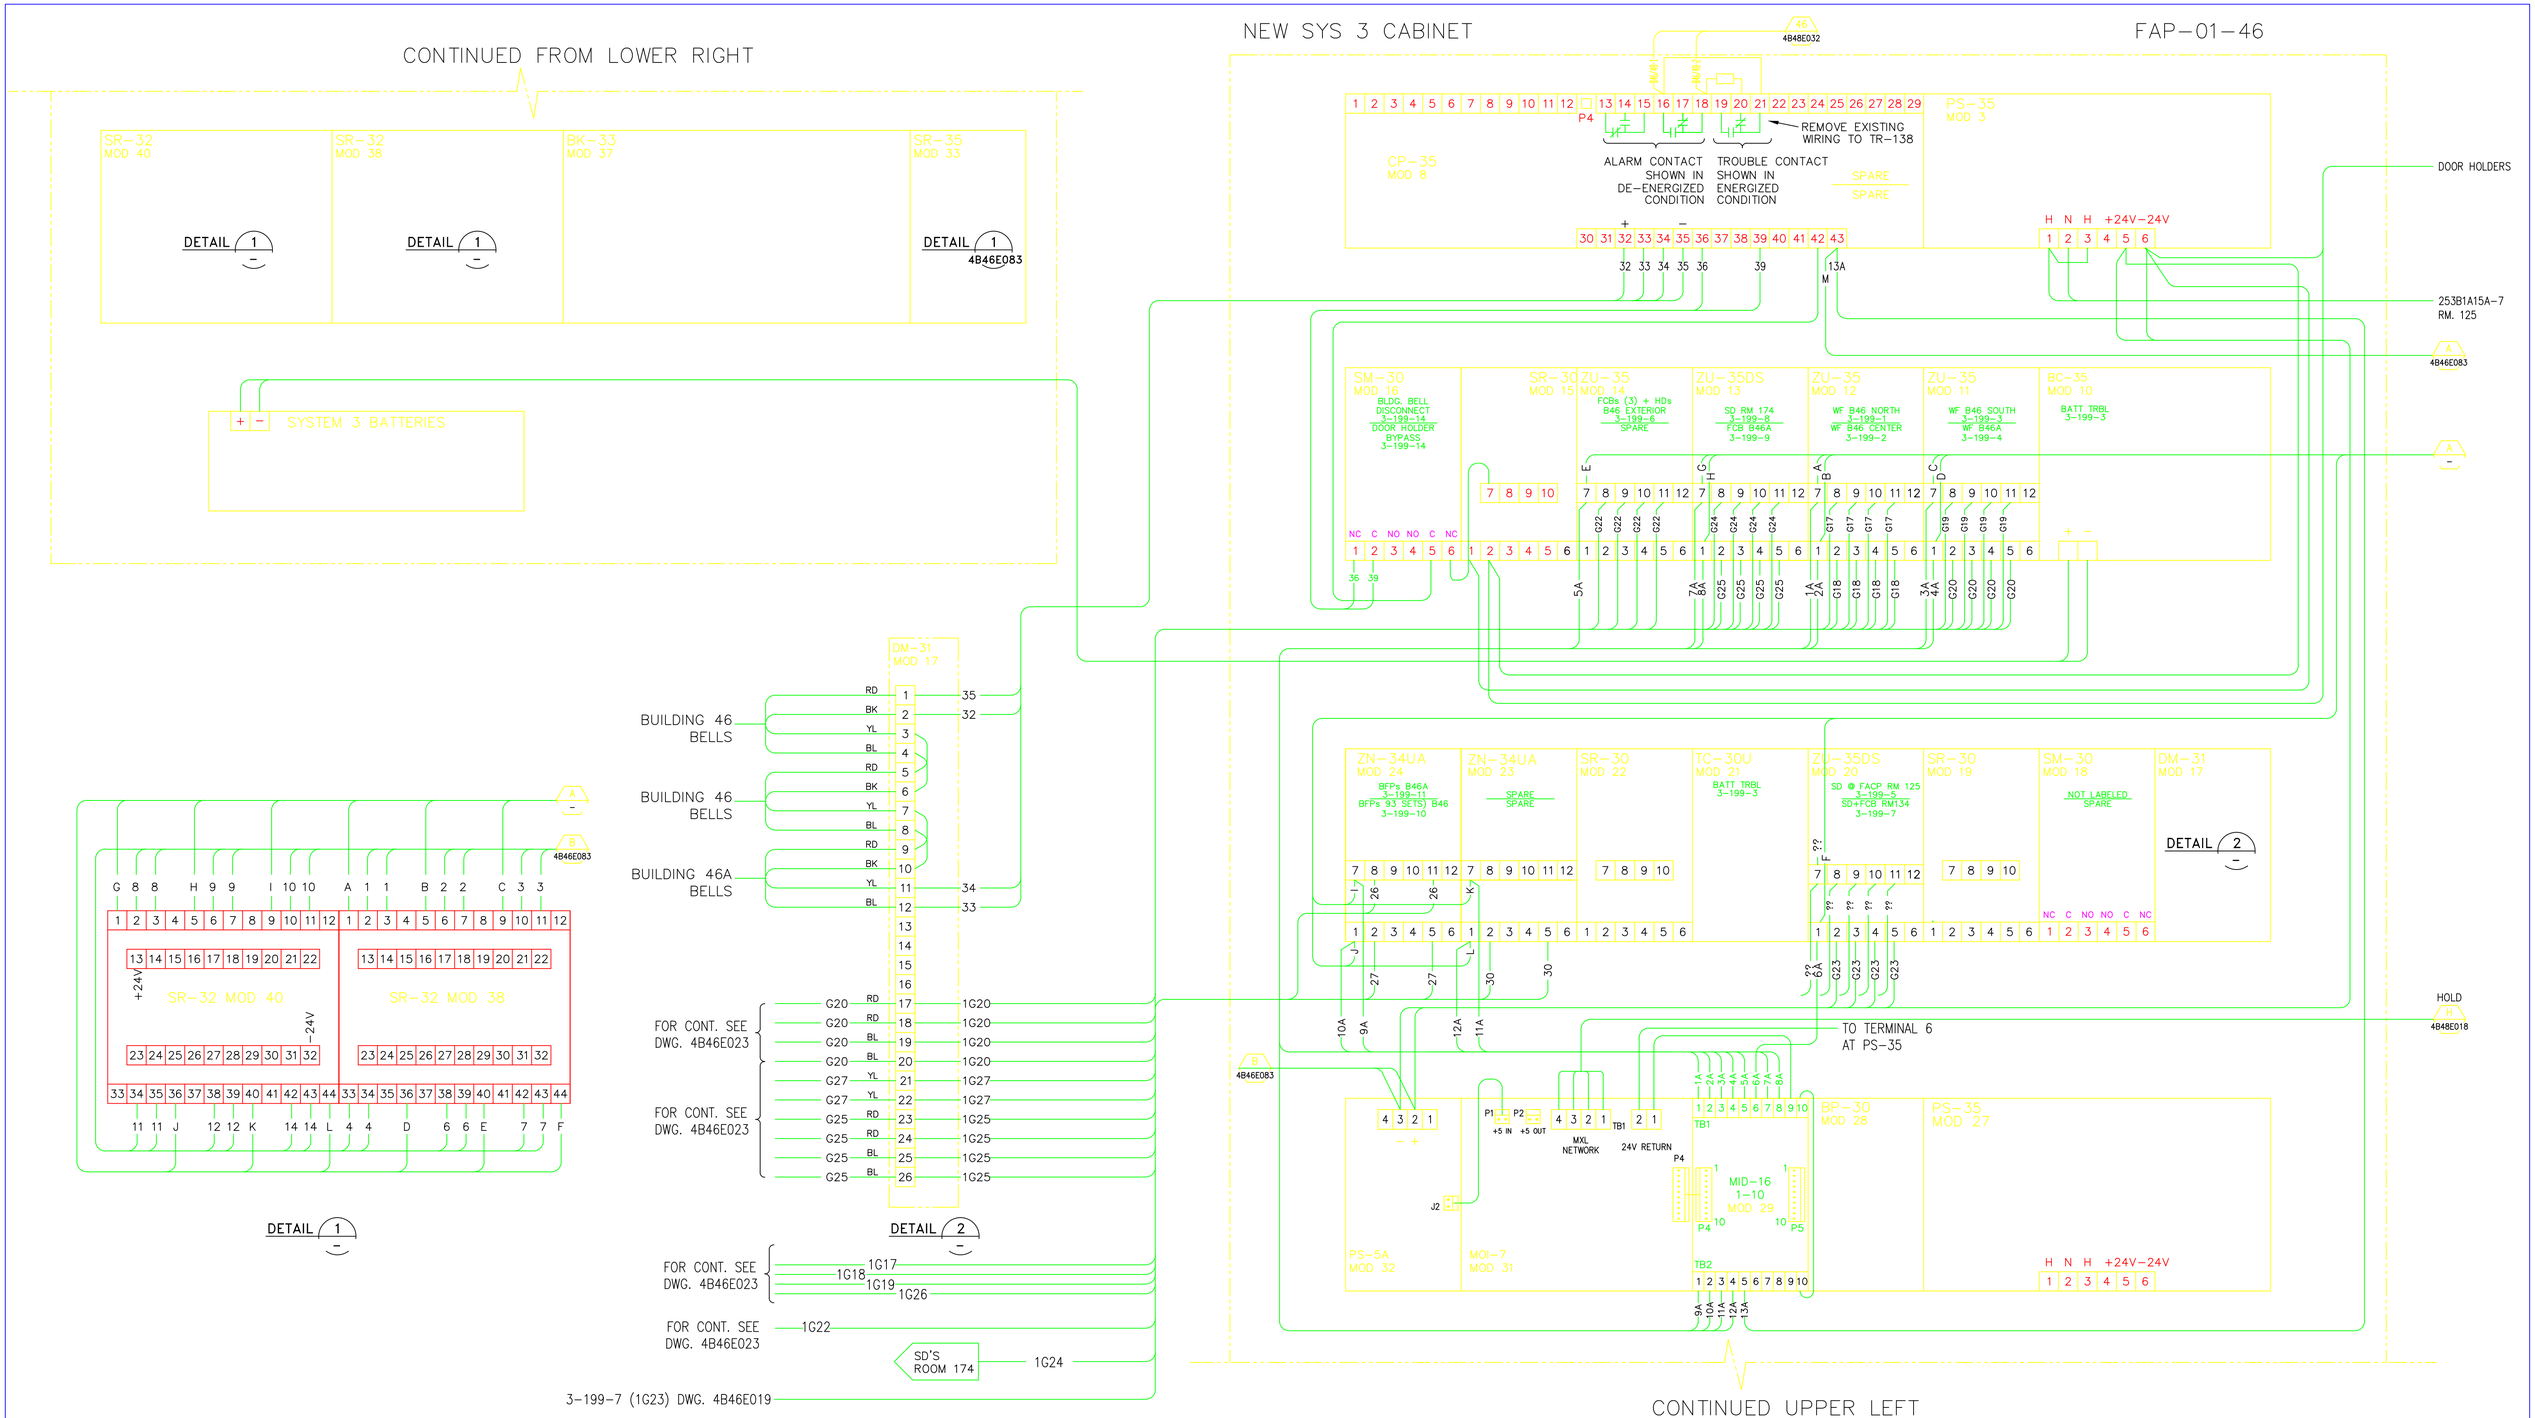

NOTES:

1. SR-32 RELAYS NOT FIELD VERIFIED. FIELD TO VERIFY CONNECTION, PROVIDE WIRE NUMBERS AND AS-BUILT DRAWING.

REFERENCE DRAWINGS:

4B46E018 ROOM 137 HAKON SYSTEM

4B46E023 BLDG 46 FIRE ALARM SYSTEM LAYOUT

AS BUILT	F	LDD	LDD	MCD	05/01/13	AS-BUILT PER FIELD VERIFICATIONS
	E	AD	LDD	MCD	11/10/05	AS-BUILT RECORD DRAWING
	D	AD	MCG	MCG	05/07/05	REVISED FOR MXL/DIGITIZE SYSTEMS
	C	AD	AD	MCG	11/21/03	AS-BUILT, PHASE II FA UPGRADE
	B	HYT	HYT	–	–	FIRE ALARM REPLACEMENT PROJECT
	A	LM		MCG	4/25/97	REDRAWN ON AUTOCAD
PROFESSIONAL SEAL (IF REVISION, APPLIES ONLY TO REVISED WORK)	ISSUE (PROGRESS, ESTIMATE, BID, CONSTRUCTION, CONFORMED, REVISION, RECORD)	REVISION NUMBER	DRAWN BY	CHECKED BY	APPR'D BY	DATE	REMARKS

5/1/2013

46 BLDG 46

FIRE ALARM SYSTEM SYSTEM 3

UNIVERSITY OF CALIFORNIA
LAWRENCE BERKELEY NATIONAL LABORATORY
FACILITIES DIVISION

DRAWN BY HYT	DATE 6/1/2001	
CHECKED BY HYT	6/1/2001	
APPROVED BY		
CAD FILE PATH		
SCALE Full		
DRAWING NO. 4B46E071F		SHEET 1 OF 1
PROJECT NO. WE9379		