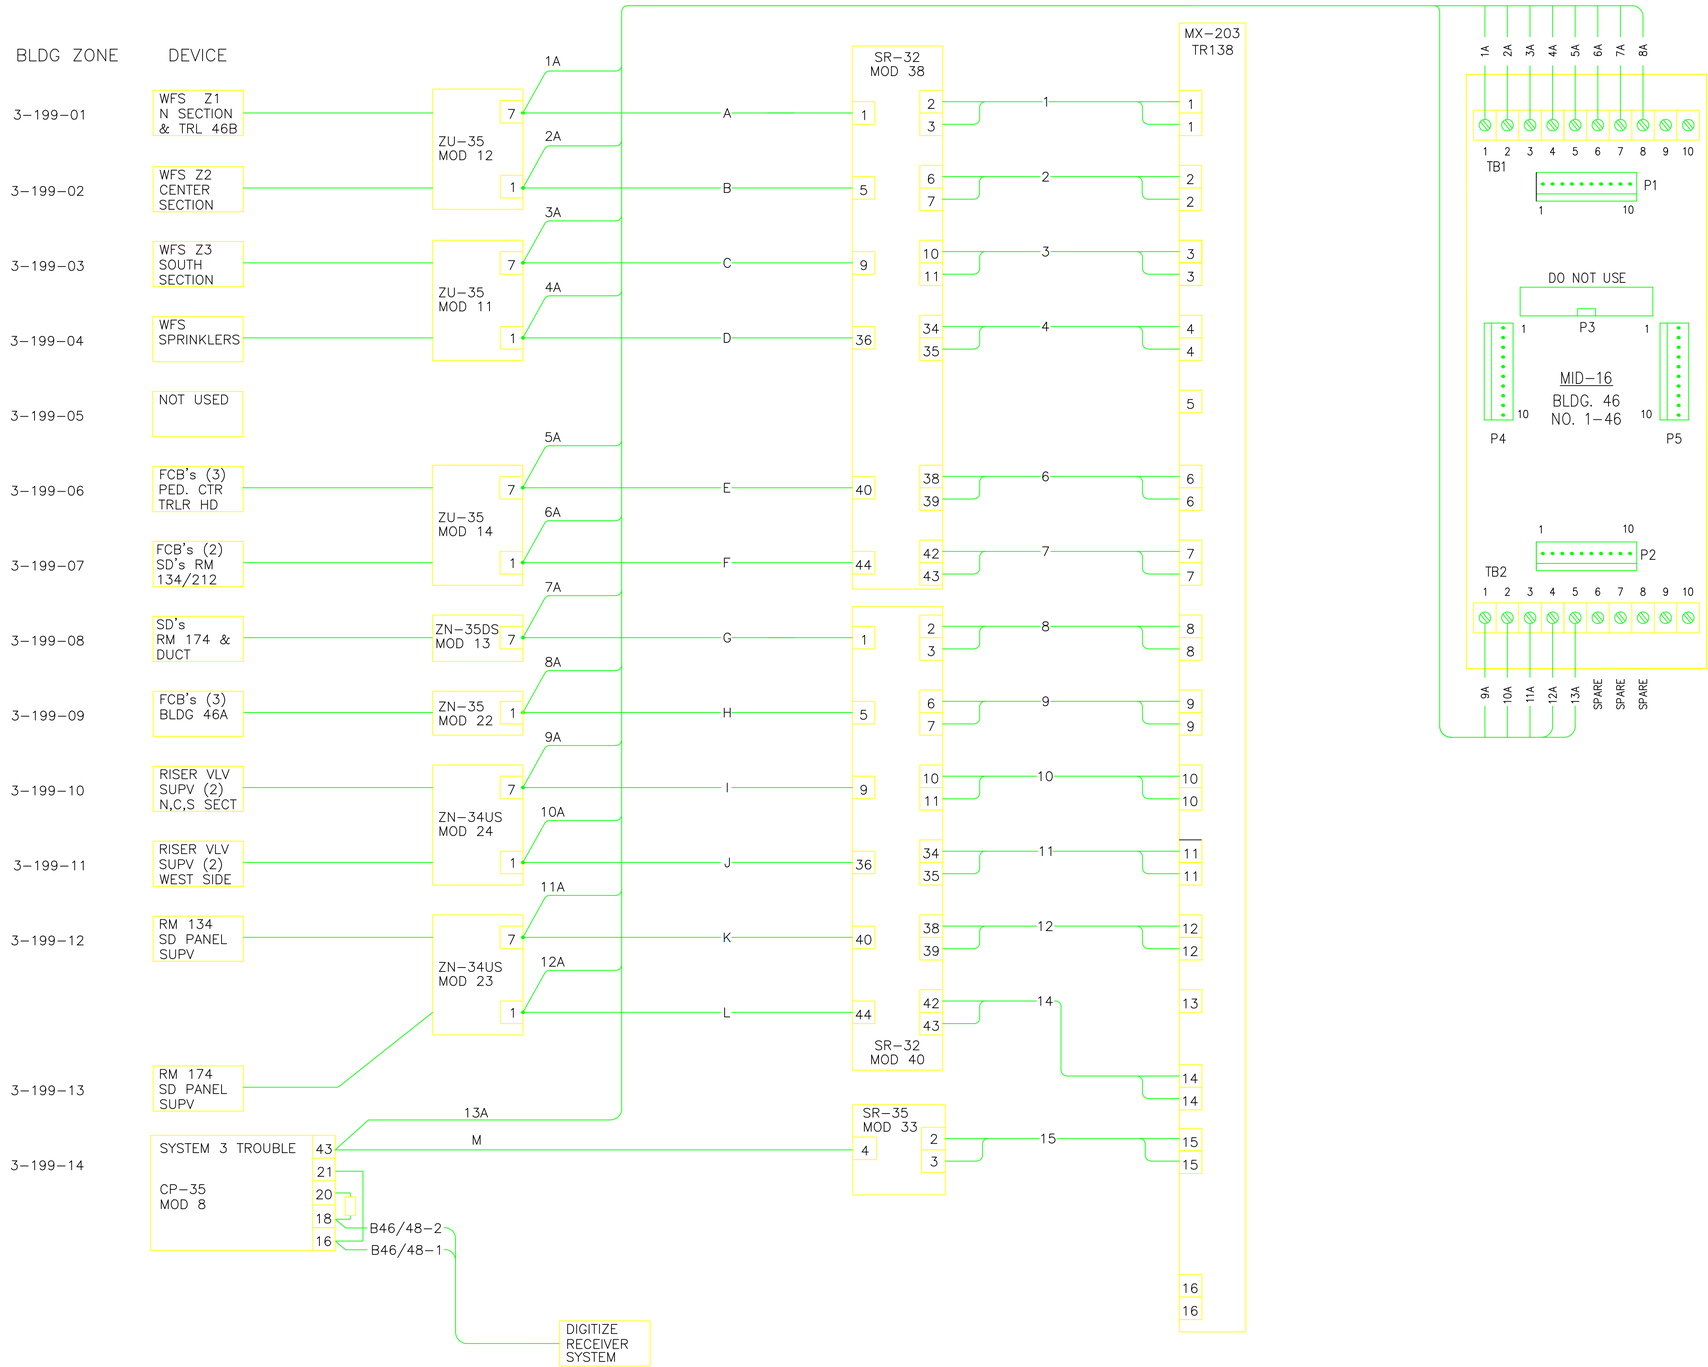

BELL CIRCUIT

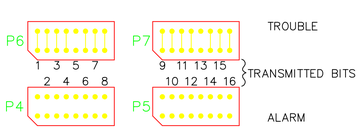

PROGRAM PLUG SETTINGS

TRANSMITTER ID SWITCH

000100101 (37 + 1 = 38)

TRANSMITTER NO. 138

AS BUILT

C

5/1/2013

REVISION NUMBER	DRAWN BY	CHECKED BY	APPR'D BY	DATE	REMARKS
C	LDD	LDD	MCD	05/01/13	AS BUILT PER FIELD VERIFICATIONS
B	AD	MCG	MCG	04/08/05	REVISED FOR MXL/DIGITIZE SYSTEM
A	AD	AD	MCG	11/21/03	AS-BUILT, PHASE II FA UPGRADE

PROFESSIONAL SEAL (IF REVISION, APPLIES ONLY TO REVISED WORK)

ISSUE (PROGRESS, ESTIMATE, BID, CONSTRUCTION, CONFORMED, REVISION, RECORD)

46 BLDG 46

REPLACEMENT FIRE ALARM SYSTEM

FIELD DEVICE CONNECTIVITY

UNIVERSITY OF CALIFORNIA
LAWRENCE BERKELEY NATIONAL LABORATORY
FACILITIES DIVISION

DRAWN BY HYT DATE 3/30/2001
CHECKED BY HYT 3/30/2001
APPROVED BY
CAD FILE PATH
SCALE Full
DRAWING NO. 4B46E072C
SHEET 1 OF 1
PROJECT NO. WE9379