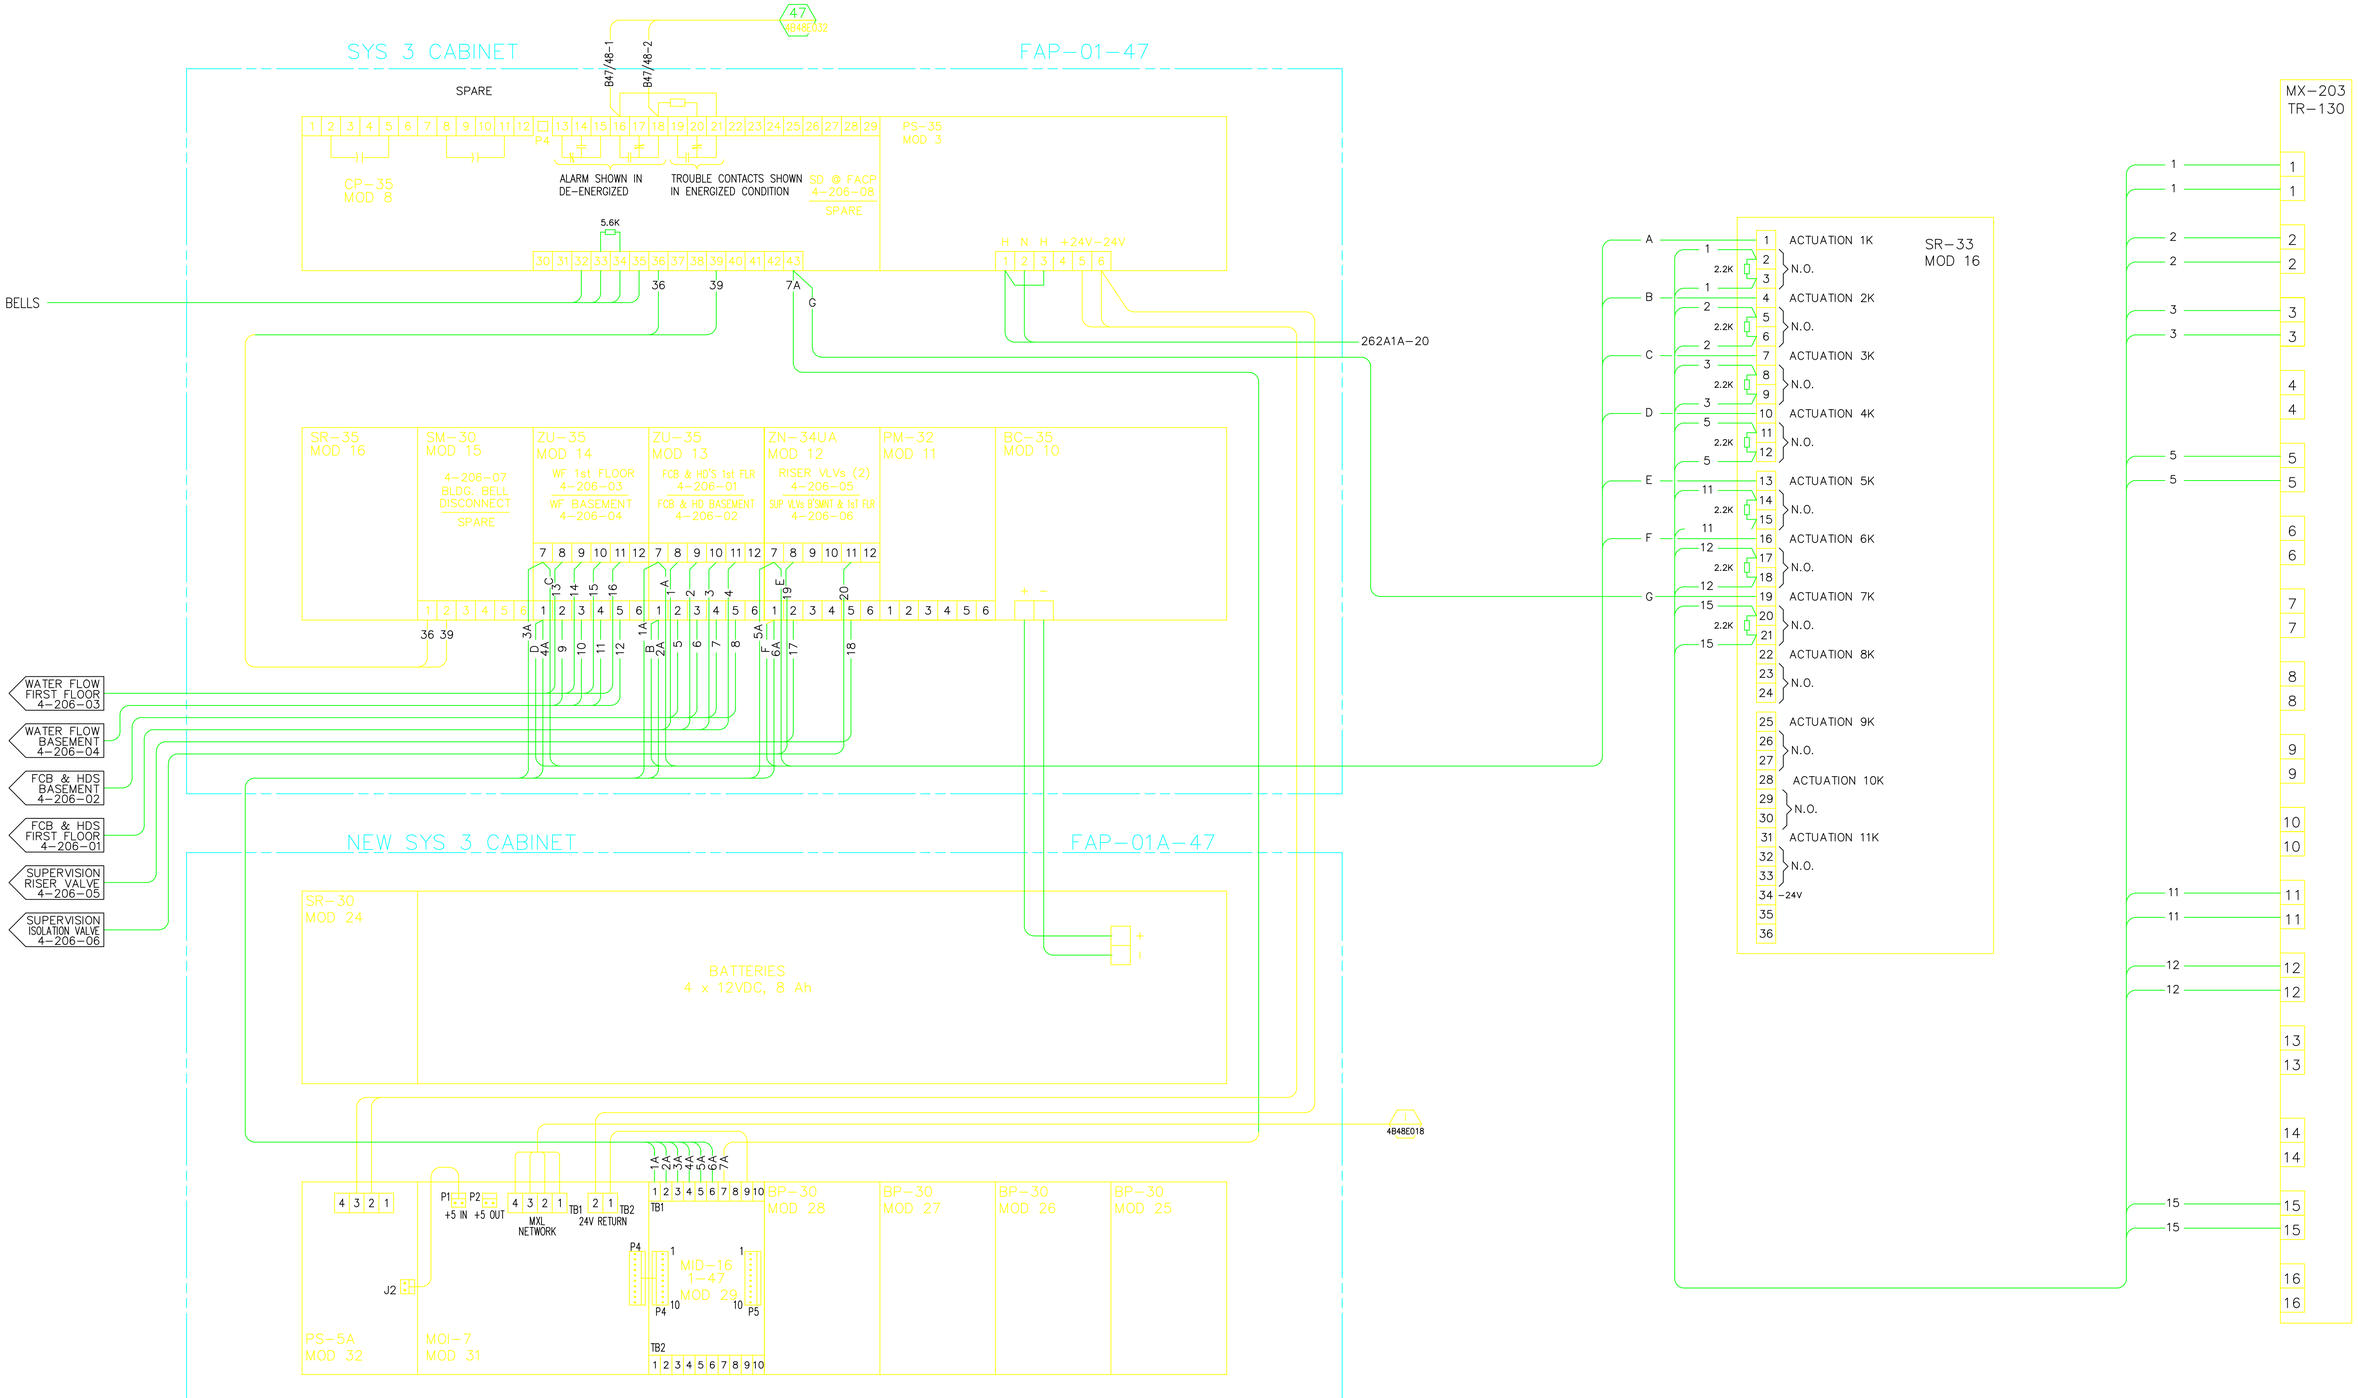

REVISION NUMBER	DRAWN BY	CHECKED BY	APPR'D BY	DATE	REMARKS
F	LDD	LDD	MCD	05/01/13	AS BUILT PER FIELD VERIFICATIONS
E	AD	MCG	MCG	04/20/05	REVISED FOR MXL/DIGITIZE SYSTEMS
D	MRC	AD	MCG	12/17/03	AS-BUILT, PHASE II FA UPGRADE
C	HYT	HYT	–	-	DRAWN IN AUTOCAD & REPLACEMENT FIRE ALARM PROJECT

47 BLDG 47

FIRE ALARM SYSTEM INTERCONNECTION DIAGRAM

UNIVERSITY OF CALIFORNIA
LAWRENCE BERKELEY NATIONAL LABORATORY
FACILITIES DEPARTMENT

DRAWN BY	HYT	DATE 4/12/2001
CHECKED BY	HYT	4/12/2001
APPROVED BY		
CAD FILE PATH		
SCALE	Full	
DRAWING NO.	4B47E002F	SHEET
PROJECT NO.	FA8040	1 OF 1