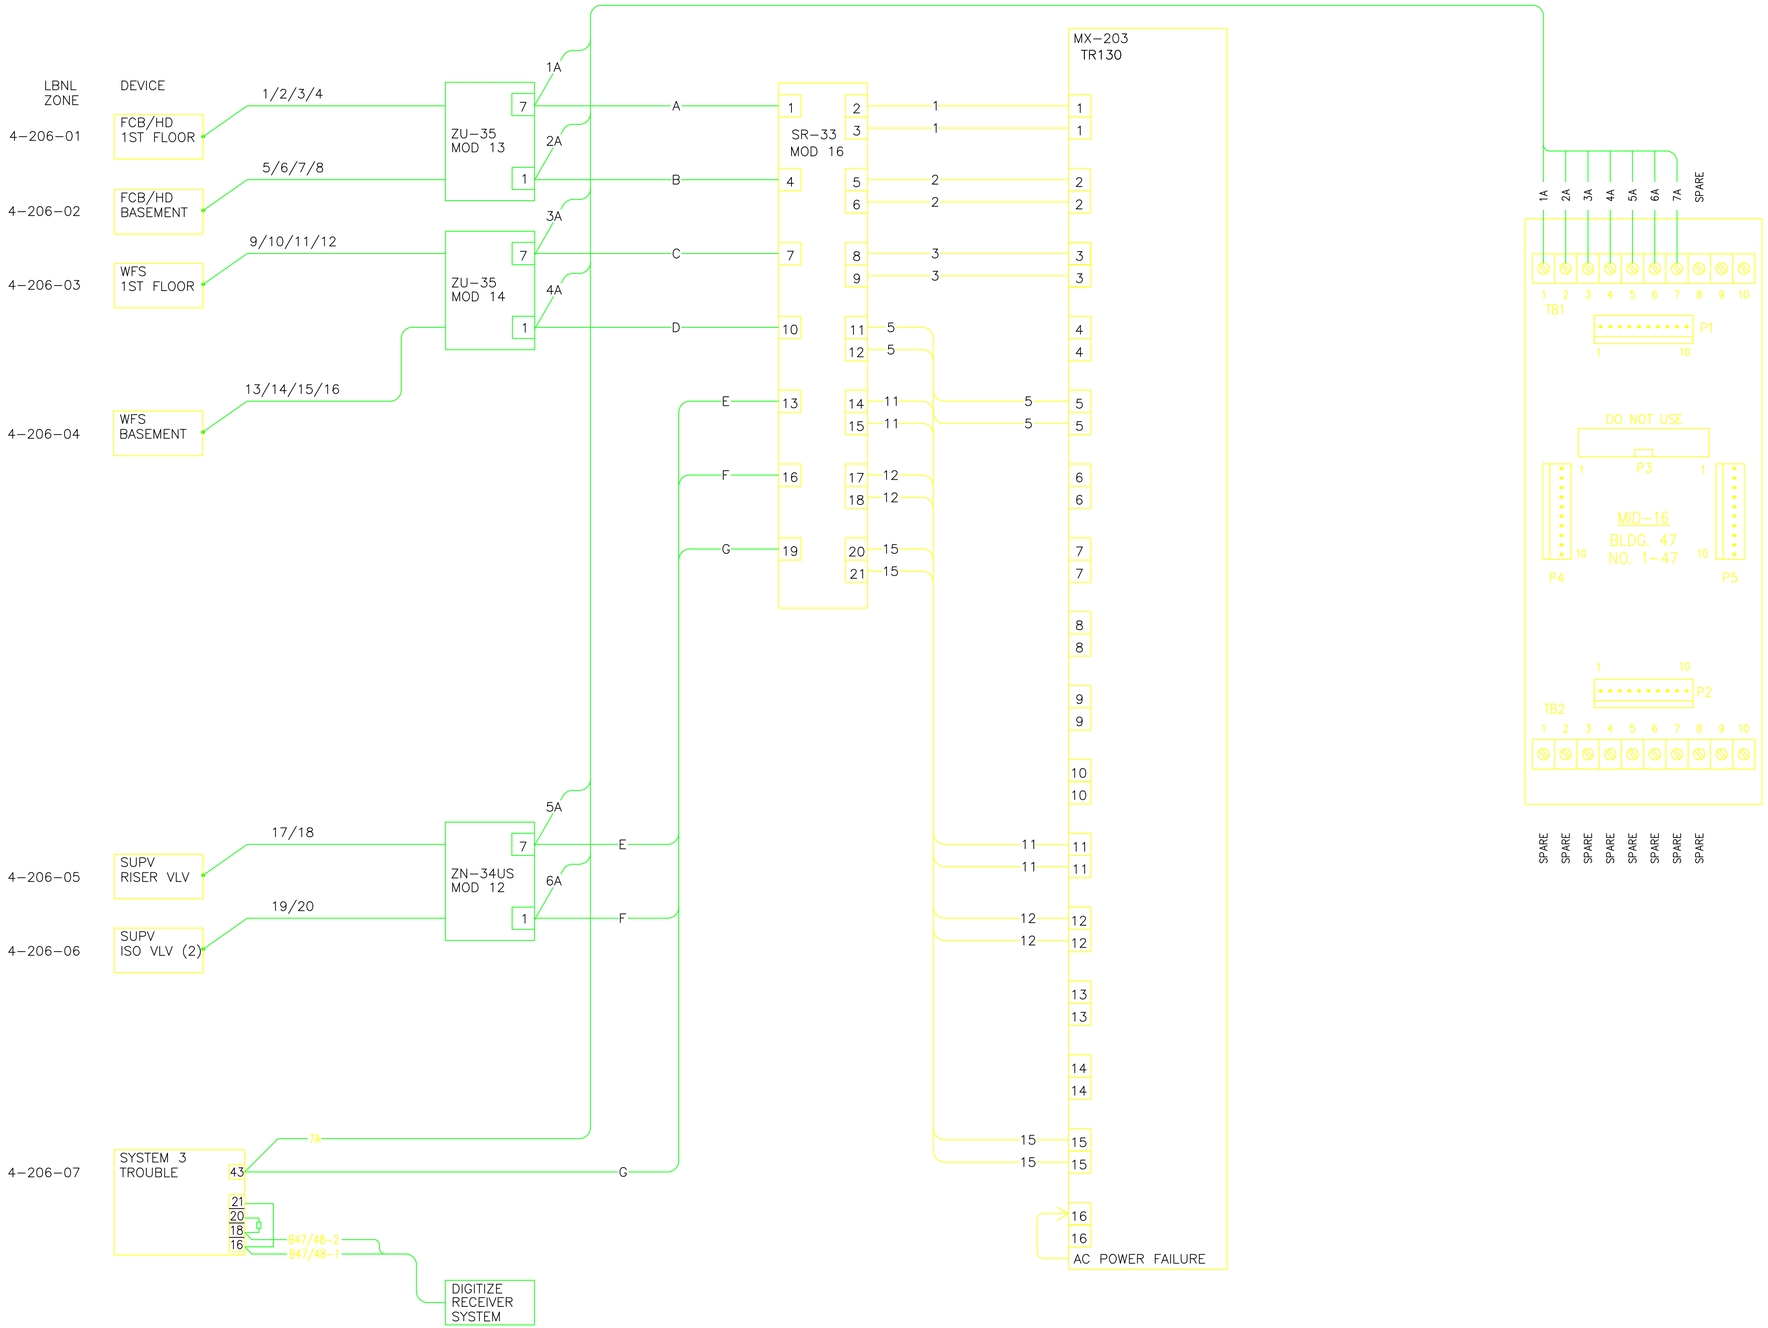

	AS BUILT						
	C						
	5/1/2013						
		C	LDD	LDD	MCD	05/01/13	AS BUILT PER FIELD VERIFICATIONS
		B	RZT	MCG	MCG	4/15/05	REVISED FOR DIGITIZE SYSTEM.
		A	AD	AD	MCG	12/17/03	AS-BUILT, PHASE II FA UPGRADE
PROFESSIONAL SEAL (IF REVISION, APPLIES ONLY TO REVISED WORK)	ISSUE (PROGRESS, ESTIMATE, BID, CONSTRUCTION, CONFORMED, REVISION, RECORD)	REVISION NUMBER	DRAWN BY	CHECKED BY	APPR'D BY	DATE	REMARKS

47
REPLACEMENT FIRE ALARM SYSTEM
LOGIC DIAGRAM

UNIVERSITY OF CALIFORNIA
LAWRENCE BERKELEY NATIONAL LABORATORY
FACILITIES DIVISION

DRAWN BY HYT	DATE 3/30/2001		
CHECKED BY HYT	3/30/2001		
APPROVED BY			
CAD FILE PATH			
SCALE Full			
DRAWING NO. 4B47E004C		SHEET 1 OF 1	
PROJECT NO. FA8040			