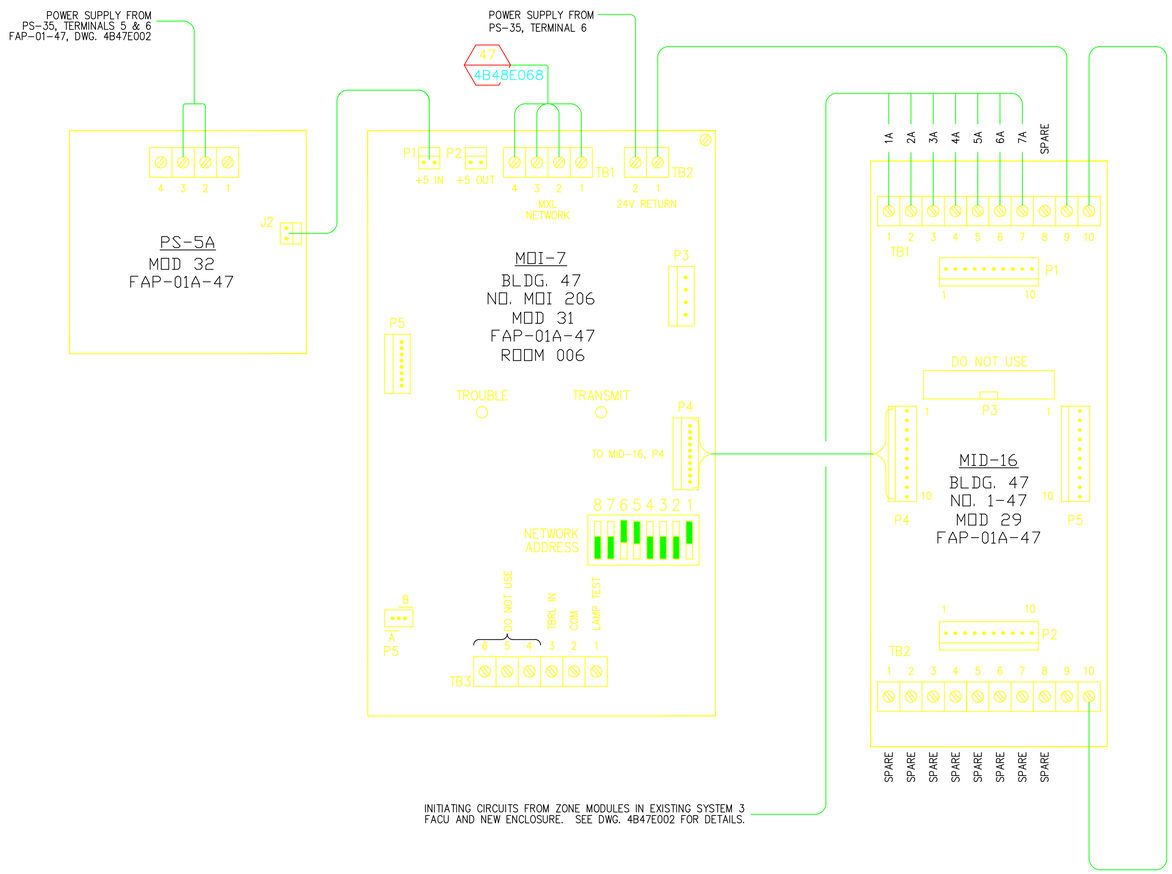

OLD ADDRESS	DESCRIPTION	MID-16 TERMINATION	MODULE TYPE & NO.	MXL NO. 04-02 ADDRESS
1D01	FCB/HD 1ST FLOOR	TB. 1 NO. 1	MID-16 NO. 1-47	4-206-1
1D02	FCB/HD BASEMENT	TB. 1 NO. 2	MID-16 NO. 1-47	4-206-2
1D03	WATERFLOW 1ST FLOOR	TB. 1 NO. 3	MID-16 NO. 1-47	4-206-3
1D04	NOT USED	N/A	N/A	N/A
1D05	WATERFLOW BASEMENT	TB. 1 NO. 4	MID-16 NO. 1-10	4-206-4
1D06	NOT USED	N/A	N/A	N/A
1D07	NOT USED	N/A	N/A	N/A
1D08	NOT USED	N/A	N/A	N/A
1D09	NOT USED	N/A	N/A	N/A
1D10	NOT USED	N/A	N/A	N/A
1D11	RISER VALVE SUPERVISION	TB. 1 NO. 5	MID-16 NO. 1-10	4-206-5
1D12	ISO VALVE (2) SUPERVISION	TB. 1 NO. 6	MID-16 NO. 1-10	4-206-6
1D13	NOT USED	N/A	N/A	N/A
1D14	NOT USED	N/A	N/A	N/A
1D15	SYSTEM 3 SUPV	TB. 2 NO. 7	MID-16 NO. 1-10	1-206-7
1D16	MX-203 SUPV	N/A	N/A	N/A

AS BUILT

C
5/1/2013

REVISION NUMBER	DRAWN BY	CHECKED BY	APPR'D BY	DATE	REMARKS
C	LDD	LDD	MCD	05/01/13	AS BUILT PER FIELD VERIFICATIONS
B	AD	LDD	MCD	03/20/06	REVISED FOR MXL COPPER LOOP
A	MRC	AD	MCG	12/17/03	AS-BUILT, PHASE II FA UPGRADE

PROFESSIONAL SEAL (IF REVISION, APPLIES ONLY TO REVISED WORK)

ISSUE (PROGRESS, ESTIMATE, BID, CONSTRUCTION, CONFORMED, REVISION, RECORD)

47
REPLACEMENT FIRE ALARM SYSTEM
MOI/MID MODULE ARRANGEMENT

UNIVERSITY OF CALIFORNIA
LAWRENCE BERKELEY NATIONAL LABORATORY
FACILITIES DIVISION

DRAWN BY HYT — DATE 3/30/2001
CHECKED BY HYT — 3/30/2001
APPROVED BY
CAD FILE PATH
SCALE Full
DRAWING NO. 4B47E005C
SHEET 1 OF 1
PROJECT NO. FA8040