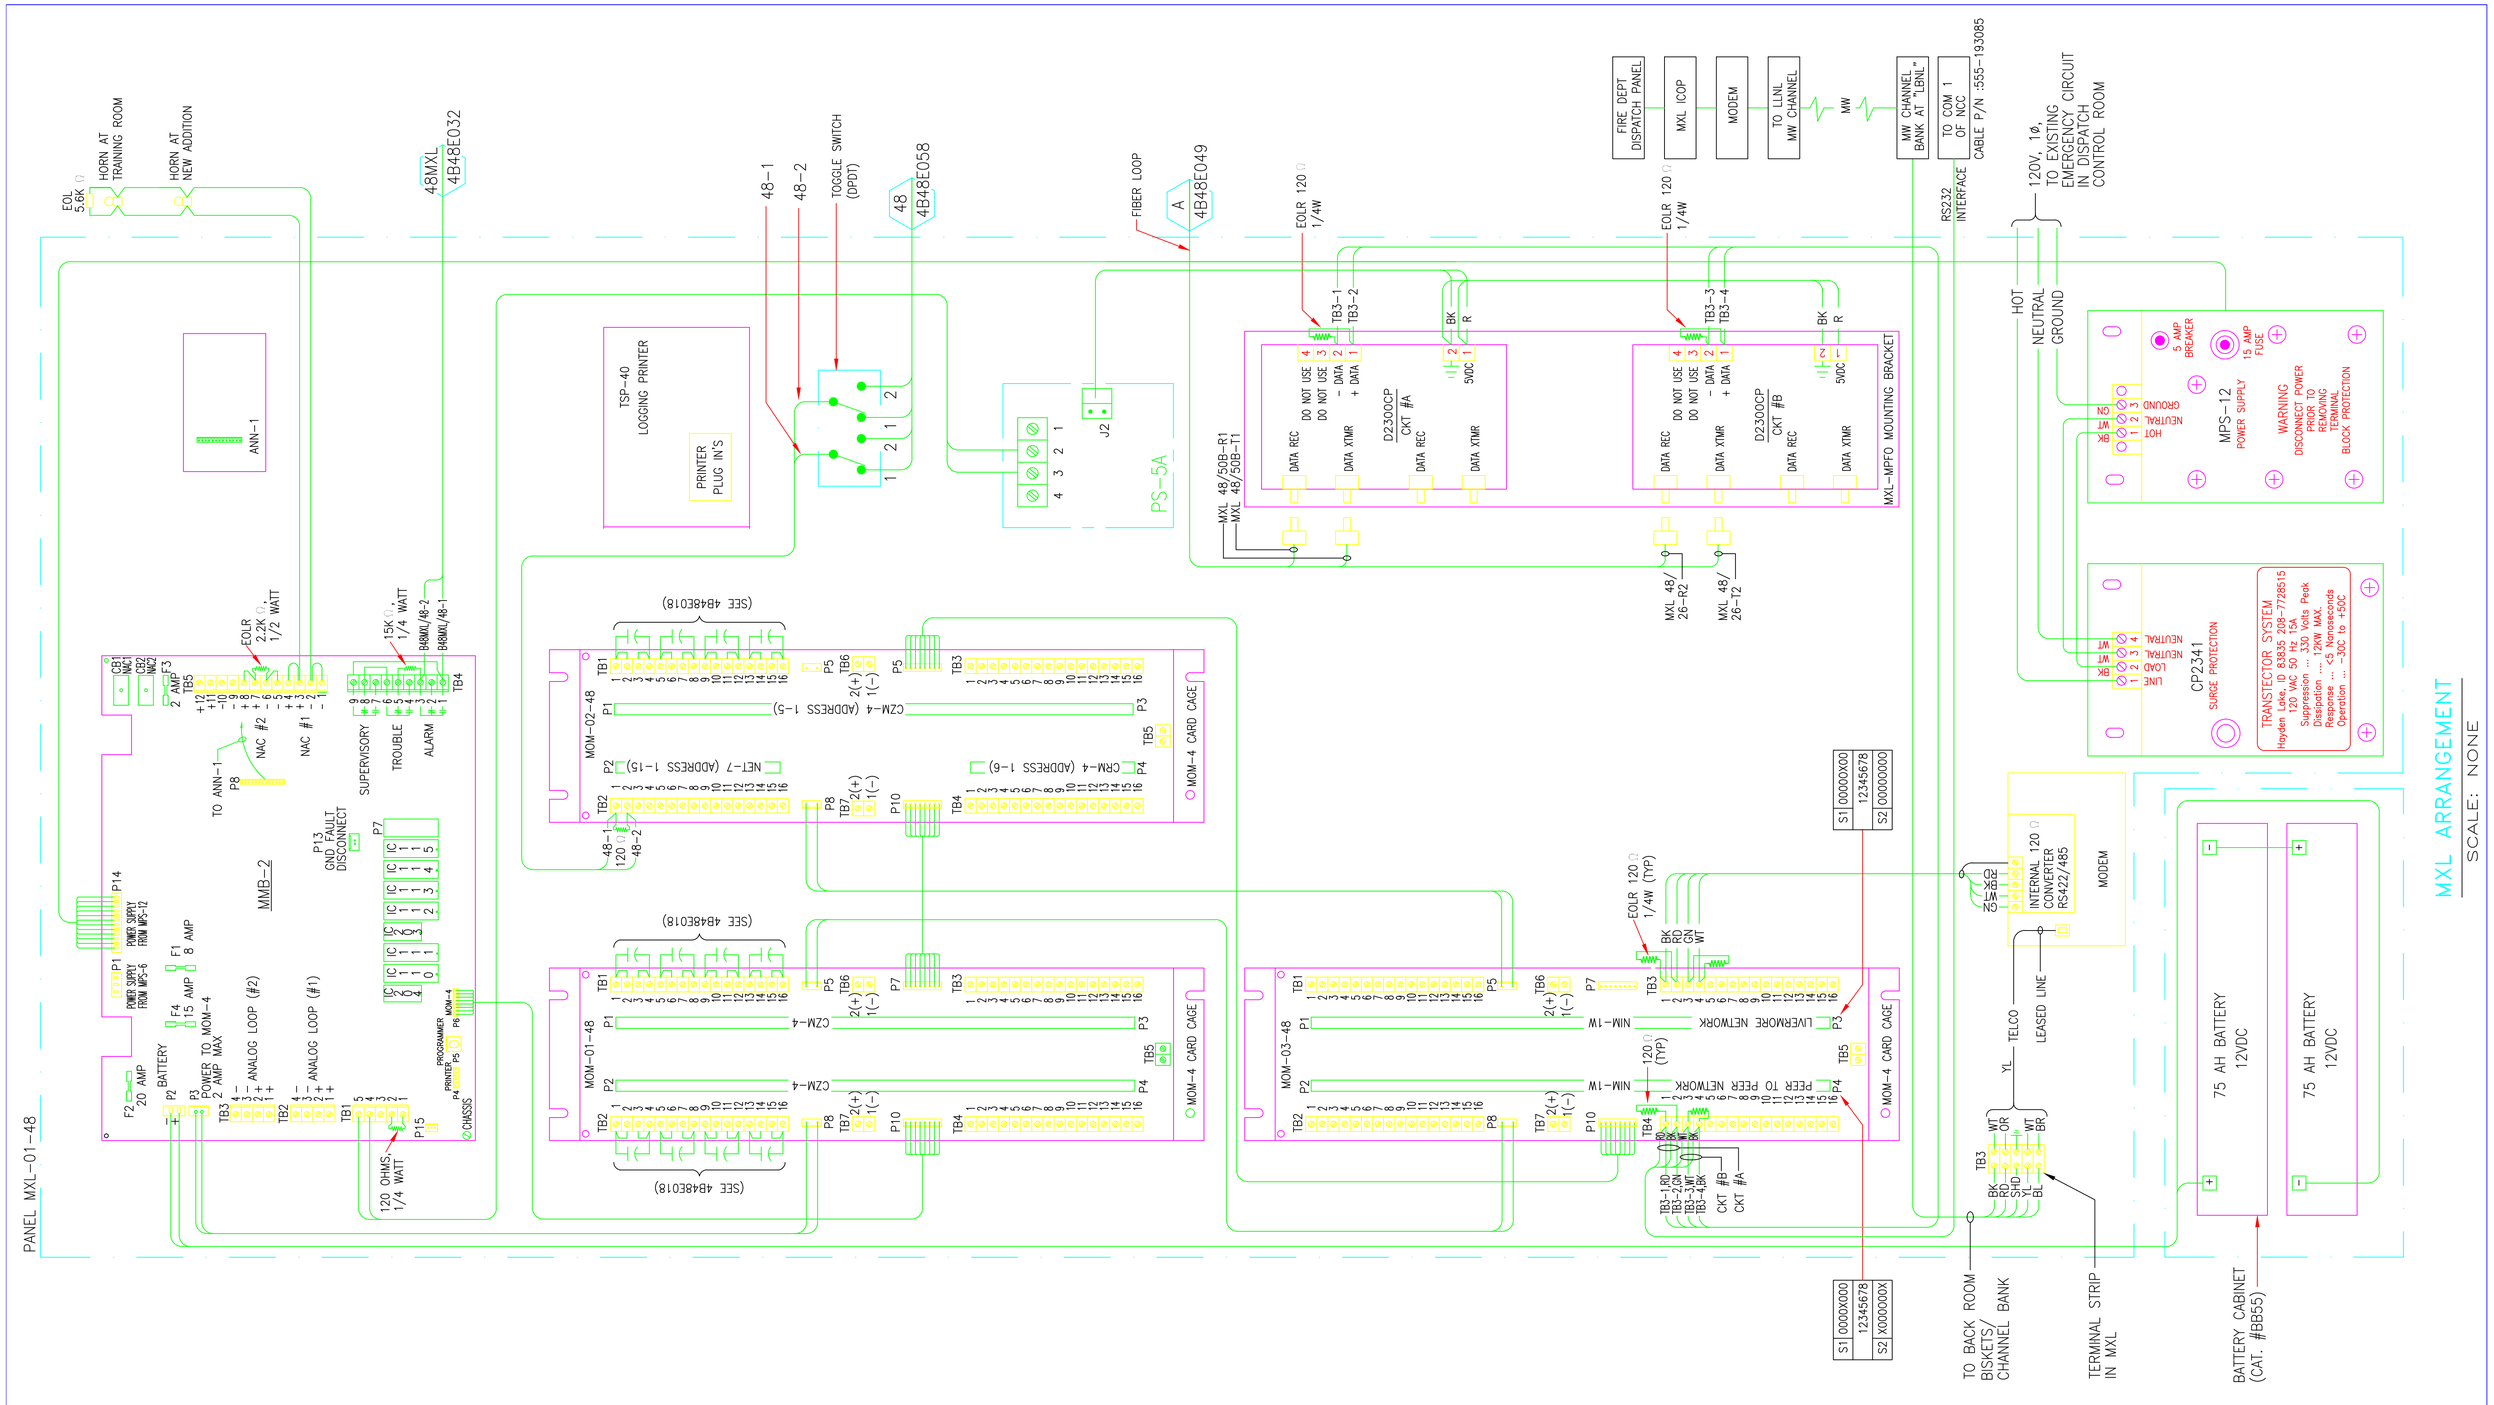

	AS BUILT	G	LDD	LDD	MCD	05/07/13	AS-BUILT PER FIELD VERIFICATIONS
		F	AD	LDD	MCD	01/24/07	AS-BUILT RECORD DRAWING, PER CLIENT COMMENTS
		E	AD	LDD	MCD	10/31/06	AS-BUILT RECORD DRAWING, PER CLIENT COMMENTS
		D	AD	LDD	MCD	08/18/06	AS-BUILT RECORD DRAWING
	G	C	AD	LDD	MCD	02/16/06	REVISED FOR MXL COPPER LOOP
	5/7/2013	B	AD	MCG	MCG	12/05/05	REVISED PER SIEMENS REVIEW
		A	AD	MCG	MCG	06/14/05	REVISED FOR MXL INSTALLATION
PROFESSIONAL SEAL (IF REVISION, APPLIES ONLY TO REVISED WORK)	ISSUE	(PROGRESS, ESTIMATE, BID, CONSTRUCTION, CONFORMED, REVISION, RECORD)	REVISION NUMBER	DRAWN BY	CHECKED BY	APPR'D BY	DATE / REMARKS

48 FIRE ALARM

MXL FIRE ALARM SYSTEM, LOOP #1

MXL #1 FAP ARRANGEMENT/WIRING DIAG

UNIVERSITY OF CALIFORNIA
LAWRENCE BERKELEY NATIONAL LABORATORY
FACILITIES DIVISION

DRAWN BY	AD	DATE 6/11/2005
CHECKED BY	MCG	6/11/2005
APPROVED BY	MCG	6/11/2005
CAD FILE PATH		
SCALE	Full	
DRAWING NO.	4B48E017G	SHEET FA
PROJECT NO.	FE5200	1 OF 1