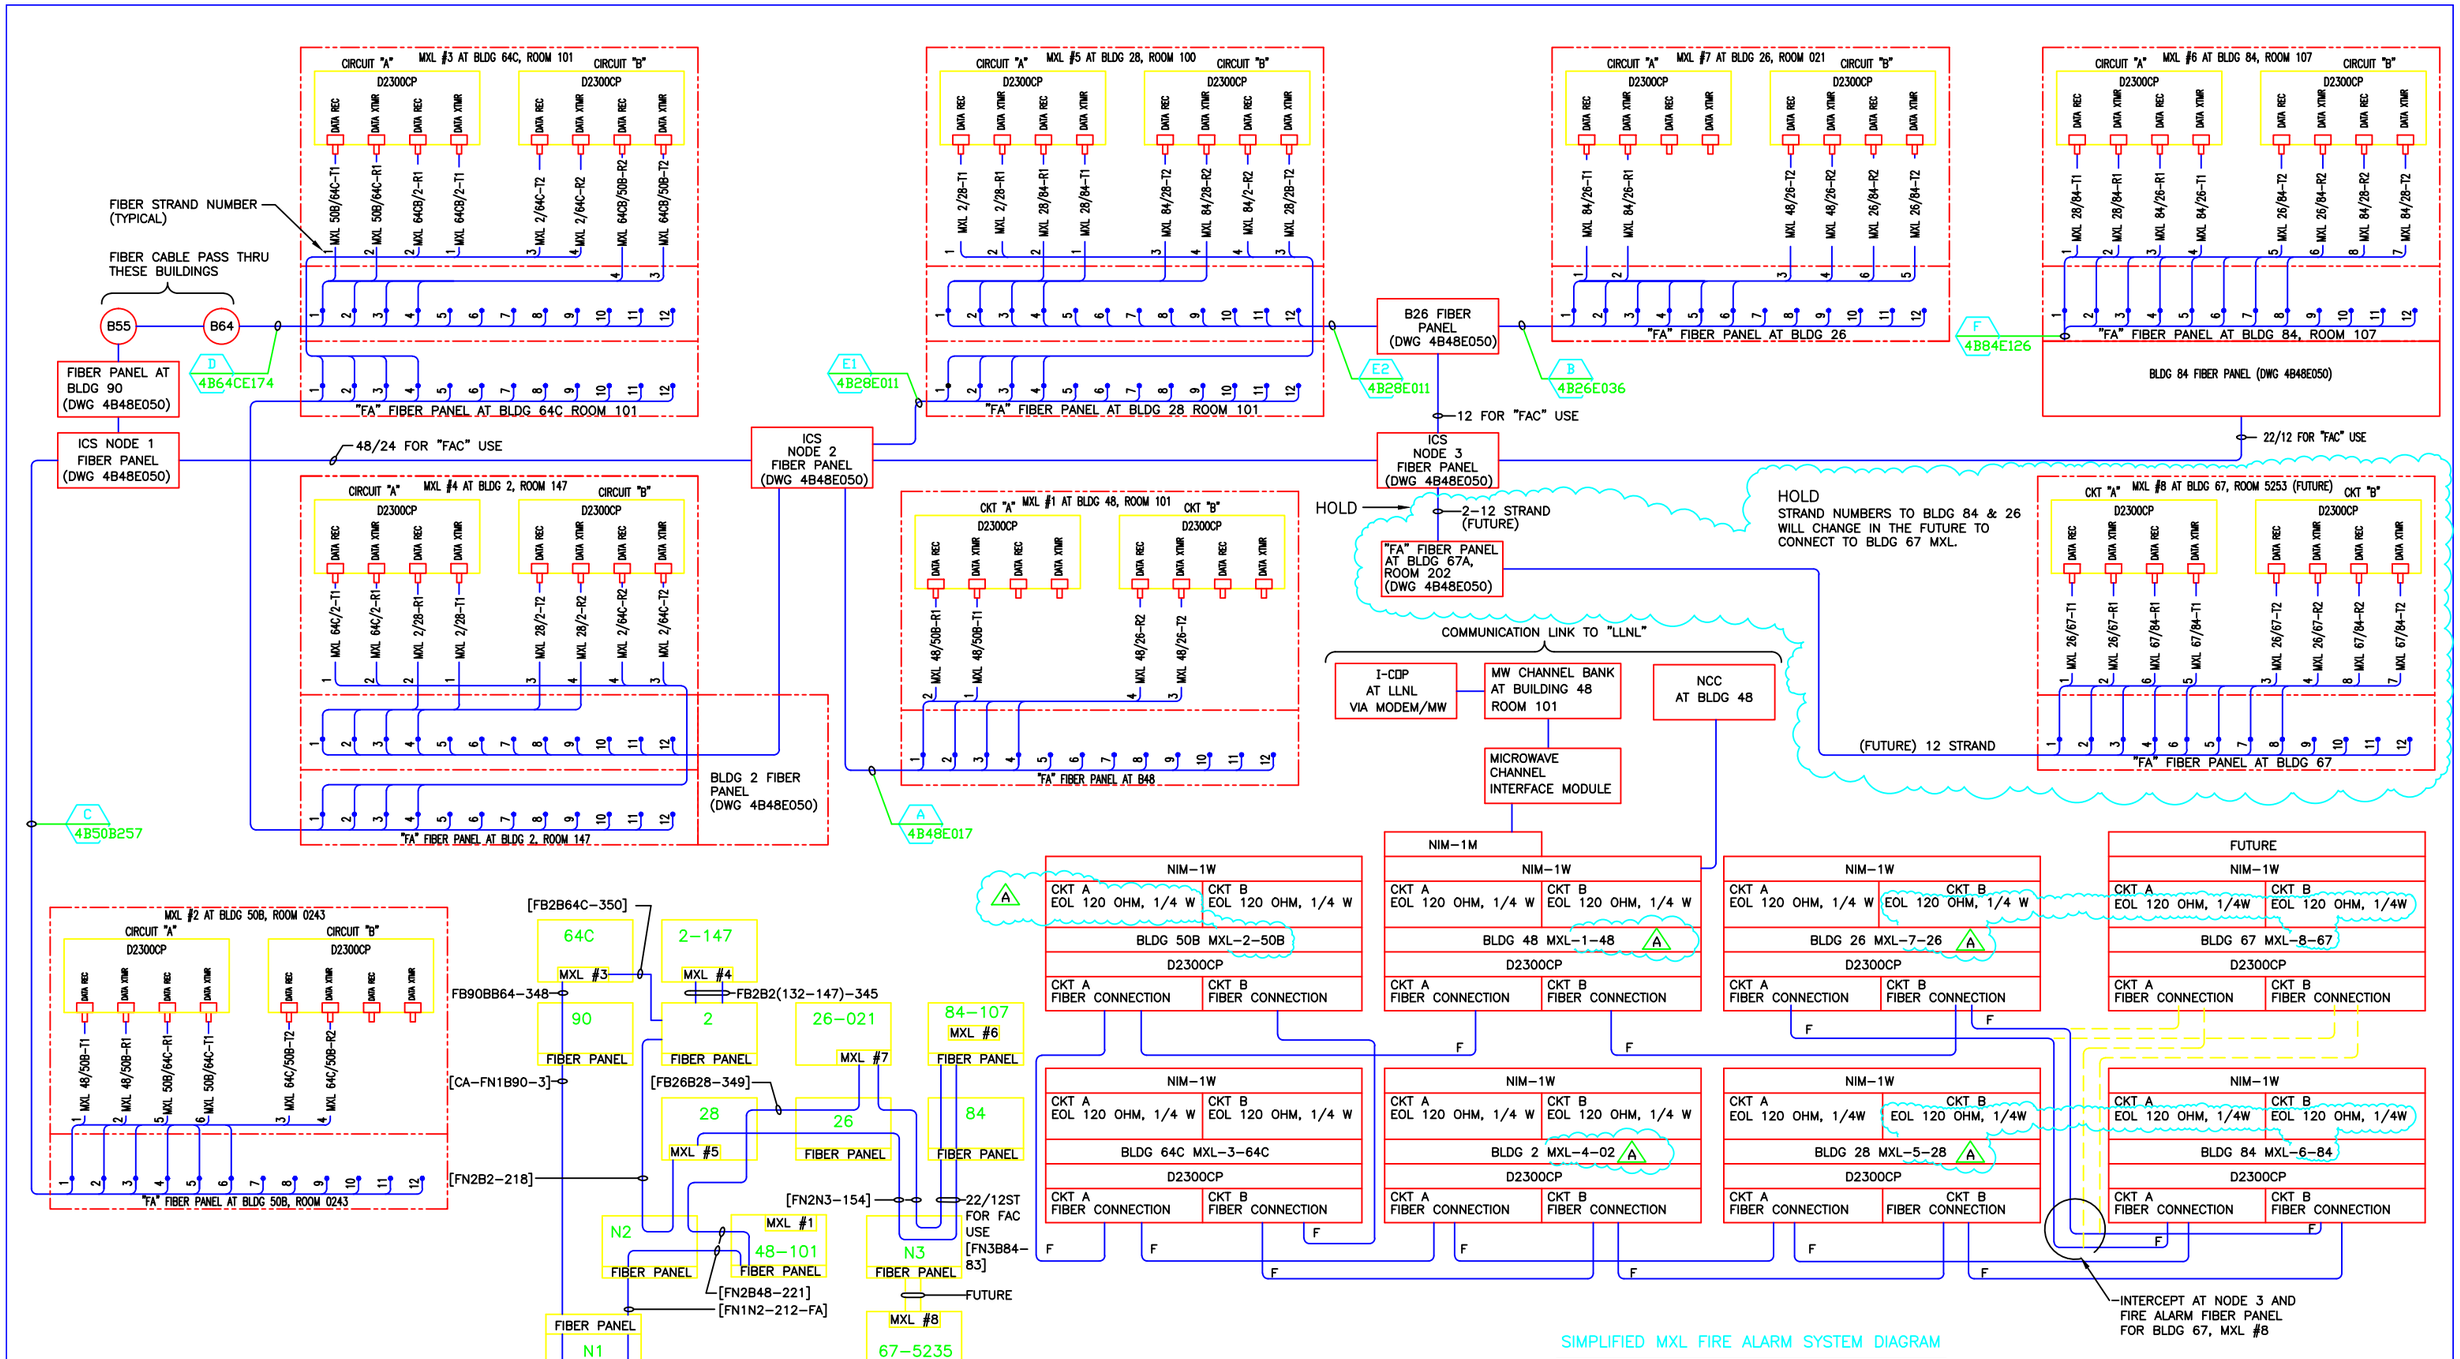

	TITLE 2 8/23/2005	A	AD	MCG	MCG	12/01/05	ADDED EOL PER SIEMENS REVIEW
PROFESSIONAL SEAL (IF REVISION, APPLIES ONLY TO REVISED WORK)	ISSUE (PROGRESS, ESTIMATE, BID, CONSTRUCTION, CONFORMED, REVISION, AS-BUILT)	REVISION NUMBER	DRAWN BY	CHECKED BY	APPR'D BY	DATE	REMARKS

48 FIRE ALARM
MXL FIBER LOOP
BLOCK AND CONNECTION DIAGRAM NO. 1

UNIVERSITY OF CALIFORNIA
LAWRENCE BERKELEY NATIONAL LABORATORY
FACILITIES DEPARTMENT

DRAWN BY	AD	6/23/2005
CHECKED BY	MCG	6/23/2005
APPROVED BY	MCG	6/23/2005
CAD FILE PATH	00020532	
SCALE	Full	
DRAWING NO.	4B48E049A	SHEET 1 OF 1
PROJECT NO.	FA8061	