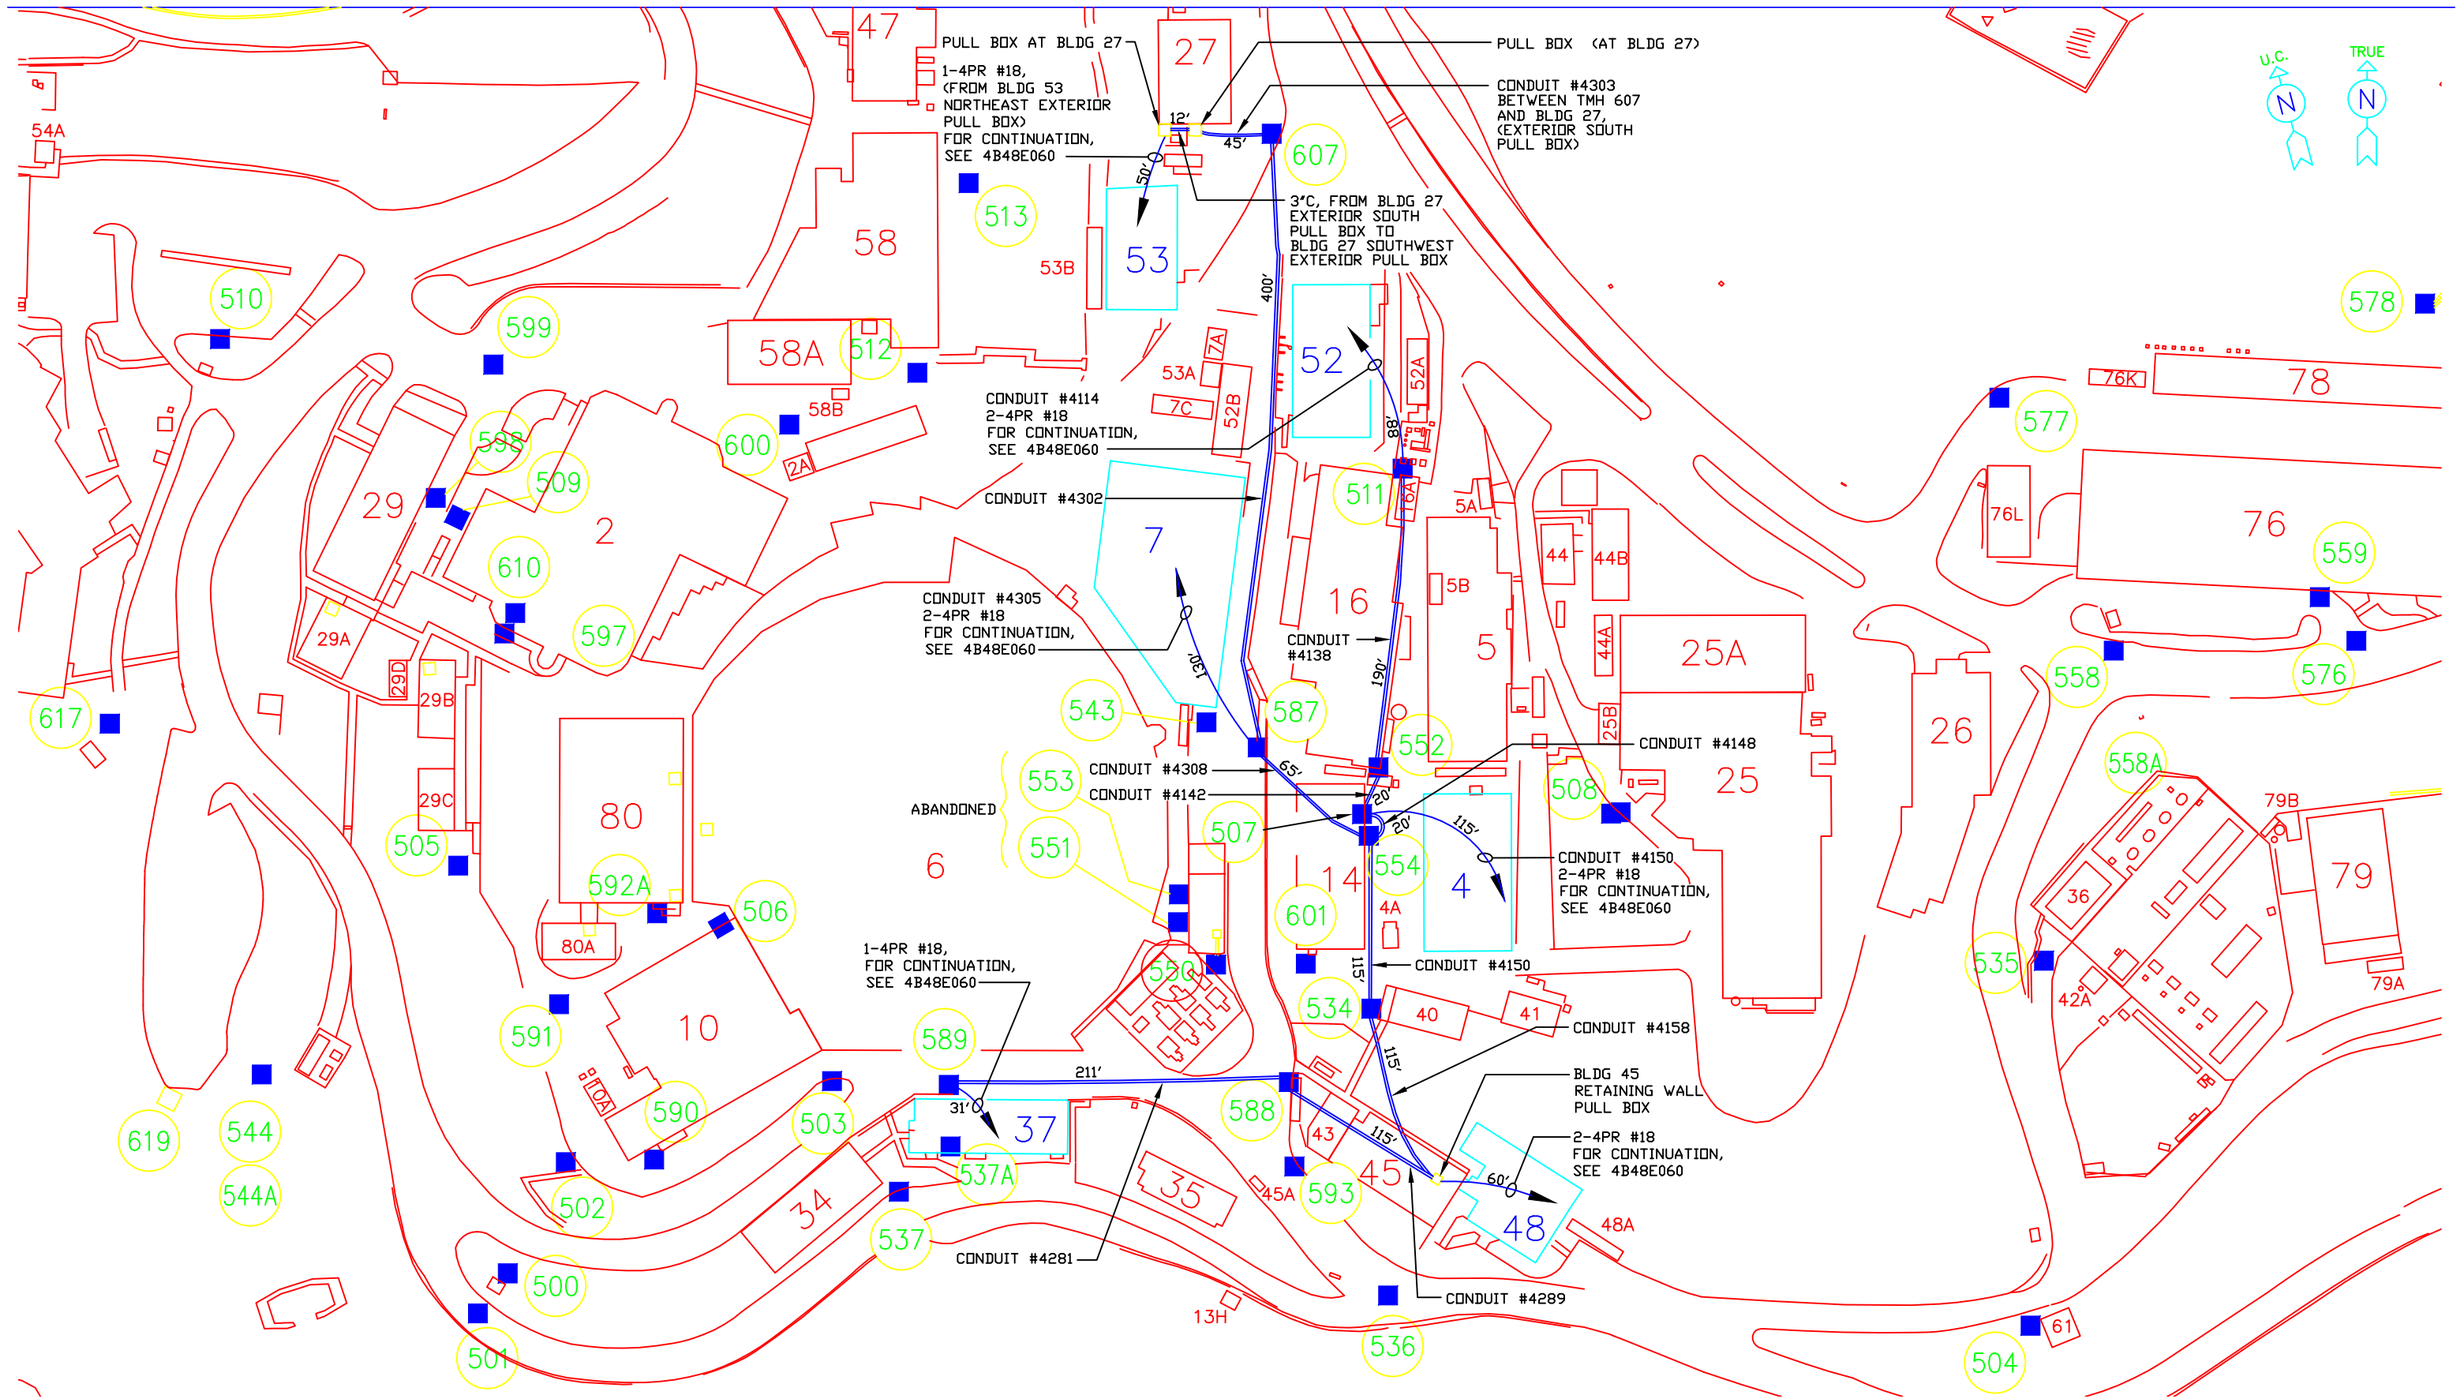

PROFESSIONAL SEAL (IF REVISION, APPLIES ONLY TO REVISED WORK)	ISSUE (PROGRESS, ESTIMATE, BID, CONSTRUCTION, CONFORMED, REVISION, AS-BUILT)	REVISION NUMBER	DRAWN BY	CHECKED BY	APPR'D BY	DATE	REMARKS				

TITLE 2
2/16/2006

48 COPPER LOOP
MXL/MOI COPPER LOOP NO. 1
UNDERGROUND DUCTBANK

UNIVERSITY OF CALIFORNIA
LAWRENCE BERKELEY NATIONAL LABORATORY
FACILITIES DEPARTMENT

DRAWN BY	AD	DATE 1/3/2006
CHECKED BY	LDD	1/3/2006
APPROVED BY	MCD	1/3/2006
CAD FILE PATH	00020739	
SCALE	1"=50'-0"	
DRAWING NO.	4B48E059	SHEET
PROJECT NO.	FR1015	1 OF 1