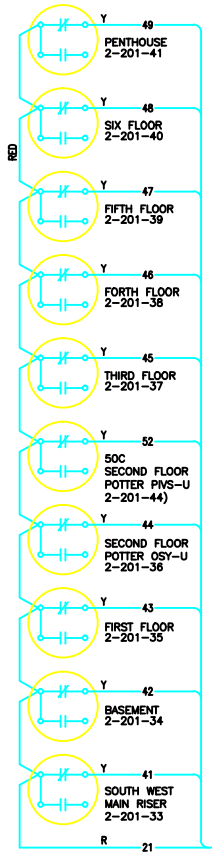

SPRINKLER VALVE SUPERVISION SWITCHES (ZONES 2-201-33, 2-201-41,2-201-44)

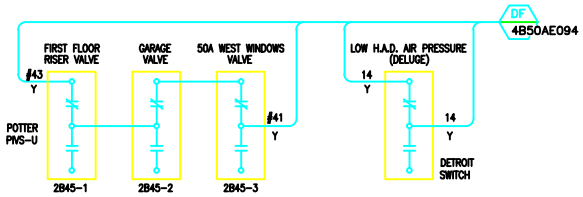

50E SUPERVISION SWITCHES (ZONE 2-201-45)
POTTER PIVS-U SWITCHES

(ZONE 2-201-46)

8 SETS OF CONTACTS IN CHILLERS AT B50A

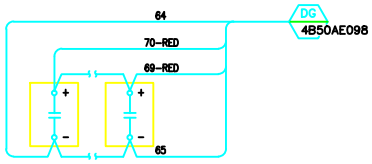

50E FCB (ZONE 2-201-14)
CLASS A

TC-2

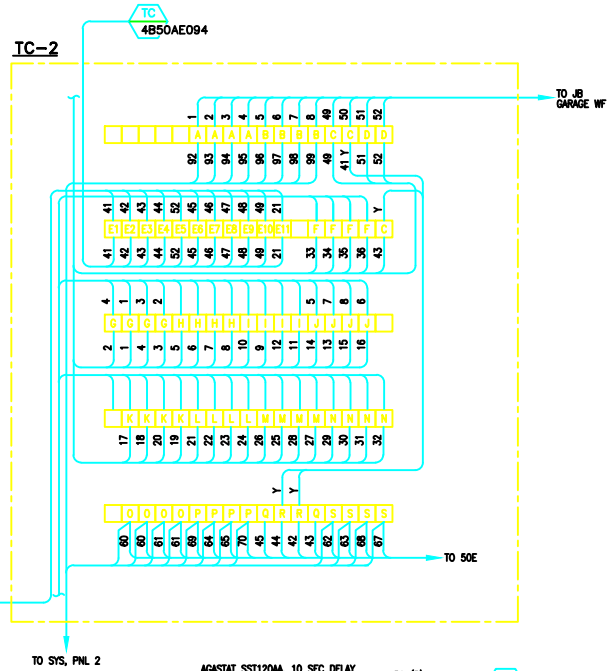

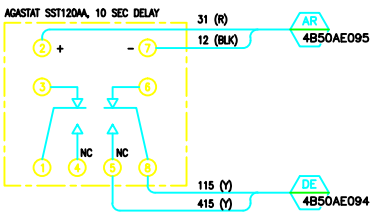

TROUBLE TIME DELAY (ZONE 2-201-47)
(RELAY SHOWN ENERGIZED)

REVISION NUMBER	DRAWN BY	CHECKED BY	APPROVED BY	DATE	REMARKS
B	AD	ROB	MCG	7/14/99	AS BUILT
A	LM		MG	7/25/97	AUTOCAD CONVERSION

50A
FIRE ALARM SYSTEM
FIELD DEVICES CONNECTION DIAG

UNIVERSITY OF CALIFORNIA LAWRENCE BERKELEY LABORATORY
FACILITIES DEPARTMENT

DRAWN BY	LM	DATE 08/20/97
CHECKED BY		
APPROVED BY	MCG	07/25/97
CAD FILE PATH	00011092	
SCALE	As Noted	
DRAWING NO.	4B50AE082B	SHEET 1 OF 1
PROJECT NO.	159626	