NOTES:

1. ZONE TRANSMITTED AT 50B. THIS MODULE TO RING BELLS AT 50A ON FIRST FLOOR WF (REF ZONE 2B50)

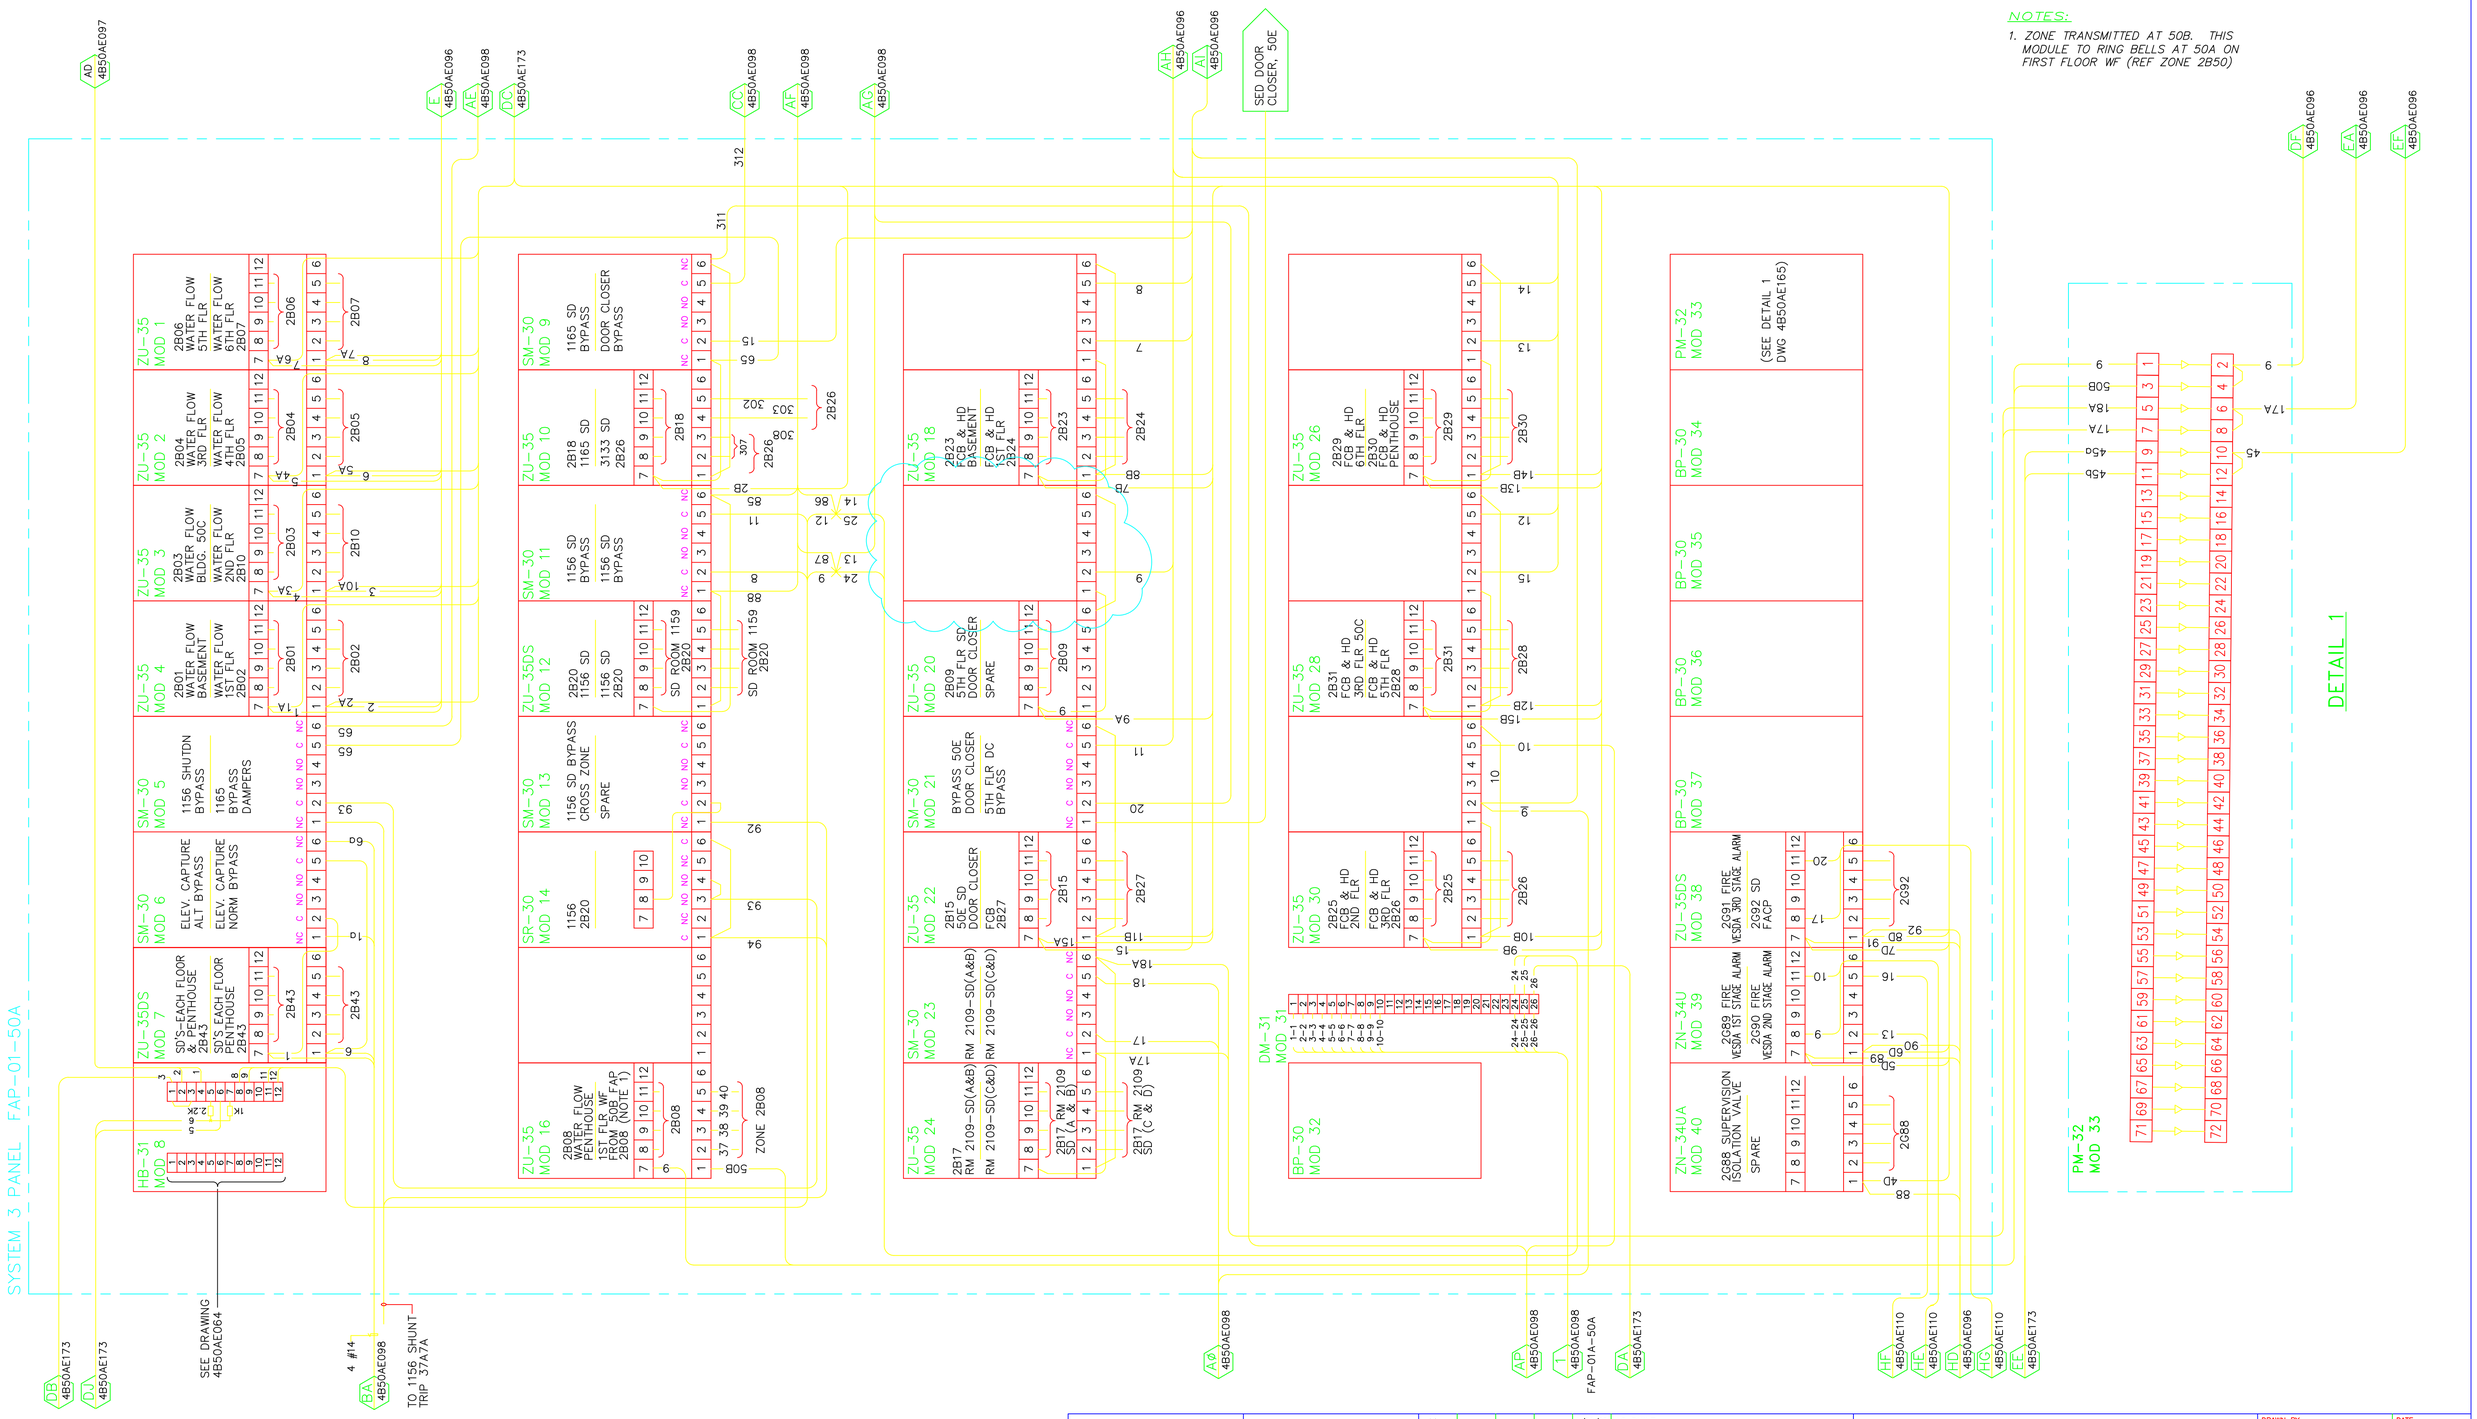

K				9/30/08	AS BUILT		
J	AD	LDD	MCD	8/20/07	FIRE ALARM SYSTEM UP-GRADE		
I	MRC	AD	MCG	9/27/04	PHASE III FIRE ALARM SYSTEM UP-GRADE		
H	AD	ROB	MCG	7/14/00	AS BUILT		
G	ROB	MCG	MCG	10/30/98	AS BUILT		
F	ROB	MCG	MCG	6/8/98	MODIFY ELEVATOR RECALL CIRCUIT		
L	RZT	AT	MCD	03/20/13	ADDED R22/123 MONITOR.		
REVISION NUMBER	DRAWN BY	CHECKED BY	APPR'D BY	DATE	REMARKS		

PROFESSIONAL SEAL (IF REVISION, APPLIES ONLY TO REVISED WORK)

ISSUE (PROGRESS, ESTIMATE, BID, CONSTRUCTION, CONFORMED, REVISION, RECORD)

ASBUILT REVISION L 03/20/2013

50A FIRE ALARM SYSTEM

SYSTEM 3 PANEL FAP-01-50A

INTERCONNECTION DIAGRAM

UNIVERSITY OF CALIFORNIA
LAWRENCE BERKELEY NATIONAL LABORATORY
FACILITIES DIVISION

DRAWN BY	PL	DATE	6/4/1996
CHECKED BY	GW		6/4/1996
APPROVED BY			
CAD FILE PATH	00022513		
SCALE	As Noted		
DRAWING NO.	4B50AE095L	SHEET	FA2.0
PROJECT NO.	FB4010		1 OF 1