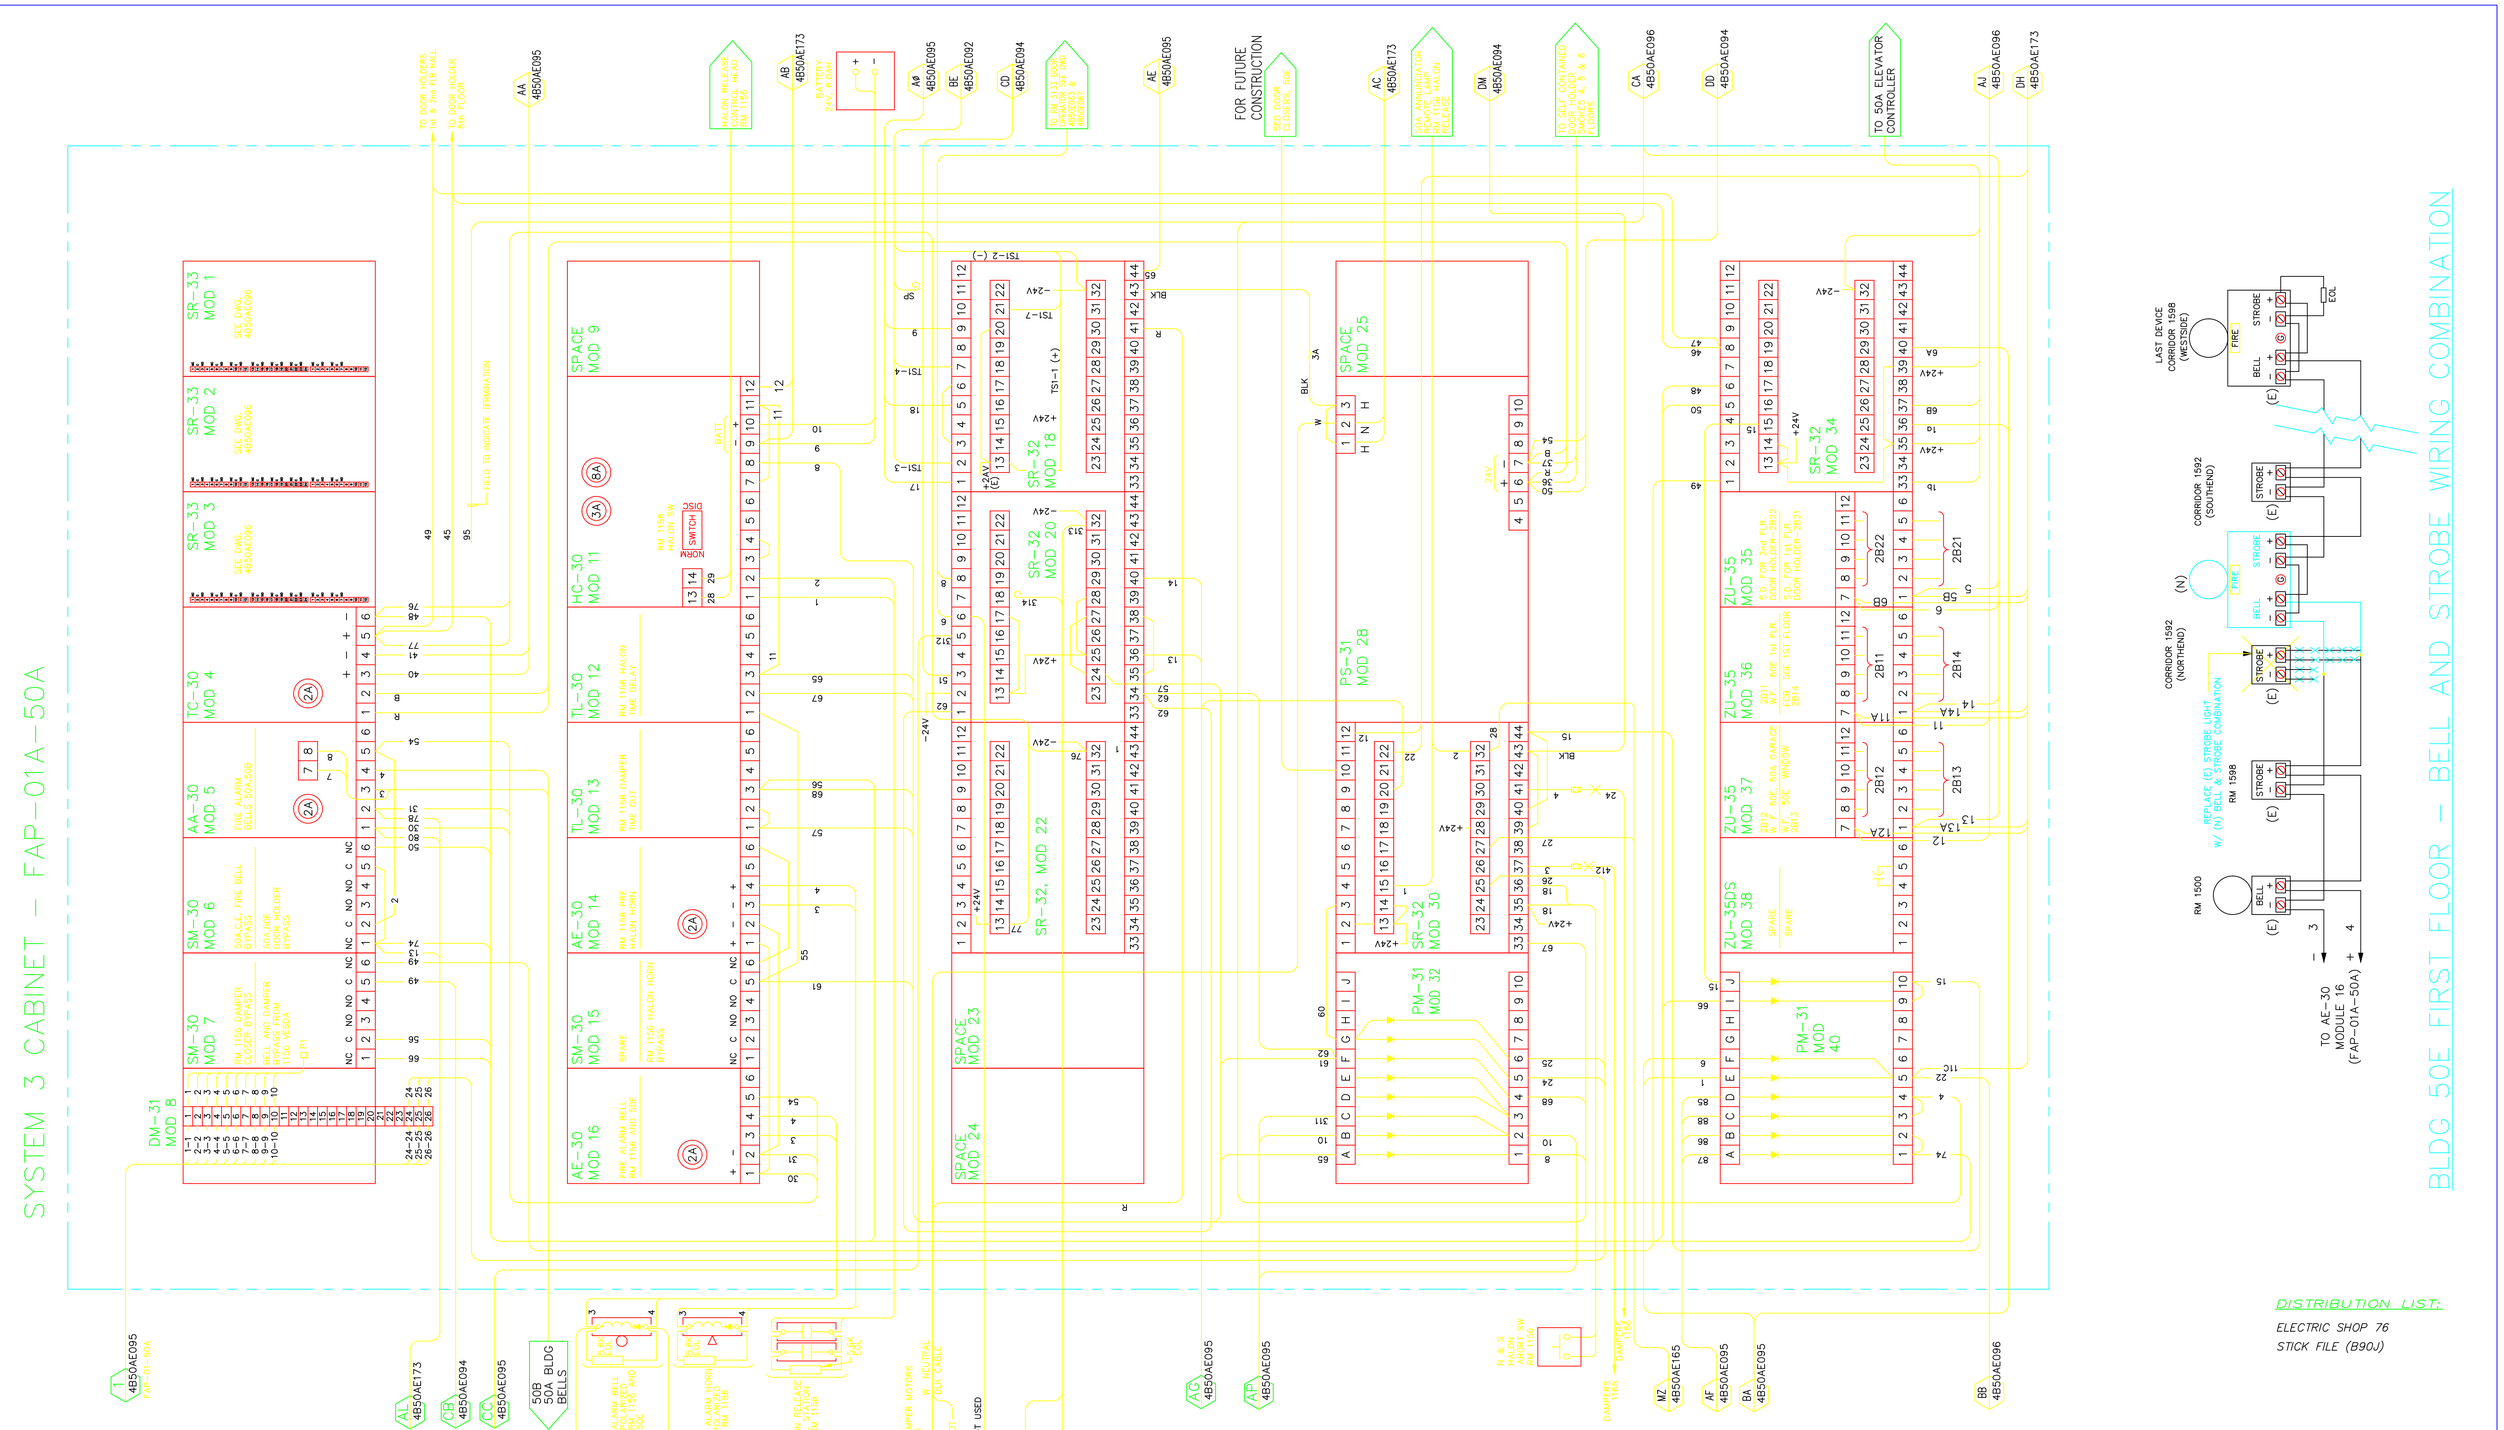

DISTRIBUTION LIST:

ELECTRIC SHOP 76
STICK FILE (B90J)

L	AD	LDD	MCD	8/20/07	FIRE ALARM SYSTEM UP–GRADE
K	MRC	AD	MCG	9/29/04	PHASE III FIRE ALARM SYSTEM UP–GRADE
J	IPM	VDA	MCG	8/22/02	AS–BUILT
I	VDA	MCG	MCG	5/28/02	REPLACE STROBE w/ BELL–STOBE COMB.
H	AD	ROB	MCG	7/14/00	AS BUILT
G	ROB	MCG	MCG	10/30/98	AS BUILT
F	ROB	MCG	MCG	6/8/98	MODIFY ELEVATOR RECALL
REVISION NUMBER	DRAWN BY	CHECKED BY	APPR'D BY	DATE	REMARKS

PROFESSIONAL SEAL (IF REVISION, APPLIES ONLY TO REVISED WORK)

ISSUE (PROGRESS, ESTIMATE, BID, CONSTRUCTION, CONFORMED, REVISION, AS–BUILT)

TITLE 2
CONSTRUCTION
L
8/20/2007

50A FIRE ALARM SYSTEM
SYSTEM 3 PANEL FAP–01A–50A
INTERCONNECTION DIAGRAM

UNIVERSITY OF CALIFORNIA
LAWRENCE BERKELEY NATIONAL LABORATORY
FACILITIES DEPARTMENT

DRAWN BY	PL	DATE	6/4/1996
CHECKED BY	GW		6/4/1996
APPROVED BY			
CAD FILE PATH	00022523		
SCALE	As Noted		
DRAWING NO.	4B50AE098L	SHEET	1 OF 1
PROJECT NO.	FB4010		