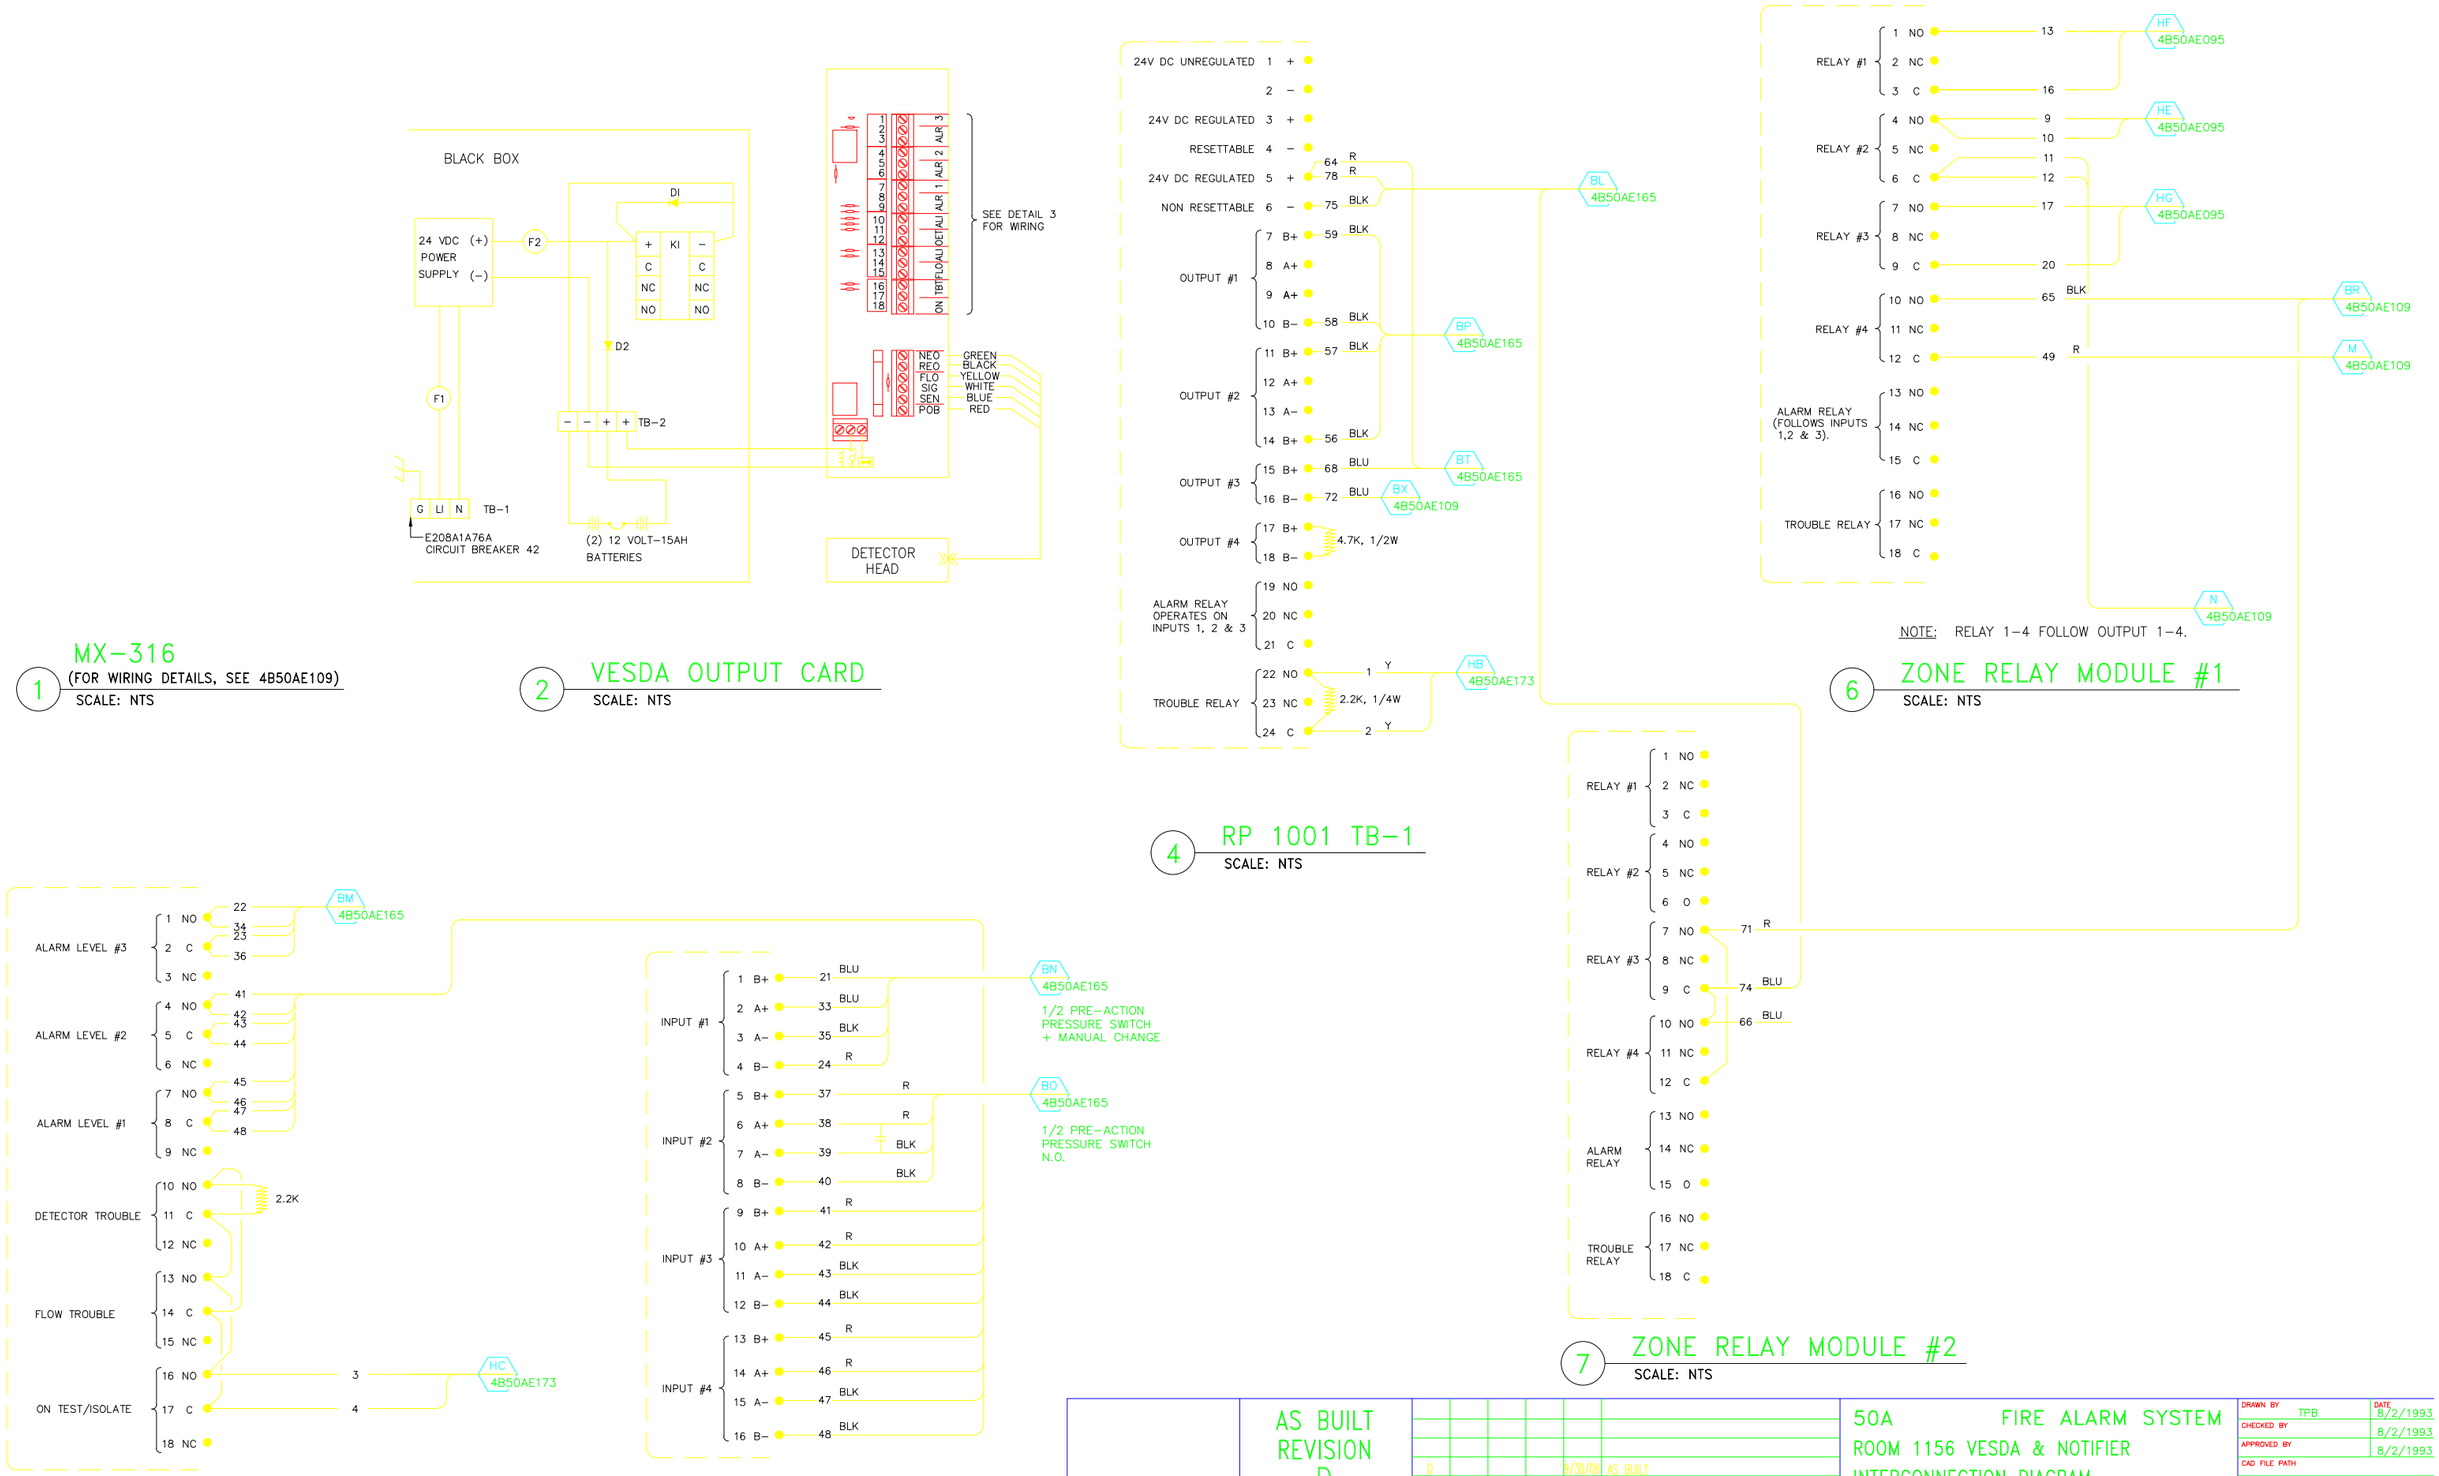

PROFESSIONAL SEAL (IF REVISION, APPLIES ONLY TO REVISED WORK)	ISSUE (PROGRESS, ESTIMATE, BID, CONSTRUCTION, CONFORMED, REVISION, RECORD)	REVISION NUMBER	DRAWN BY	CHECKED BY	APPR'D BY	DATE	REMARKS
	AS BUILT REVISION D 9/30/2008	D				9/30/08	AS BUILT
		C	MRC	AD	MCG	8/23/04	PHASE III FIRE ALARM SYSTEM UP−GRADE
		B	AD	ROB	MCG	8/14/00	AS BUILT
		A	LM		MCG	4/1/97	AS BUILT.

50A FIRE ALARM SYSTEM
ROOM 1156 VESDA & NOTIFIER
INTERCONNECTION DIAGRAM

UNIVERSITY OF CALIFORNIA
LAWRENCE BERKELEY NATIONAL LABORATORY
FACILITIES DIVISION

DRAWN BY TPB	DATE 8/2/1993	
CHECKED BY	8/2/1993	
APPROVED BY	8/2/1993	
CAD FILE PATH		
SCALE As Noted		
DRAWING NO. 4B50AE110D	SHEET 1 OF 1	
PROJECT NO. FB4010		