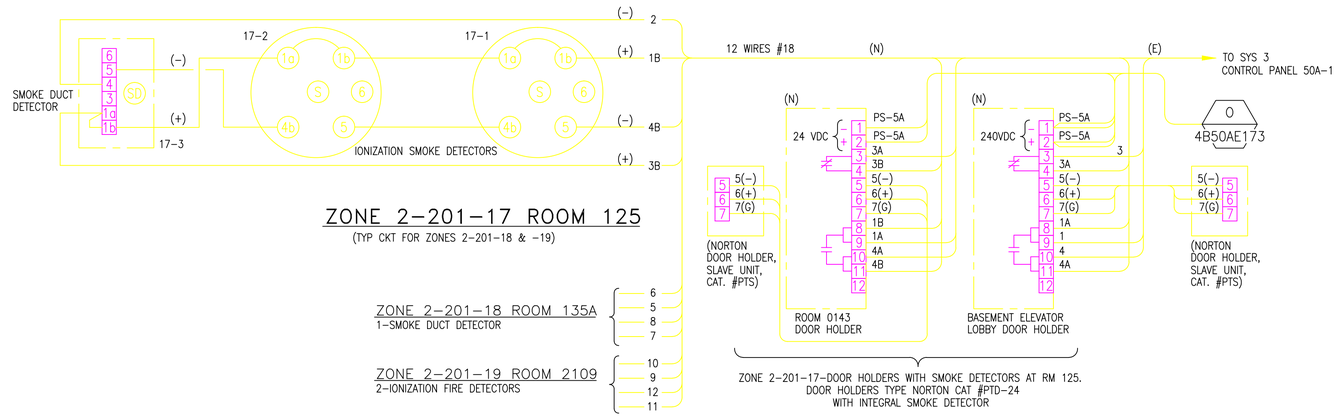

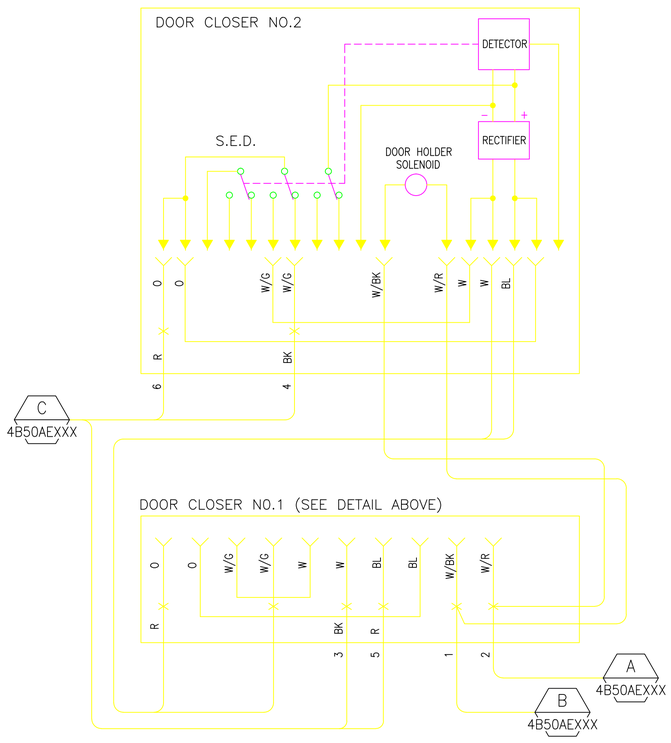

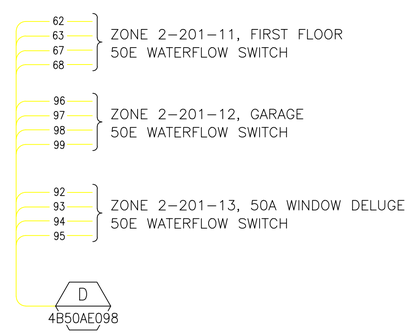

NOTES:

1. FIELD SHALL VERIFY ZONE CONNECTIONS AND NUMBERS.

AS BUILT

D

5/8/2013

REVISION NUMBER	DRAWN BY	CHECKED BY	APPR'D BY	DATE	REMARKS
D	LDD	LDD	MCD	05/08/13	AS BUILT PER FIELD VERIFICATIONS
C	MRC	AD	MCG	9/23/04	PHASE III FIRE ALARM SYSTEM UP-GRADE
B	AD	ROB	MCG	7/14/00	AS BUILT
A	LM		MG	7/25/97	AS BUILT-FIRE & LIFE SAFETY/CADD CONVERSION

PROFESSIONAL SEAL (IF REVISION, APPLIES ONLY TO REVISED WORK)

ISSUE (PROGRESS, ESTIMATE, BID, CONSTRUCTION, CONFORMED, REVISION, RECORD)

50A FIRE ALARM SYSTEM
FIELD DEVICES
FACP #1 WIRING DIAGRAM #1

UNIVERSITY OF CALIFORNIA
LAWRENCE BERKELEY NATIONAL LABORATORY
FACILITIES DIVISION

DRAWN BY LM
DATE 6/26/1997
CHECKED BY
APPROVED BY
CAD FILE PATH
SCALE As Noted
DRAWING NO. 4B50AE112D
SHEET 1 OF 1
PROJECT NO. FB4010