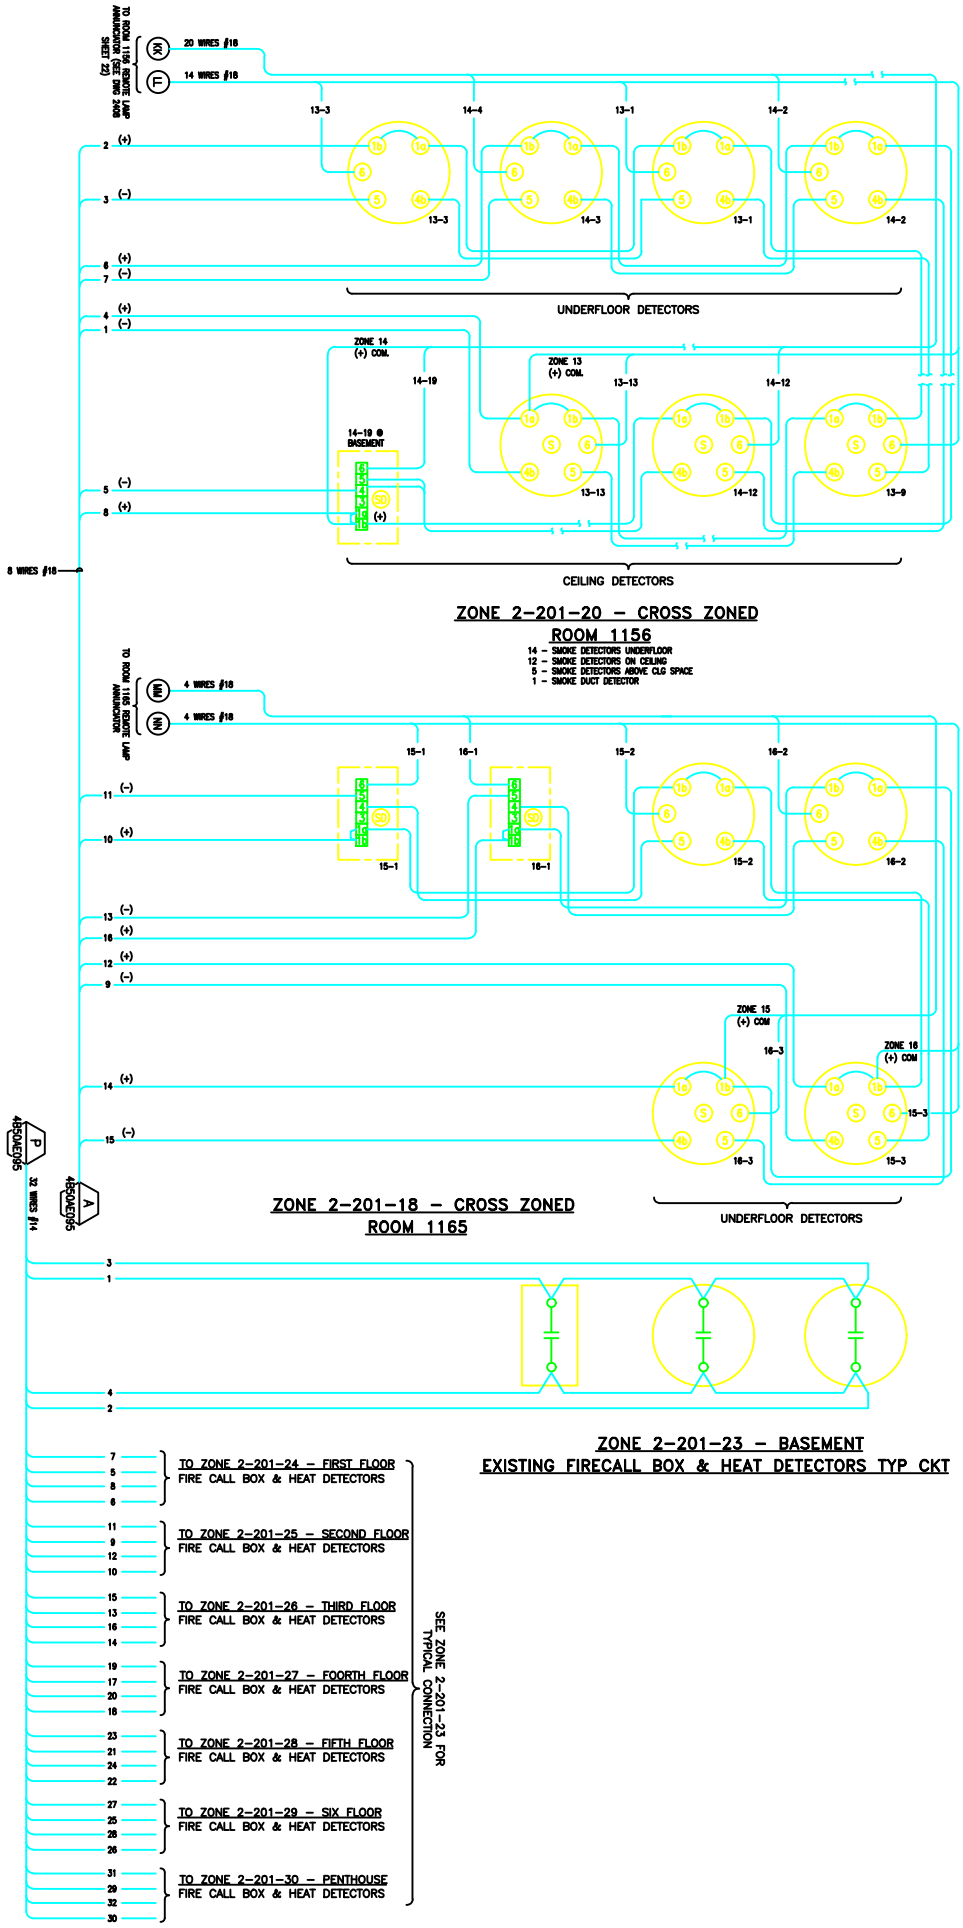

REVISIONS						
A	LM	AD	RGB	WCS	7/7/99	AS BUILT
B				WCS	7/26/01	AUTOCAD CONVERSION

UNIVERSITY OF CALIFORNIA LAWRENCE BERKELEY LABORATORY

FACILITIES DEPARTMENT

50A FIRE ALARM SYSTEM FIELD DEVICES CONNECTION DIAG

DRAWN BY: LJR
DESIGNED BY: BHS
DATE: 08/10/98
CHK PER PERM: C00211119
DATE: 04/01/99
SCALE: As Noted
SHEET: 1 OF 1
PROJECT NO. 199020
DRAWING NO. 4B50AE113B