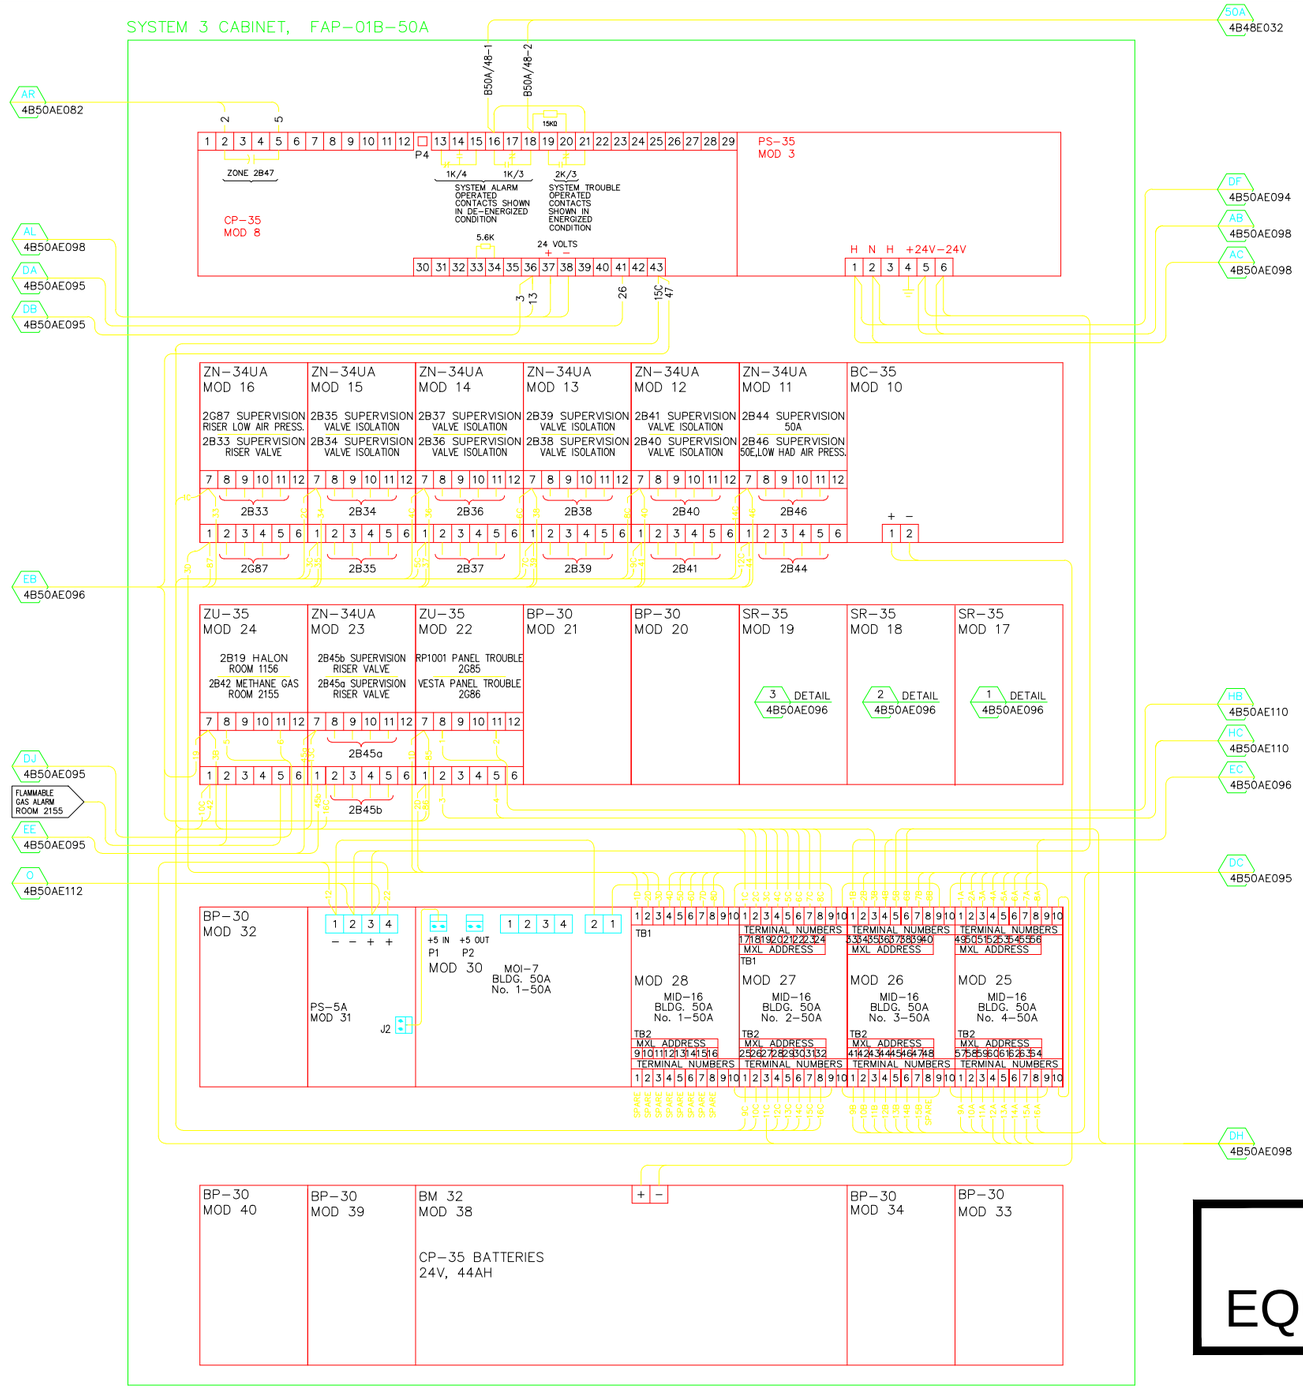

PRINT NOT NEEDED
EQUIPMENT NOT INSTALLED

AS BUILT REVISION B 9/30/2008

REVISION NUMBER	DRAWN BY	CHECKED BY	APPR'D BY	DATE	REMARKS
B				9/30/08	AS BUILT
A	AD	LDD	MCD	08/20/07	FIRE ALARM SYSTEM UPGRADE

PROFESSIONAL SEAL (IF REVISION, APPLIES ONLY TO REVISED WORK)

ISSUE (PROGRESS, ESTIMATE, BID, CONSTRUCTION, CONFORMED, REVISION, RECORD)

50A FIRE ALARM SYSTEM
SYSTEM 3 PANEL FAP-01B-50A
INTERCONNECTION DIAGRAM

UNIVERSITY OF CALIFORNIA
LAWRENCE BERKELEY NATIONAL LABORATORY
FACILITIES DIVISION

DRAWN BY	MRC	DATE 7/9/200
CHECKED BY	AD	7/9/200
APPROVED BY	MCG	7/9/200
CAD FILE PATH	00022525	
SCALE		
DRAWING NO.	4B50AE173B	SHEET
PROJECT NO.	FB4010	1 OF