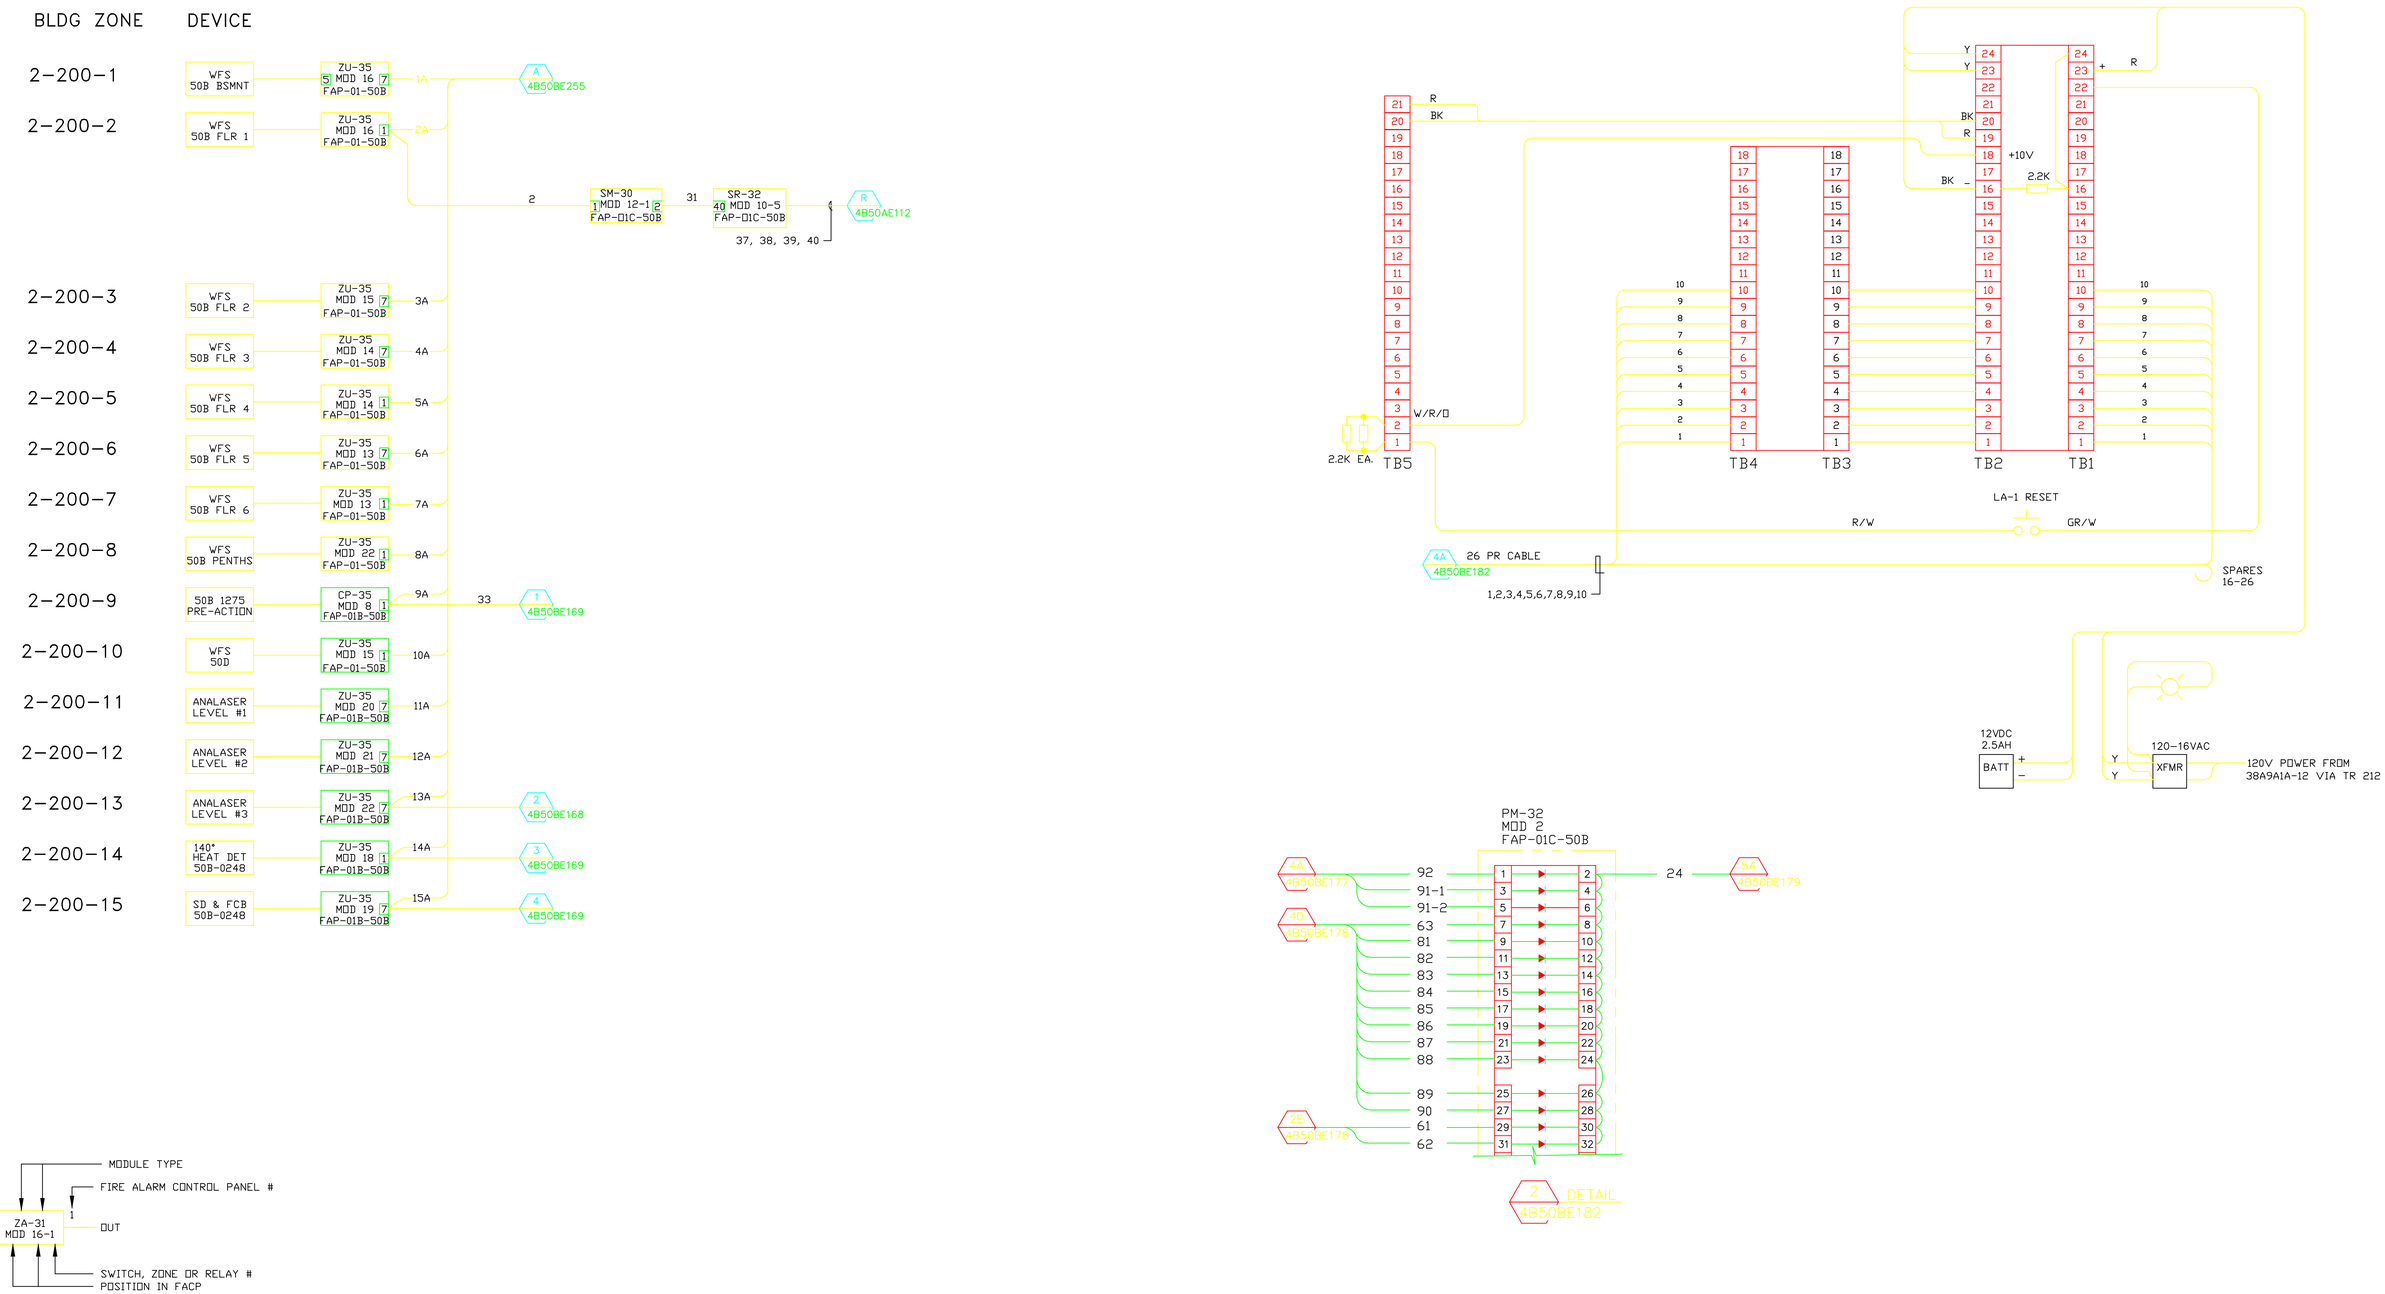

PROFESSIONAL SEAL (IF REVISION, APPLIES ONLY TO REVISED WORK)	ISSUE (PROGRESS, ESTIMATE, BID, CONSTRUCTION, CONFORMED, REVISION, RECORD)	REVISION NUMBER	DRAWN BY	CHECKED BY	APPR'D BY	DATE	REMARKS
	AS BUILT K 5/82013	K	LDD	LDD	MCD	05/08/13	AS BUITL PER FIELD VERIFICATIONS
		J	AD	-	-	11/26/07	ISSUED FOR REFERENCE ONLY
		H	AD	LDD	MCD	11/09/07	FIRE ALARM SYSTEM UPGRADE
		G	MRC	AD	MCG	05/21/04	PHASE III FIRE ALARM UPGRADE
		F	AD	ROB	MCG	8/14/00	AS BUILT
		E	LM		MCG	6/25/98	CONSTRUCTION COMPLETE, FIELD TO VERIFY
		D	ROB	ROB	MCG	11/25/96	CONVERT TO AUTOCAD

50B FIRE ALARM SYSTEM
FIRE ALARM LOGIC
AND WIRING DIAGRAMS

UNIVERSITY OF CALIFORNIA
LAWRENCE BERKELEY NATIONAL LABORATORY
FACILITIES DIVISION

DRAWN BY	ROB	DATE 10/10/1984
CHECKED BY	RG	10/10/1984
APPROVED BY	BHS	8/25/1985
CAD FILE PATH		
SCALE	As Noted	
DRAWING NO.	4B50BE049K	SHEET 1 OF 1
PROJECT NO.	FB4010	