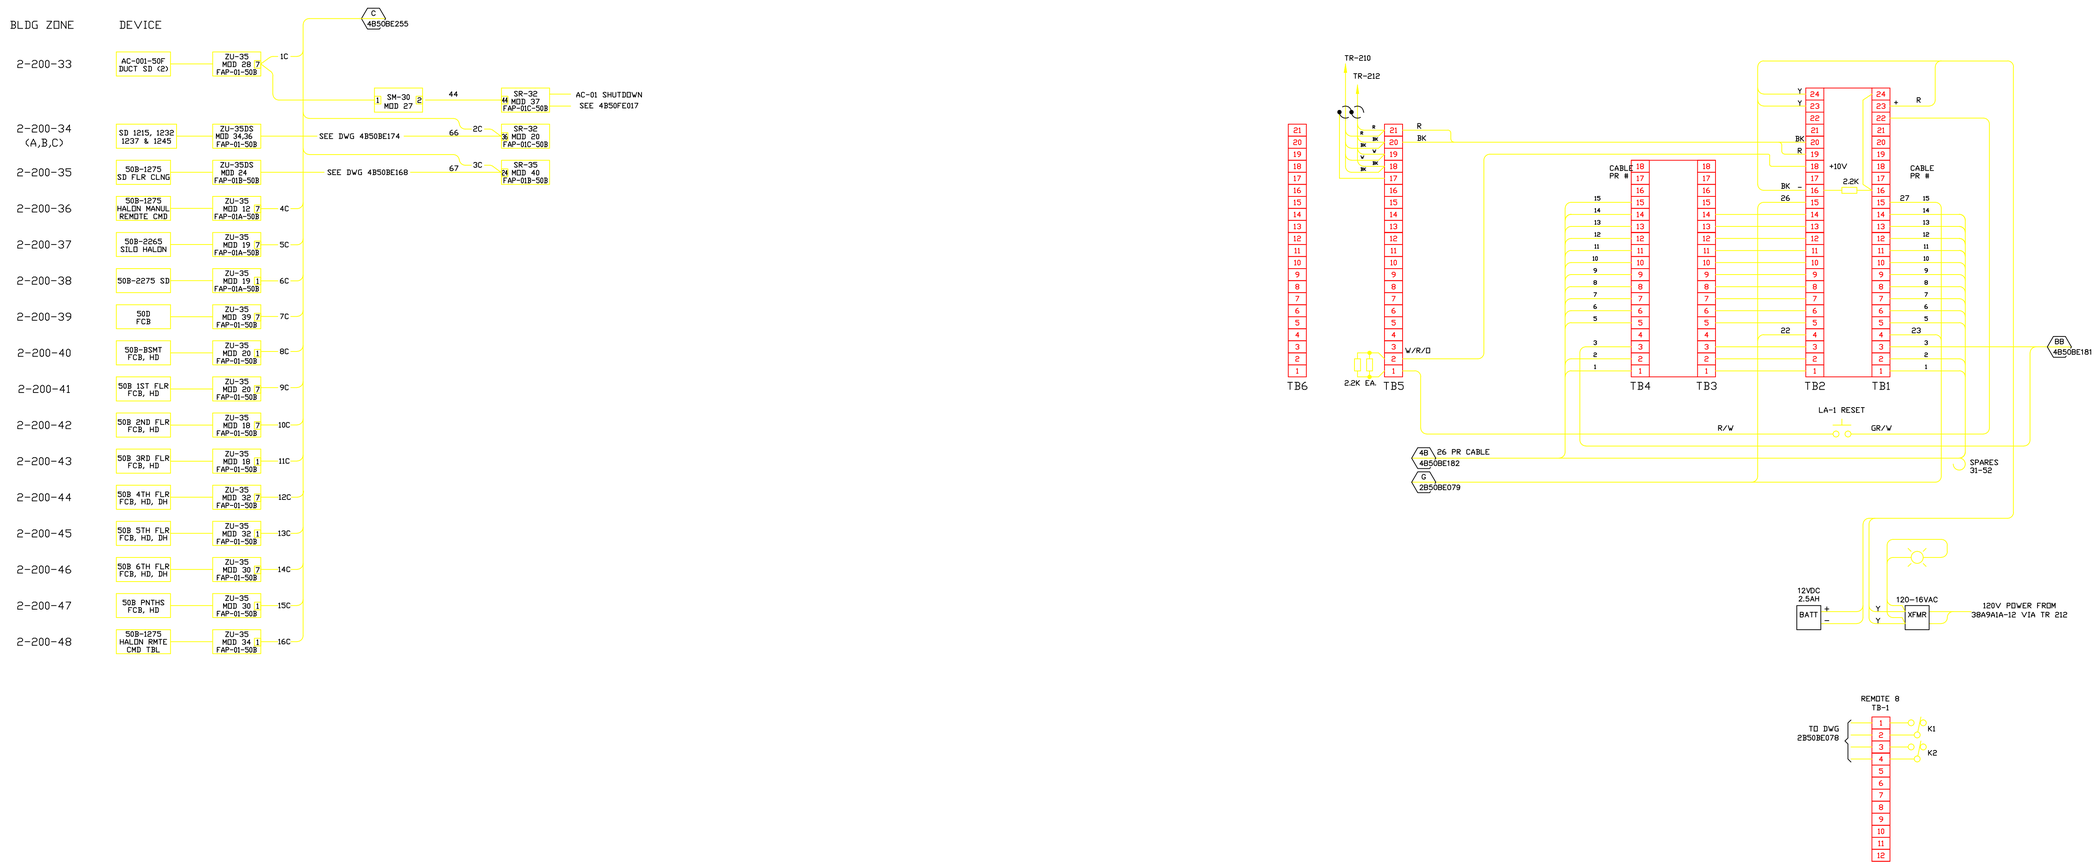

AS BUILT

5/8/2013

PROFESSIONAL SEAL (IF REVISION, APPLIES ONLY TO REVISED WORK)

ISSUE (PROGRESS, ESTIMATE, BID, CONSTRUCTION, CONFORMED, REVISION, RECORD)

REVISION NUMBER	DRAWN BY	CHECKED BY	APPR'D BY	DATE	REMARKS
I	LDD	LDD	MCD	05/08/13	AS BUILT PER FIELD VERIFICATIONS
H	AD	–	–	11/26/07	FIRE ALARM SYSTEM UPGRADE
G	AD	LDD	MCD	11/09/07	FIRE ALARM SYSTEM UPGRADE
F	MRC	AD	MCG	04/08/04	PHASE III FA UPGRADE
E	LM		MCG	6/25/98	CONSTRUCTION COMPLETE, FIELD TO VERIFY
D	ROB	ROB	MCG	11/25/96	CONVERT TO AUTOCAD

50B FIRE ALARM SYSTEM

FIRE ALARM LOGIC AND WIRING DIAGRAMS

UNIVERSITY OF CALIFORNIA
LAWRENCE BERKELEY NATIONAL LABORATORY
FACILITIES DIVISION

DRAWN BY	ROB	DATE 10/10/1984
CHECKED BY	RG	10/10/1984
APPROVED BY	BHS	8/26/1985
CAD FILE PATH		
SCALE	As Noted	
DRAWING NO.	4B50BE050I	SHEET 1 OF 1
PROJECT NO.	FB4010	