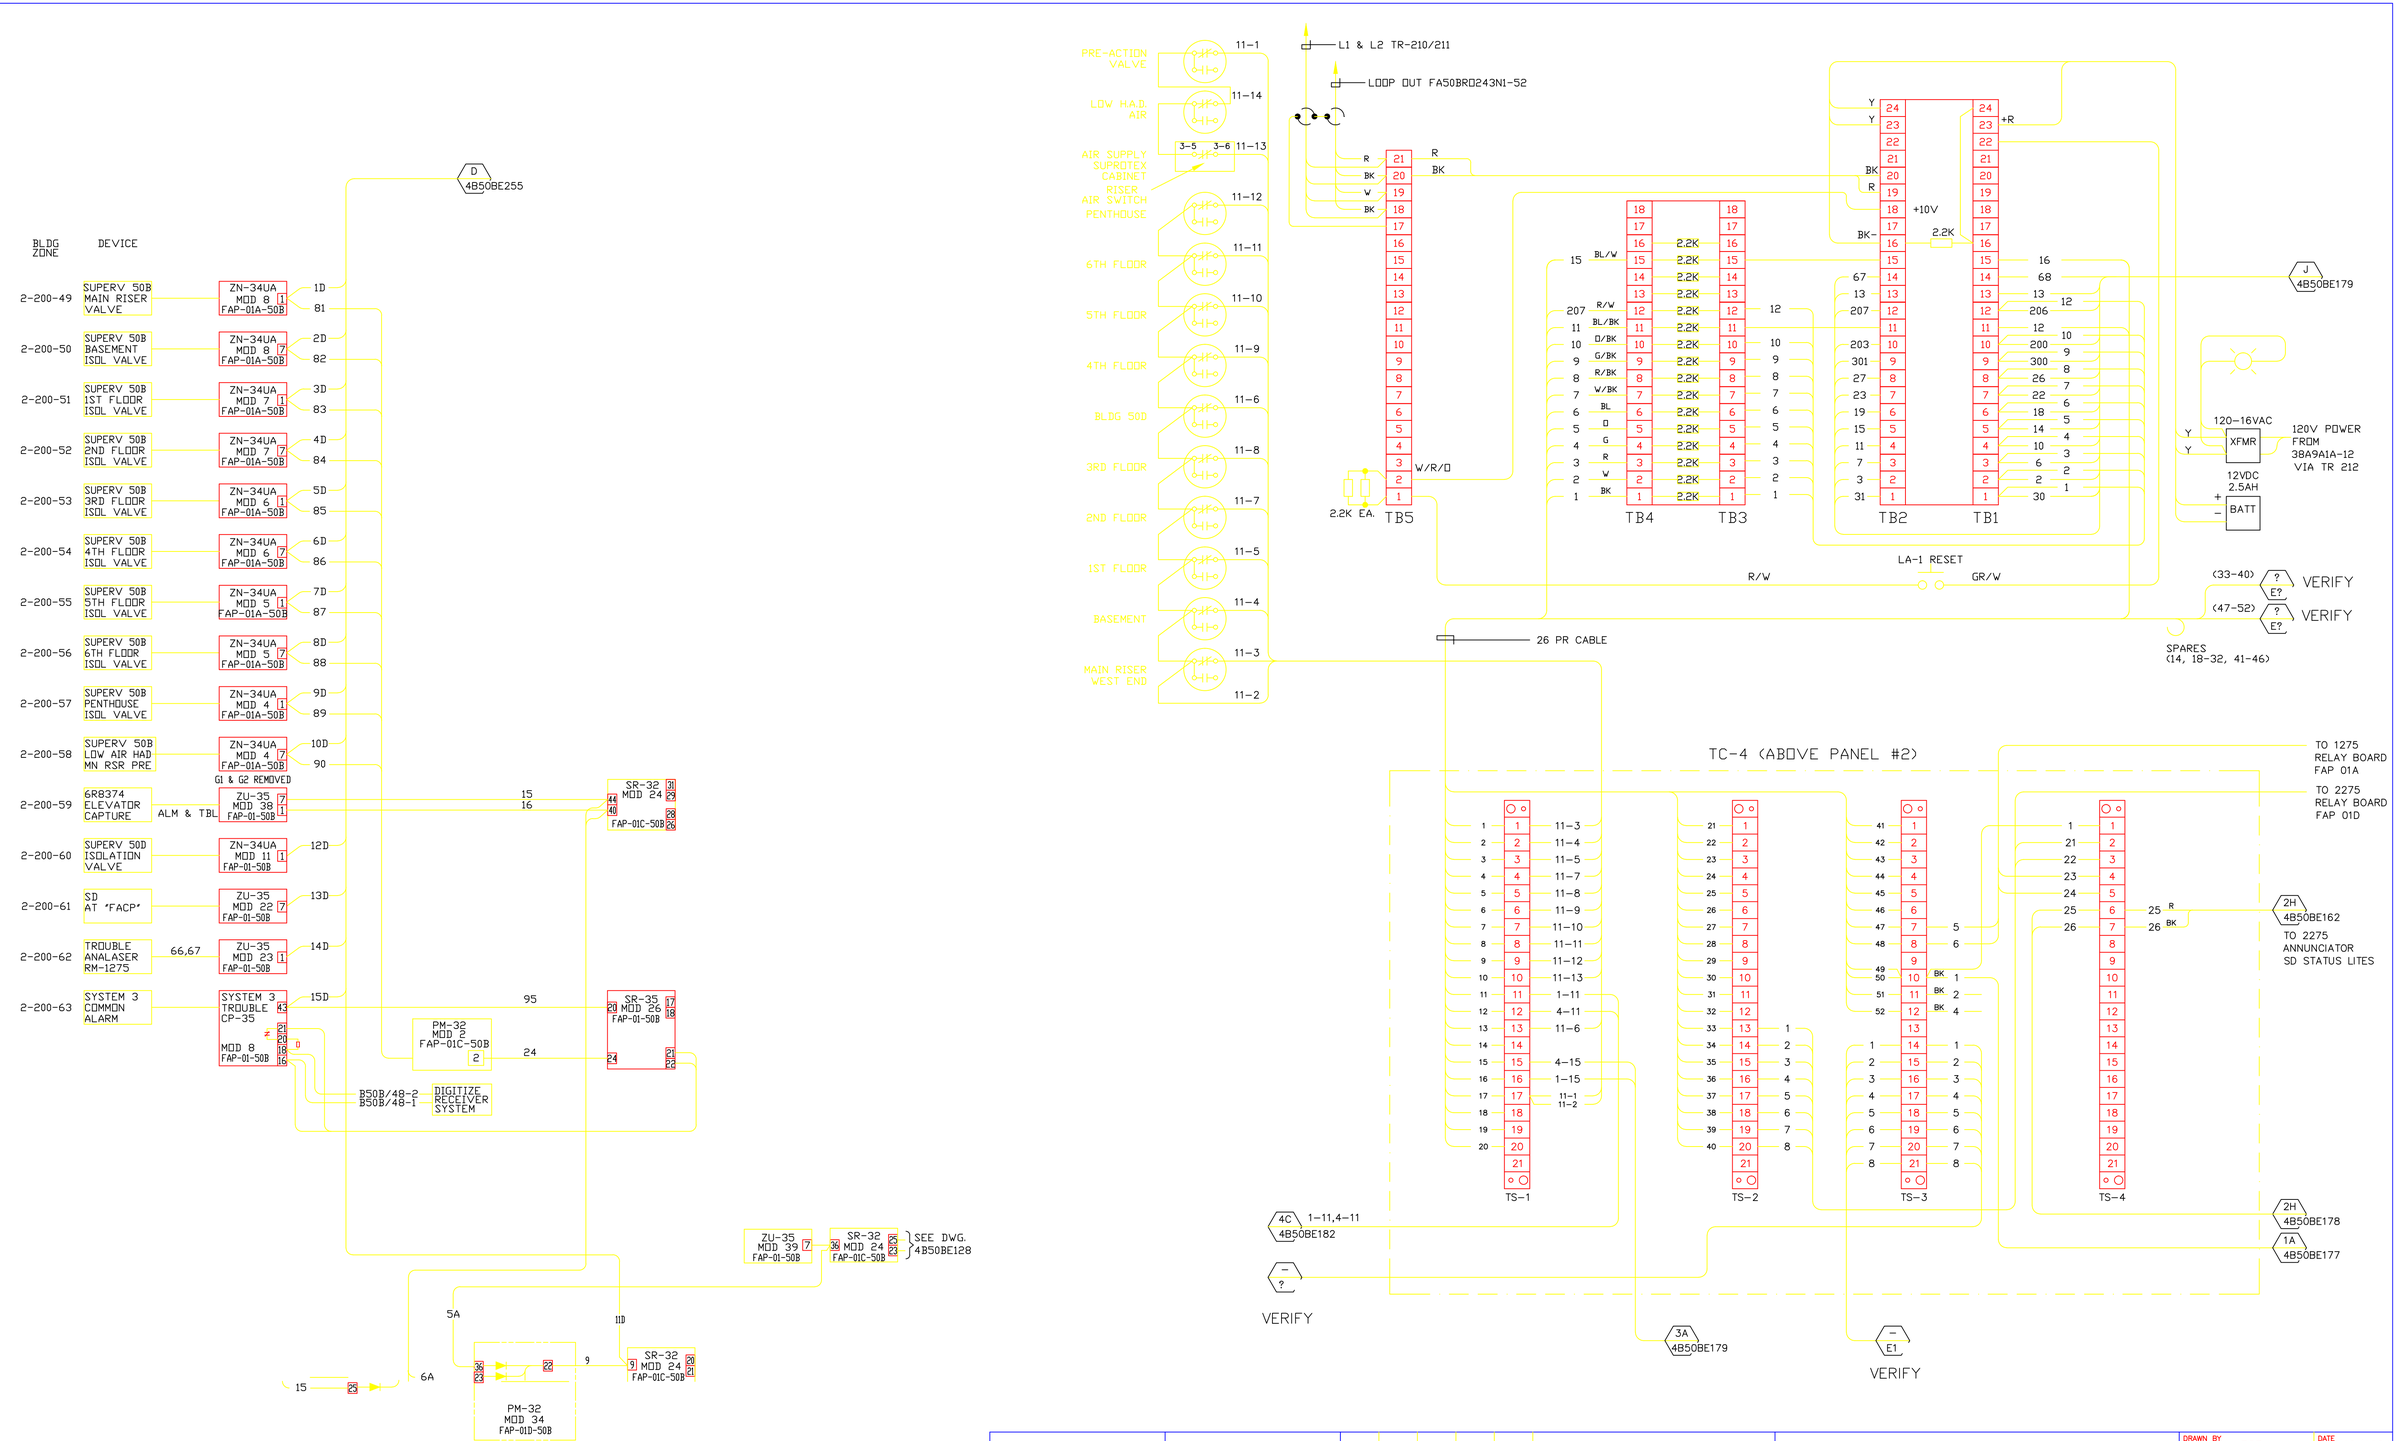

AS BUILT

G

5/8/2013

PROFESSIONAL SEAL (IF REVISION, APPLIES ONLY TO REVISED WORK)

ISSUE (PROGRESS, ESTIMATE, BID, CONSTRUCTION, CONFORMED, REVISION, RECORD)

REVISION NUMBER	DRAWN BY	CHECKED BY	APPR'D BY	DATE	REMARKS
G	LDD	LDD	MCD	05/08/13	AS BUILT PER FIELD VERIFICATIONS
F	AD	–	–	11/26/07	ISSUED FOR REFERENCE ONLY
E	AD	LDD	MCD	11/09/07	FIRE ALARM SYSTEM UPGRADE
D	AD	AD	MCG	04/08/04	PHASE III FIRE ALARM UPGRADE
C	ROB	ROB	MCG	11/25/96	ISSUED FOR FIELD VERIFICATION

50B FIRE ALARM SYSTEM

FIRE ALARM LOGIC AND WIRING DIAGRAMS

UNIVERSITY OF CALIFORNIA
LAWRENCE BERKELEY NATIONAL LABORATORY
FACILITIES DIVISION

DRAWN BY	ROB	DATE 10/10/1984
CHECKED BY	RG	10/10/1984
APPROVED BY	BHS	8/26/1985
CAD FILE PATH		
SCALE	As Noted	
DRAWING NO.	4B50BE051G	SHEET 1 OF 1
PROJECT NO.	FB4010	