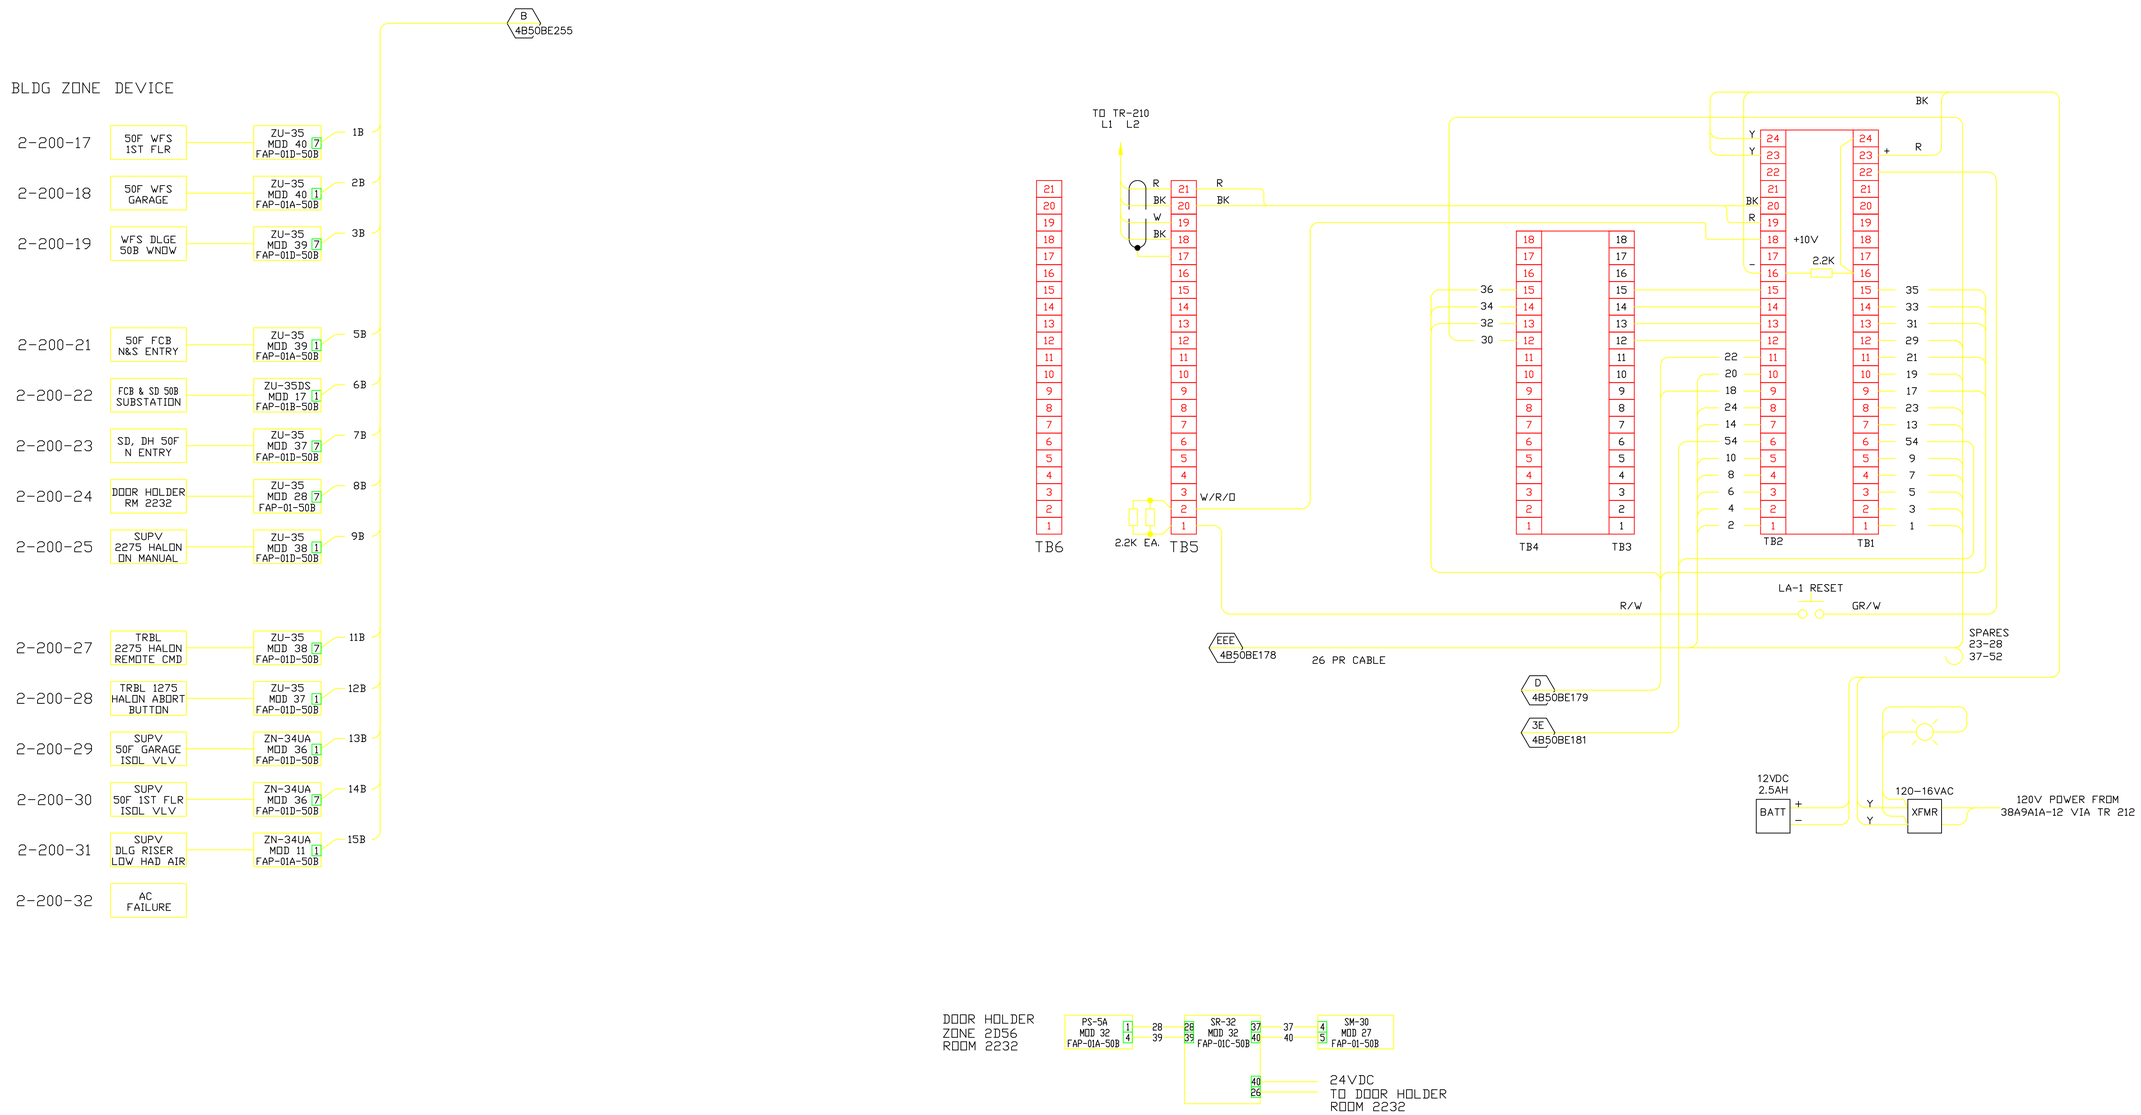

F	LDD	LDD	MCD	05/08/13	AS BUILT PER FIELD VERIFICATIONS
E	AD	–	–	11/26/07	ISSUED FOR REFERENCE ONLY
D	AD	LDD	MCD	11/09/07	FIRE ALARM SYSTEM UPGRADE
C	MRC	AD	MCG	05/21/04	PHASE III FIRE ALARM UPGRADE
B	ROB	ROB	MCG	11/26/96	CONVERT TO AUTOCAD
REVISION NUMBER	DRAWN BY	CHECKED BY	APPR'D BY	DATE	REMARKS

PROFESSIONAL SEAL (IF REVISION, APPLIES ONLY TO REVISED WORK)

ISSUE (PROGRESS, ESTIMATE, BID, CONSTRUCTION, CONFORMED, REVISION, RECORD)

AS BUILT

F

5/8/2013

50B FIRE ALARM SYSTEM

FIRE ALARM LOGIC AND WIRING DIAGRAMS

UNIVERSITY OF CALIFORNIA
LAWRENCE BERKELEY NATIONAL LABORATORY
FACILITIES DIVISION

DRAWN BY	ROB	DATE 5/10/2085
CHECKED BY	RG	5/10/1985
APPROVED BY	BHS	5/10/1985
CAD FILE PATH		
SCALE	As Noted	
DRAWING NO.	4B50BE053F	SHEET
PROJECT NO.	FB4010	1 OF 1