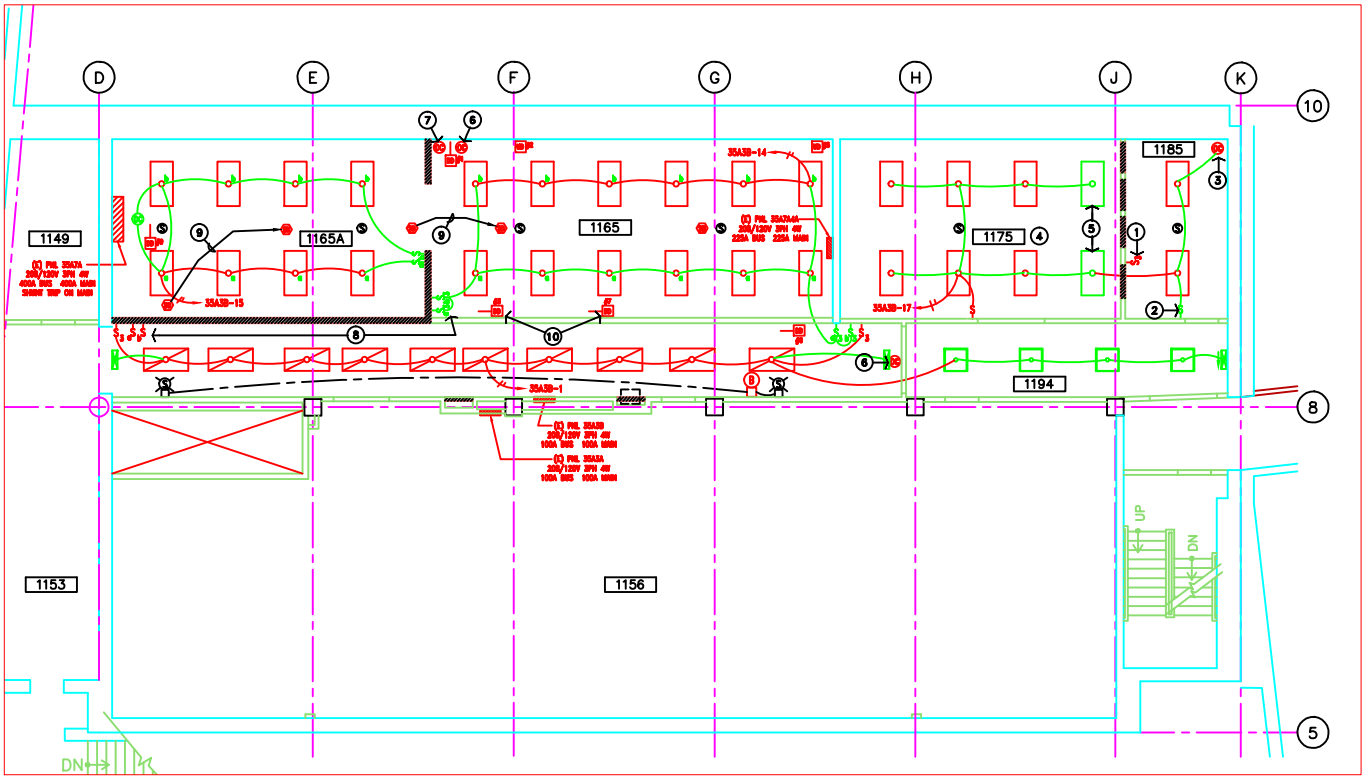

1 FIRST FLOOR CEILING PLAN – SOUTH

3/16" = 1'-0"

GENERAL NOTES :

1. SEE DWG. A6 FOR EXACT LOCATIONS OF CEILING ELEMENTS.
2. ALL NEW WIRING DEVICES AND COVER PLATES TO BE WHITE.
3. REPLACE ALL (E) WIRING DEVICES AND COVER PLATES WITH NEW, TO BE COLORED WHITE.

SHEET NOTES :

1. REMOVE 3-WAY LIGHT SWITCH.
2. REPLACE 3-WAY LIGHT SWITCH WITH SINGLE POLE SWITCH.
3. RELOCATE (E) OCCUPANCY SENSOR TO LOCATION SHOWN.
4. RELOCATE (E) FIXTURES IN RM 1175 AS SHOWN.
5. REPLACE (E) 2X2 FIXTURES (3 EA.) WITH (N) 2X4 FIXTURES AS SHOWN.
6. REMOVE (E) OCCUPANCY SENSOR.
7. RELOCATE (E) OCCUPANCY SENSOR TO RM 1165A AS SHOWN.
8. RELOCATE RM 1165 LIGHT SWITCHES TO NEW LOCATION SHOWN.
9. RELOCATE (E) SMOKE DETECTORS IN RMS 1165 & 1165A AS SHOWN.
10. REMOVE (E) DUCT SMOKE DETECTORS.

SYMBOLS :

- (E) 2X4 SURFACE MTD. FLUORESCENT FIXTURE
- (E) 2X4 LAY-IN TROFFER FLUORESCENT FIXTURE
- (N) 2X4 LAY-IN TROFFER FLUORESCENT FIXTURE (TO MATCH EXISTING)
- (N) 2X2 SURFACE MOUNTING FLUORESCENT FIXTURE, 2-32WT8 LAMPS, PARABOLIC GRID, ELECTRONIC BALLAST.
- (N) EXIT SIGN, GREEN LED LAMPS, WHITE HOUSING, SINGLE FACE, SURFACE MTG., 120/277V WITH EMERG. BATTERY POWER PACK, FIRE ALARM FLASHING INTERFACE, EXIT SIGN DIRECTION INDICATED BY ARROW. EXIST SIGNS TO BE CONNECTED UPSTREAM OF LIGHTING SWITCHES AND OCCUPANCY SENSOR CONTROLS.
- (E) LIGHT SWITCH; '3' = 3-WAY; 'X' DENOTES FIXTURES SWITCHED
- (N) LIGHT SWITCH; '3' = 3-WAY; 'X' DENOTES FIXTURES SWITCHED
- (E) OCCUPANCY SENSOR
- RELOCATED (E) OCCUPANCY SENSOR
- (N) PA SPEAKER
- (E) CEILING SMOKE DETECTOR
- (E) DUCT SMOKE DETECTOR
- (E) UNDER FLOOR SMOKE DETECTOR
- (E) FIRE ALARM BELL
- (N) FIRE ALARM STROBE LIGHT, AT +84"
- (N) FIRE ALARM SYSTEM CONDUIT, 3/4"C., U.O.N.

REVISION NUMBER	DRAWN BY	CHECKED BY	APPVD BY	DATE	REMARKS
C	LDD	LDD	MCG	9.30.96	AS BUILT
B	LDD	LDD		9.16.96	ADDED EXIT SIGNS TO 1165, 1194
A	LDD	LDD	MG	6.20.96	LIGHTING MODS TO 1194

50B NERSC MODIFICATIONS
RMS 1165/1175/1185
LIGHTING & FIRE ALARM PLAN

UNIVERSITY OF CALIFORNIA LAWRENCE BERKELEY LABORATORY
FACILITIES DEPARTMENT

DRAWN BY	LDD	DATE 04/11/96
CHECKED BY	LDD	04/11/96
APPROVED BY	MCG	04/15/96
CAD FILE PATH	00001014	
SCALE	As Noted	
DRAWING NO.	4B50BE156A	SHEET E45 OF
PROJECT NO.	120977	