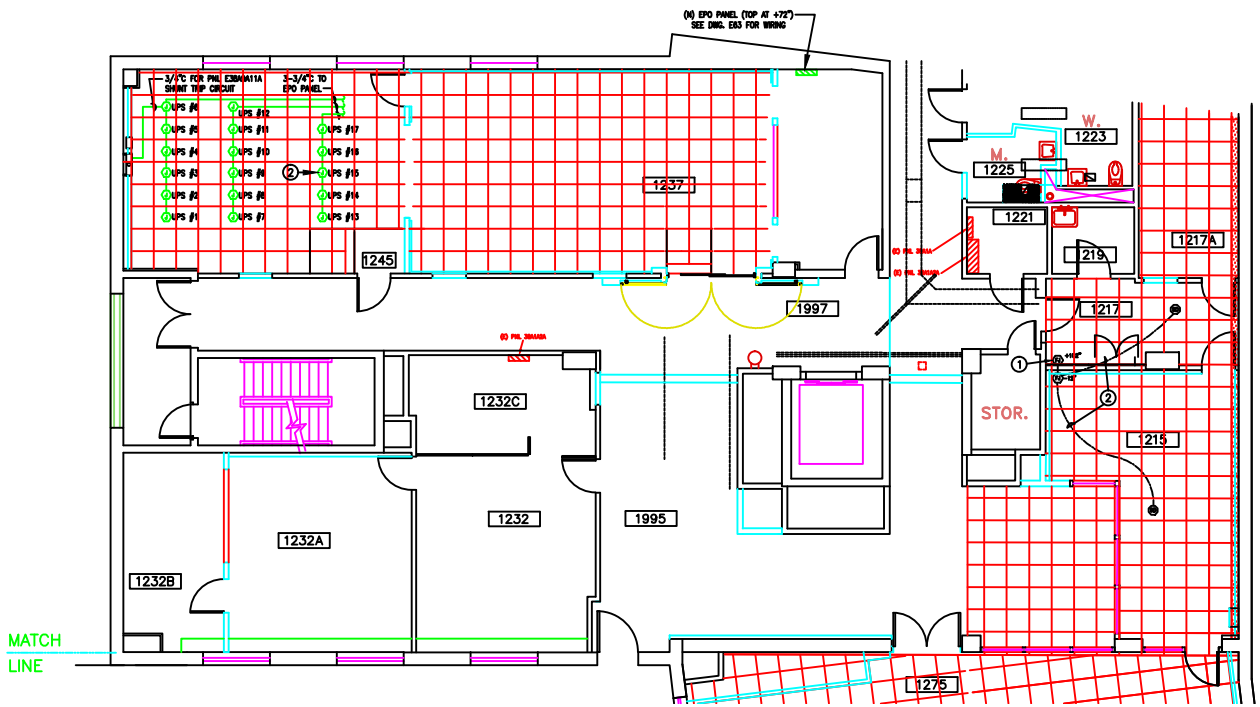

GENERAL NOTES :

1. FILL ALL THRU-PENETRATIONS IN RATED CONSTRUCTION W/ U.L. APPROVED FIRE SEALANT / ASSEMBLY - BY UNIVERSITY.

SHEET NOTES

1. J-BOX FOR CEILING SMOKE DETECTORS, SEE DWG. E53. SUBFLOOR SMOKE DETECTORS TO BE ON SAME ZONE WITH CEILING SMOKE DETECTORS.
2. INSTALL RACEWAYS & WIRING FOR EPO SYSTEM, SEE DWG. E63. MOUNT J-BOX NEAR (E) RECEPT.

SYMBOLS

- (N) SUBFLOOR SMOKE DETECTOR
- (N) FIRE ALARM J-BOX, HEIGHT AS NOTED, SIZED TO SUIT.
- (N) EPO UNDERFLOOR J-BOX
- (E) FIRE ALARM CKT. CONDUIT
- (N) FIRE ALARM CKT. CONDUIT
- (N) EPO SYSEM CKT. CONDUIT

REVISION NUMBER	DRAWN BY	CHECKED BY	APPROVED BY	DATE	REMARKS
C	LDD	LDD	MCG	9.19.96	AS BUILT
B	LDD	LDD	ROB	8.5.96	LABELED EPO J-BOXES
A	LDD	LDD	MG	7.19.96	EPO MODS IN RMS 1237A & 1245

50B NERSC MODIFICATIONS
1st FLR ESNet/SUPPORT SPACES
SUBFLOOR FIRE ALARM PLAN

UNIVERSITY OF CALIFORNIA LAWRENCE BERKELEY LABORATORY
FACILITIES DEPARTMENT

DRAWN BY	LDD	DATE 03/19/96
CHECKED BY	LDD	03/19/96
APPROVED BY	MCG	03/19/96
CAD FILE PATH	00001023	
SCALE	As Noted	
DRAWING NO.	4B50BE165C	SHEET E54
PROJECT NO.	120977	1 OF 1